
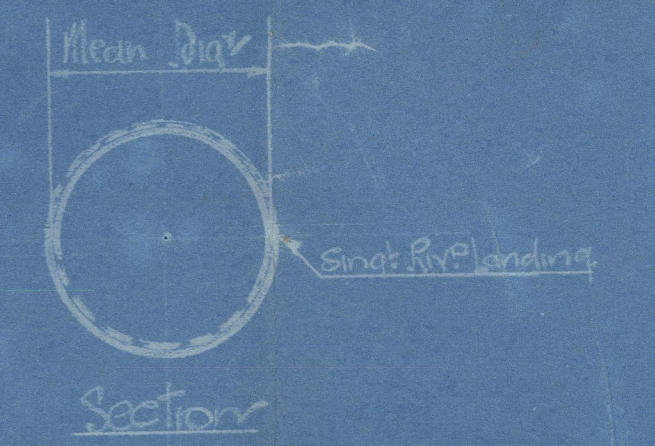
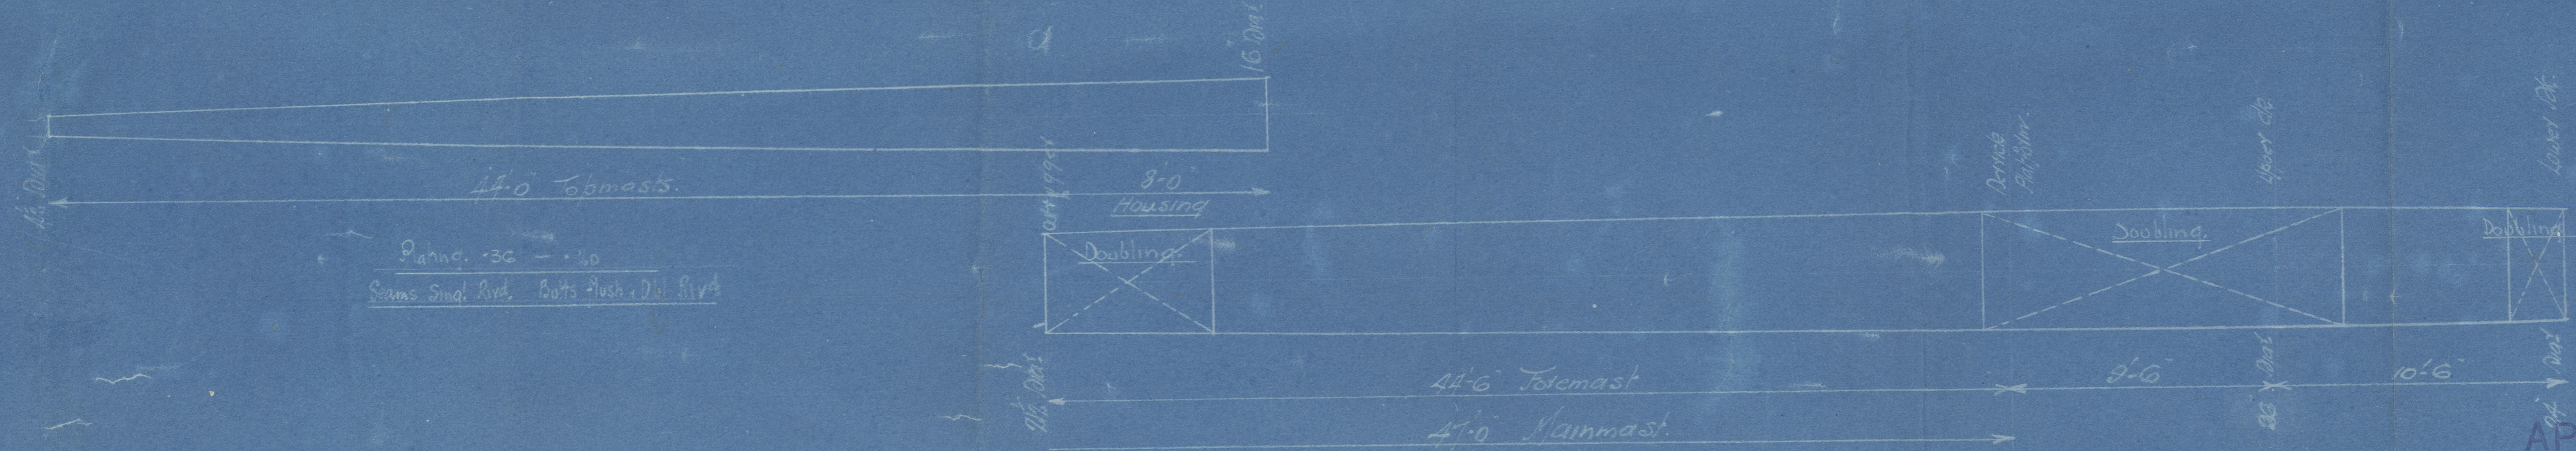
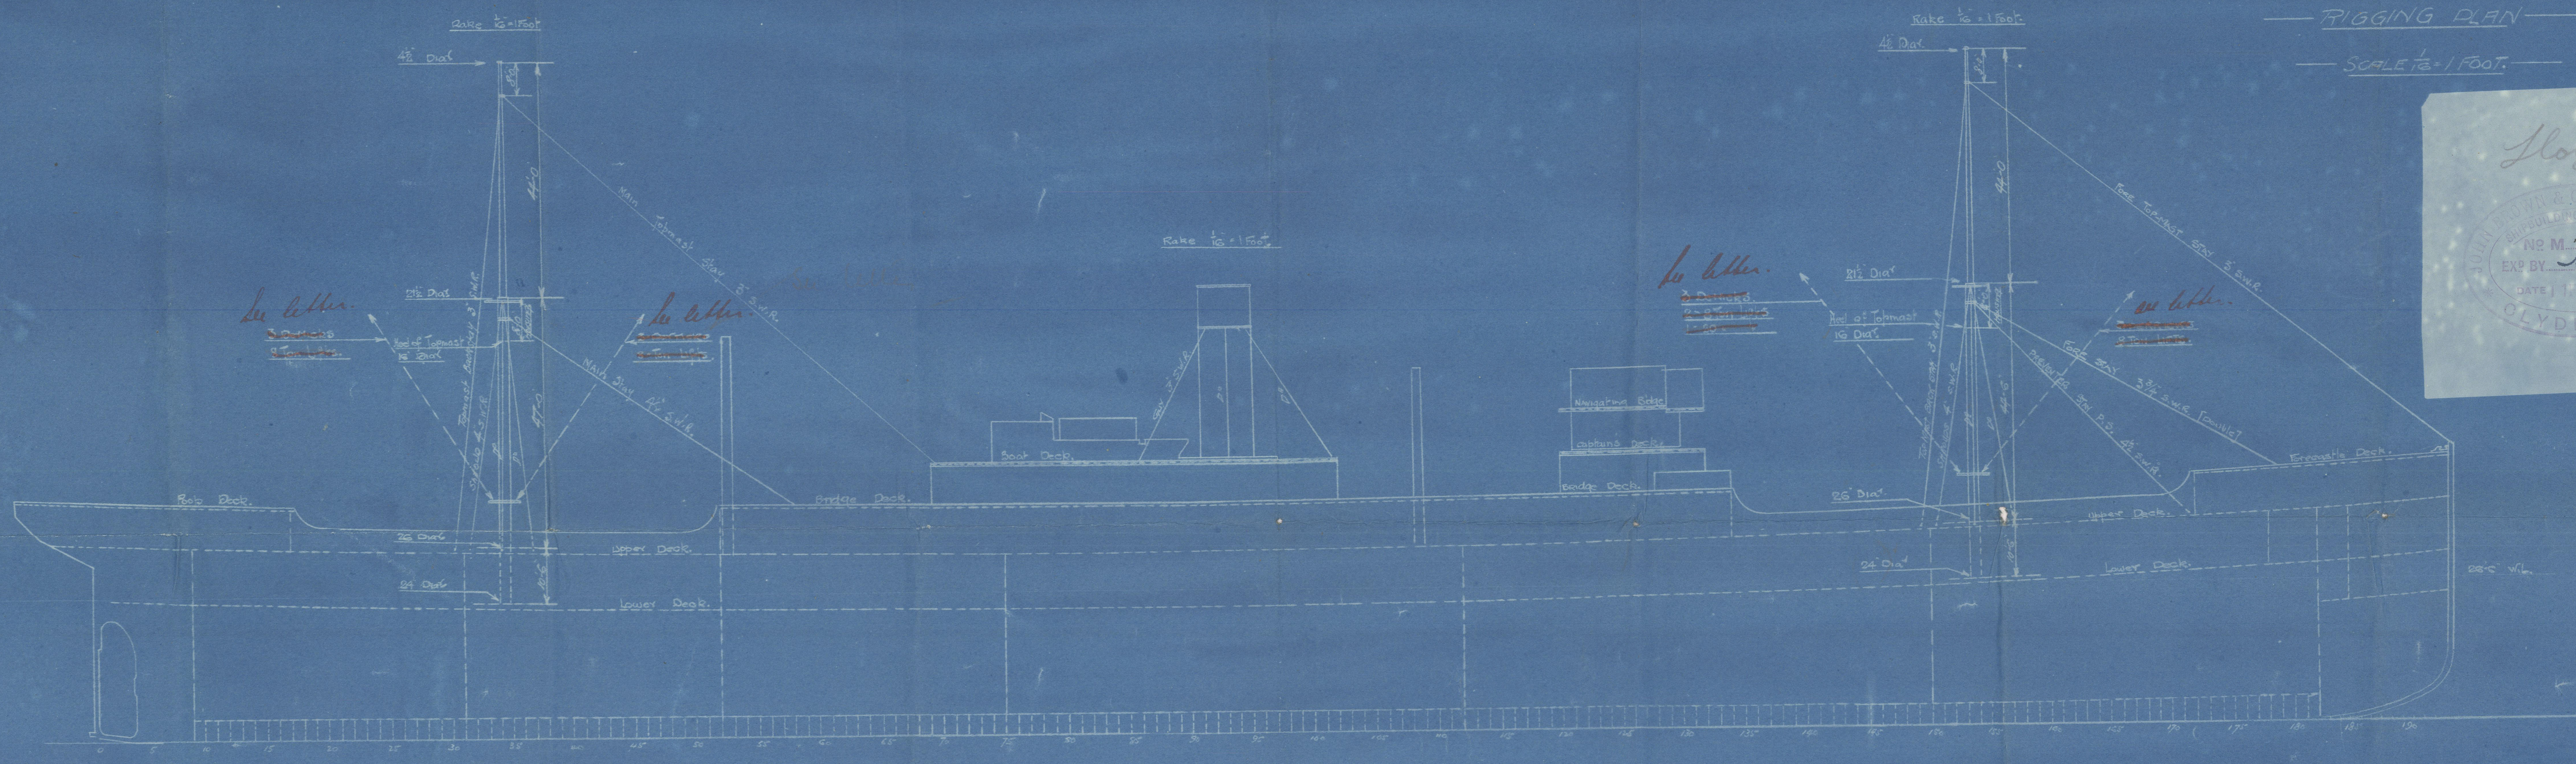


No 596-7-8-9°

RIGGING PLAN

SCALE 1/2" = 1 FOOT.

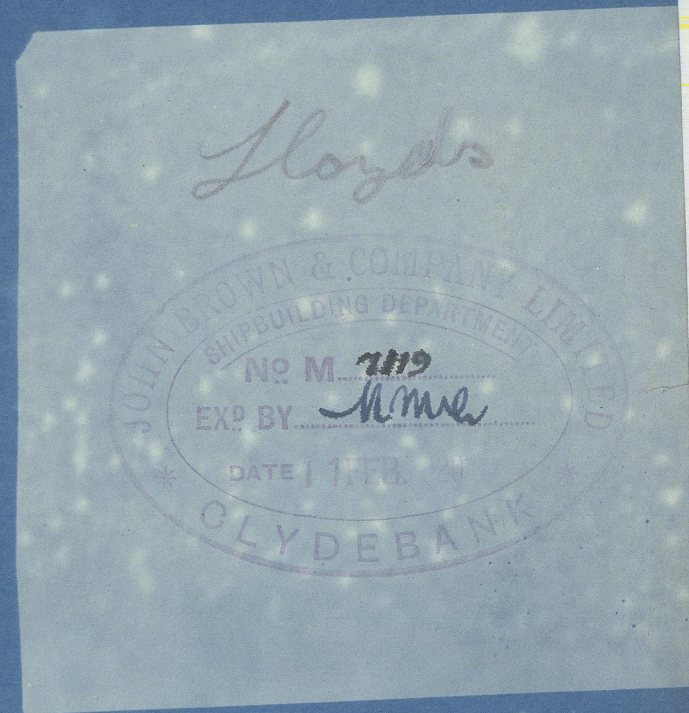

Plating 40 partners }
36 Heel + Hounds }
Seams Singl Rivd }
Boots Treble Rivd. Div Under Partners }
2 plates in round.

APPROVED
LLOYD'S REGISTER OF SHIPPING

Montgomery
DATE 17.2.90

Rigging Plan

595 596. 7. 8 890.

John. Brown B.L.S.

 S. Calgary 
GLASGOW REPORT No. 40871

597 "Lochrane"

GLASGOW REPORT No. 42555

598 "Calumet"

GLASGOW REPORT No. 42556

599 "Cariboo"

GLASGOW REPORT No. 43893

003006 - 003012 - 0230



© 2021

Lloyd's Register
Foundation