


No. 1062 & 1/40.

MAIN DECK.



SCALE 1/4" = 1 FOOT.

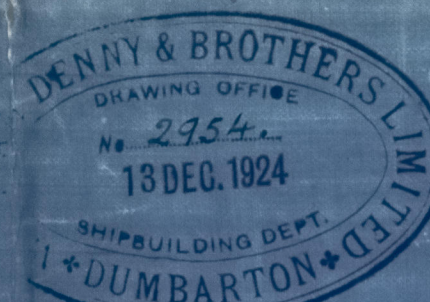



11 DEC 1924

Approved *[Signature]*  
See letter


SECTION THRO VENT FOR OF FR. 55.

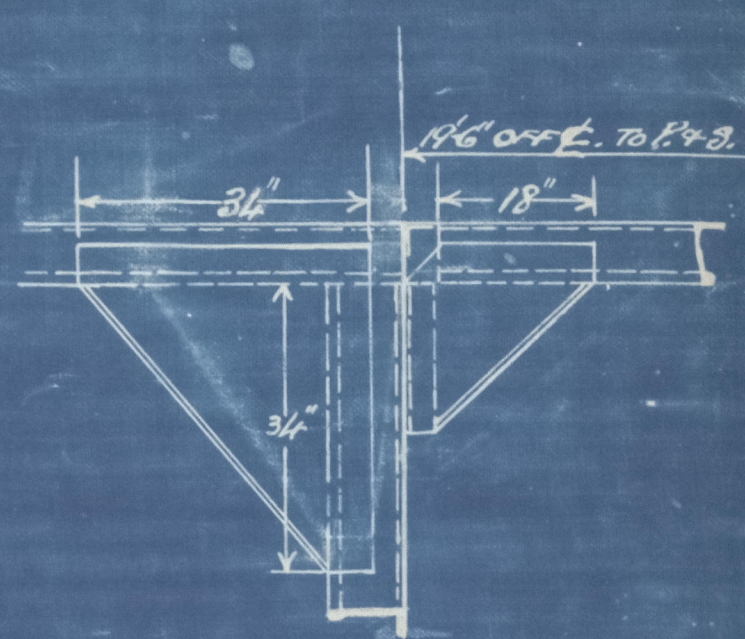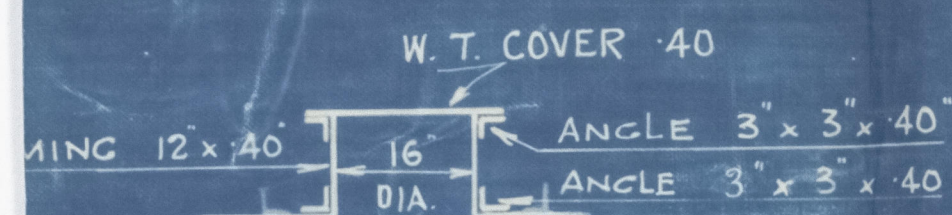

SECTION THRO VENT FOR OF 88.



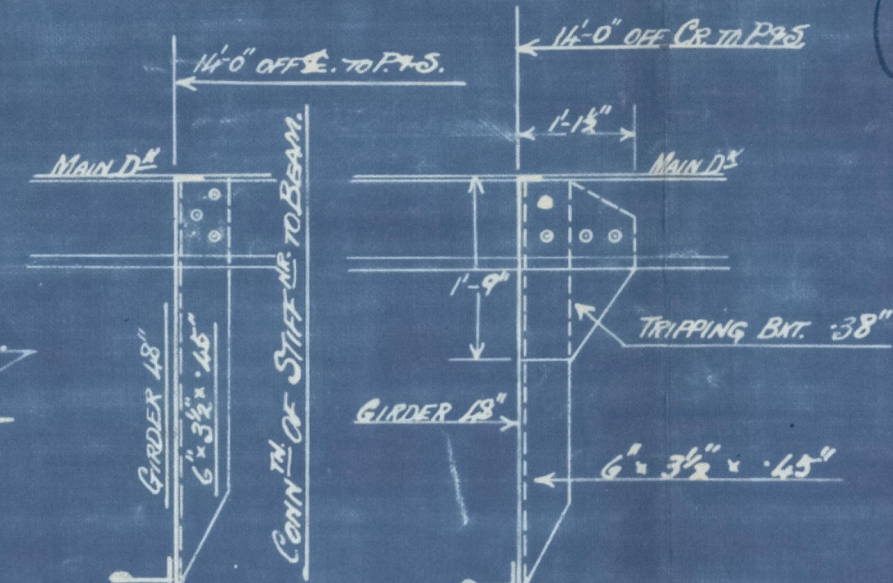
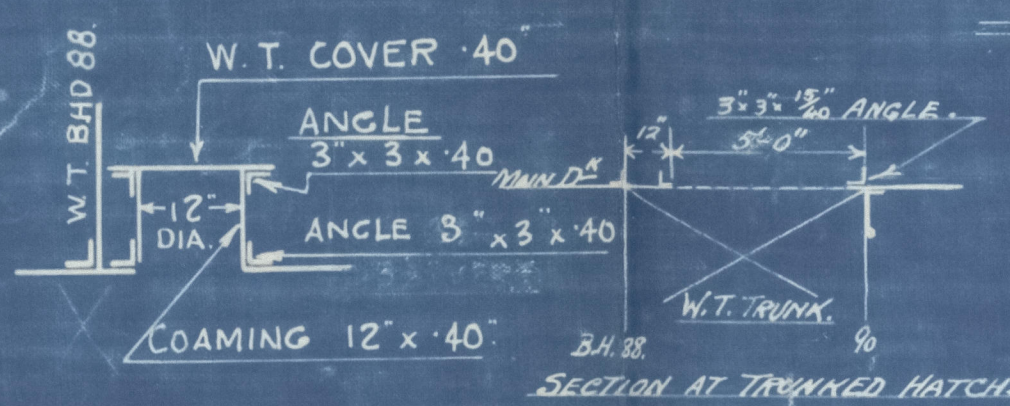


SKETCH OF KNEES ON F&A END. FRG. 1/4 TO 88.

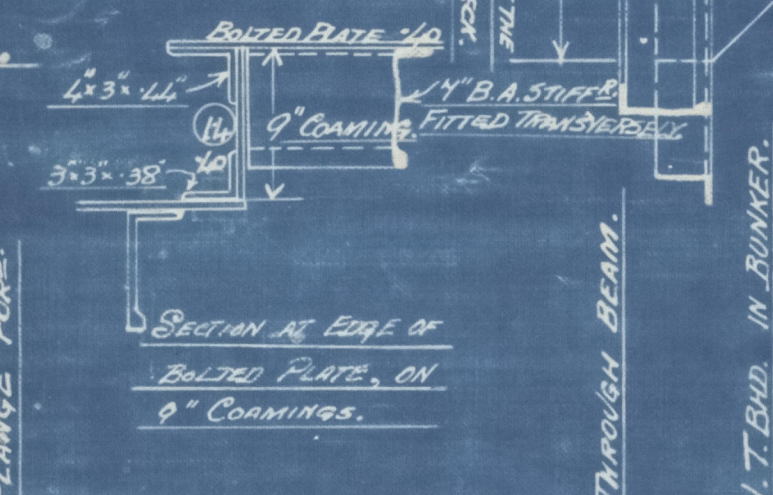

W.T. FLAT. FRAMES CUT AND BRACKETED BETWEEN NOS 1/4 AND 100.  
BRACKETS 30" x 30" x 1/2".

SKETCH OF TRIPPING BATS AT  
NOS 91, 93, 95, & 97.

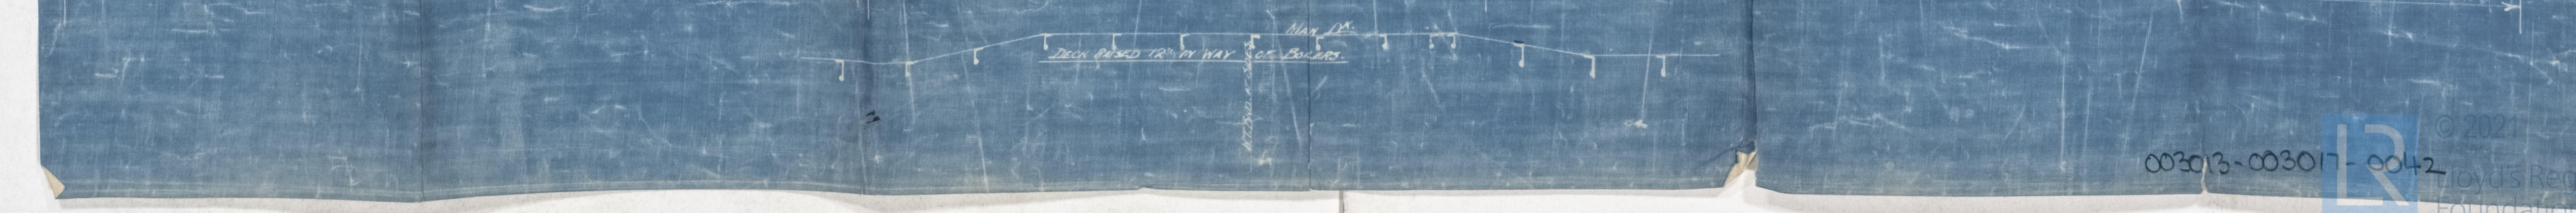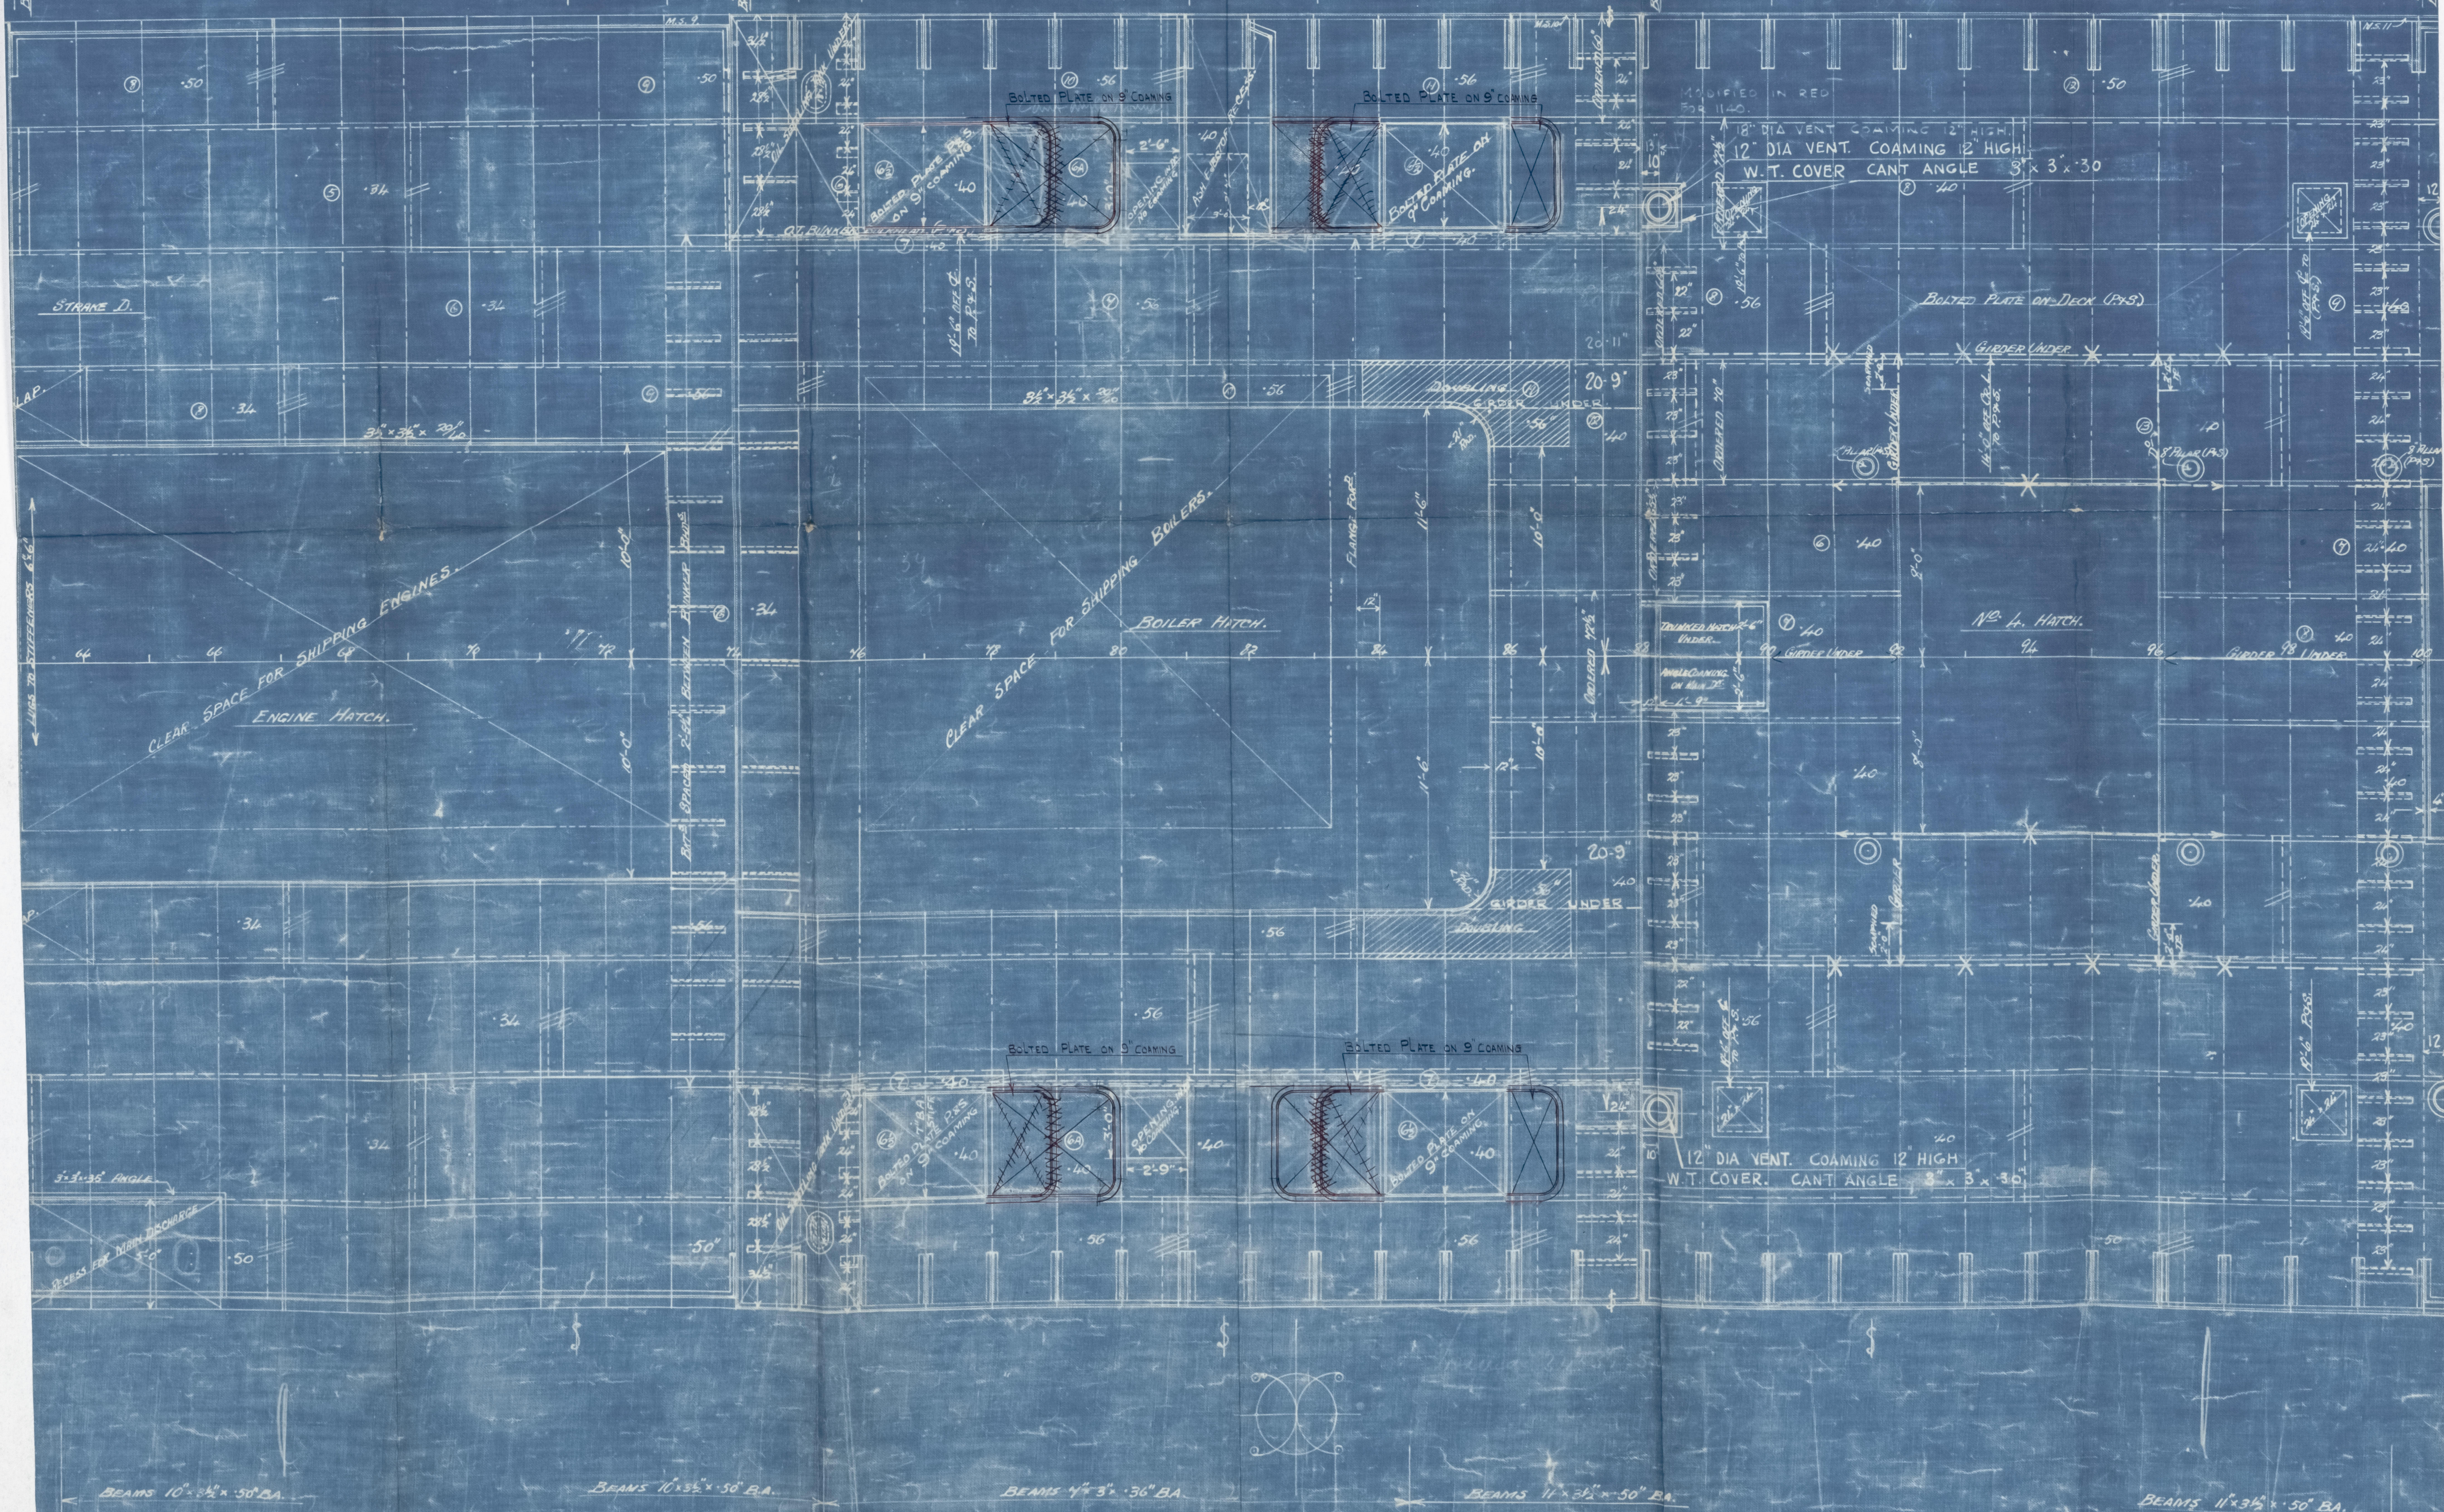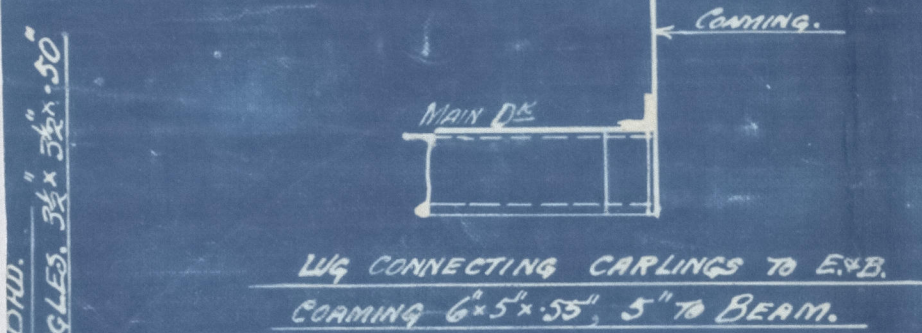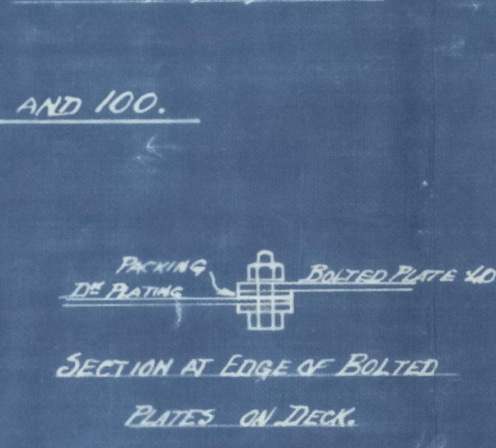



Denny Bros

1062+1140

Main Deck

AMARAPU<sup>RA</sup> PEGU

Main Deck

32

003013-003017-0042



© 2021

Lloyd's Register  
Foundation