

184 W. ad. examined W  
 number 2, 2, 6  
 1105 D. W. R. ad.



19.3.04

## SHAFT BRACKETS.

~~SCALE~~  $1\frac{1}{2}$  INCH = 1 FOOT.

SHAFT BRACKETS TO BE MADE OF WROUGHT IRON.

SIDE ELEVATION.

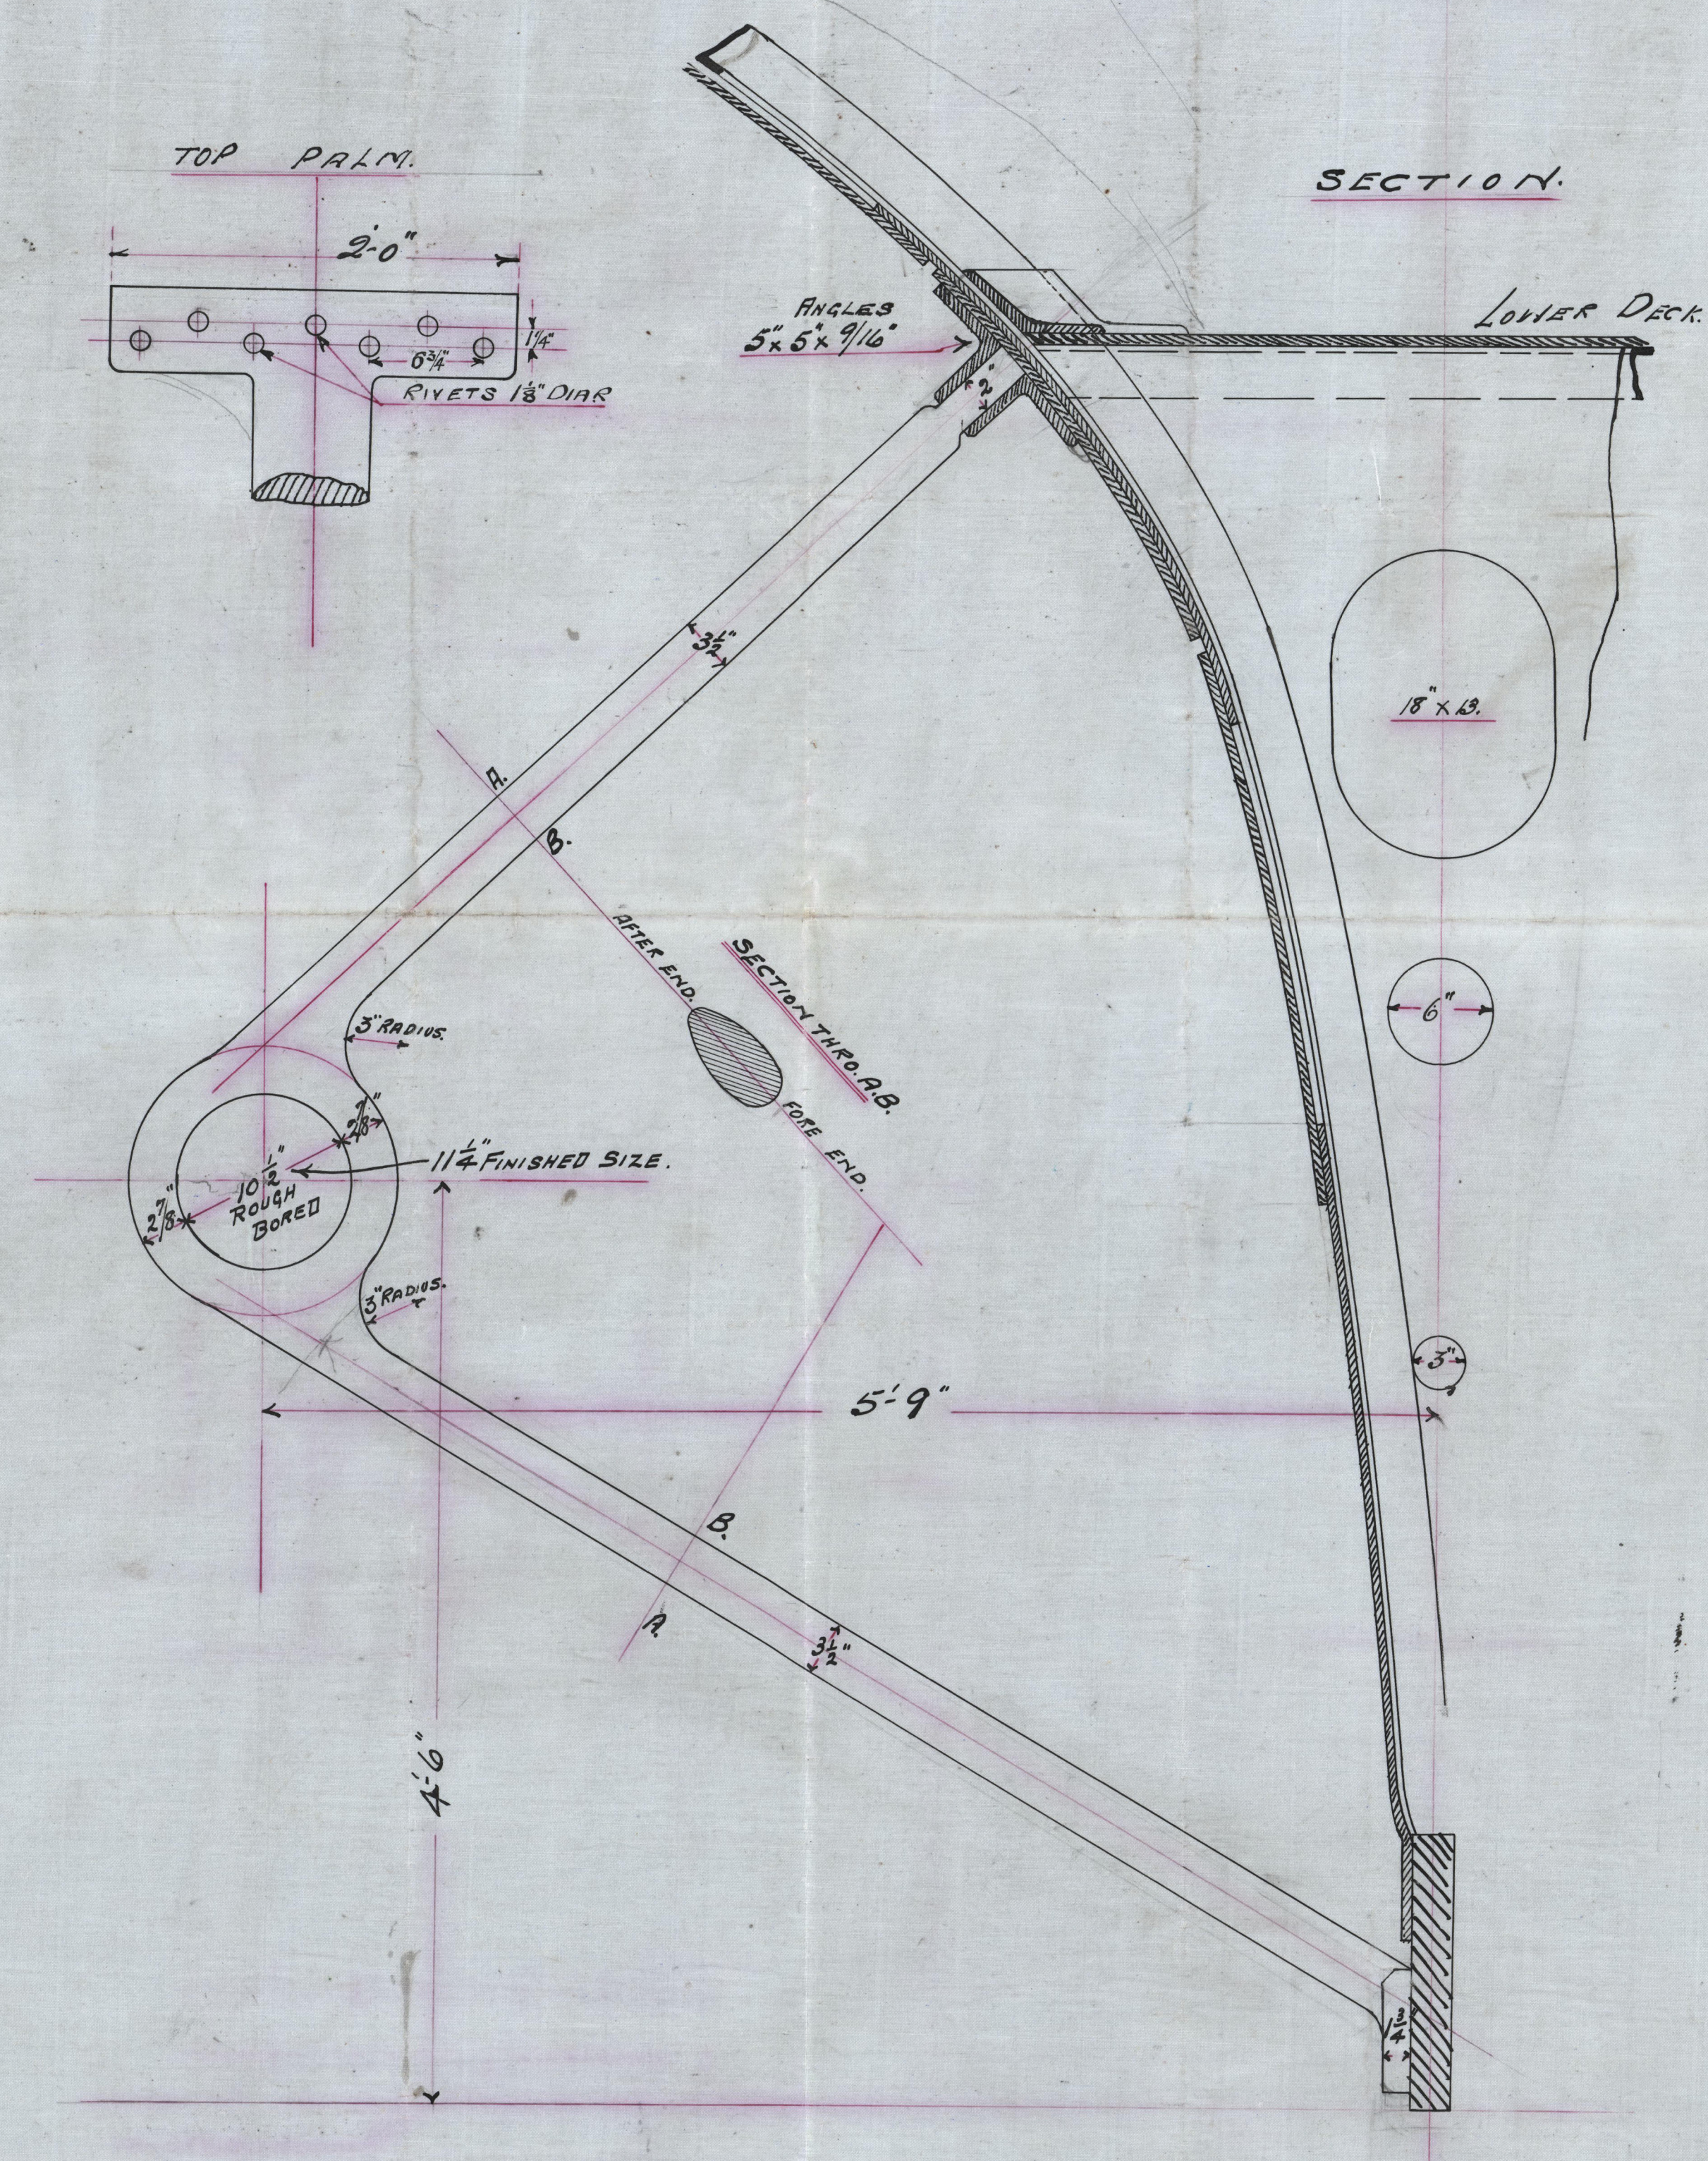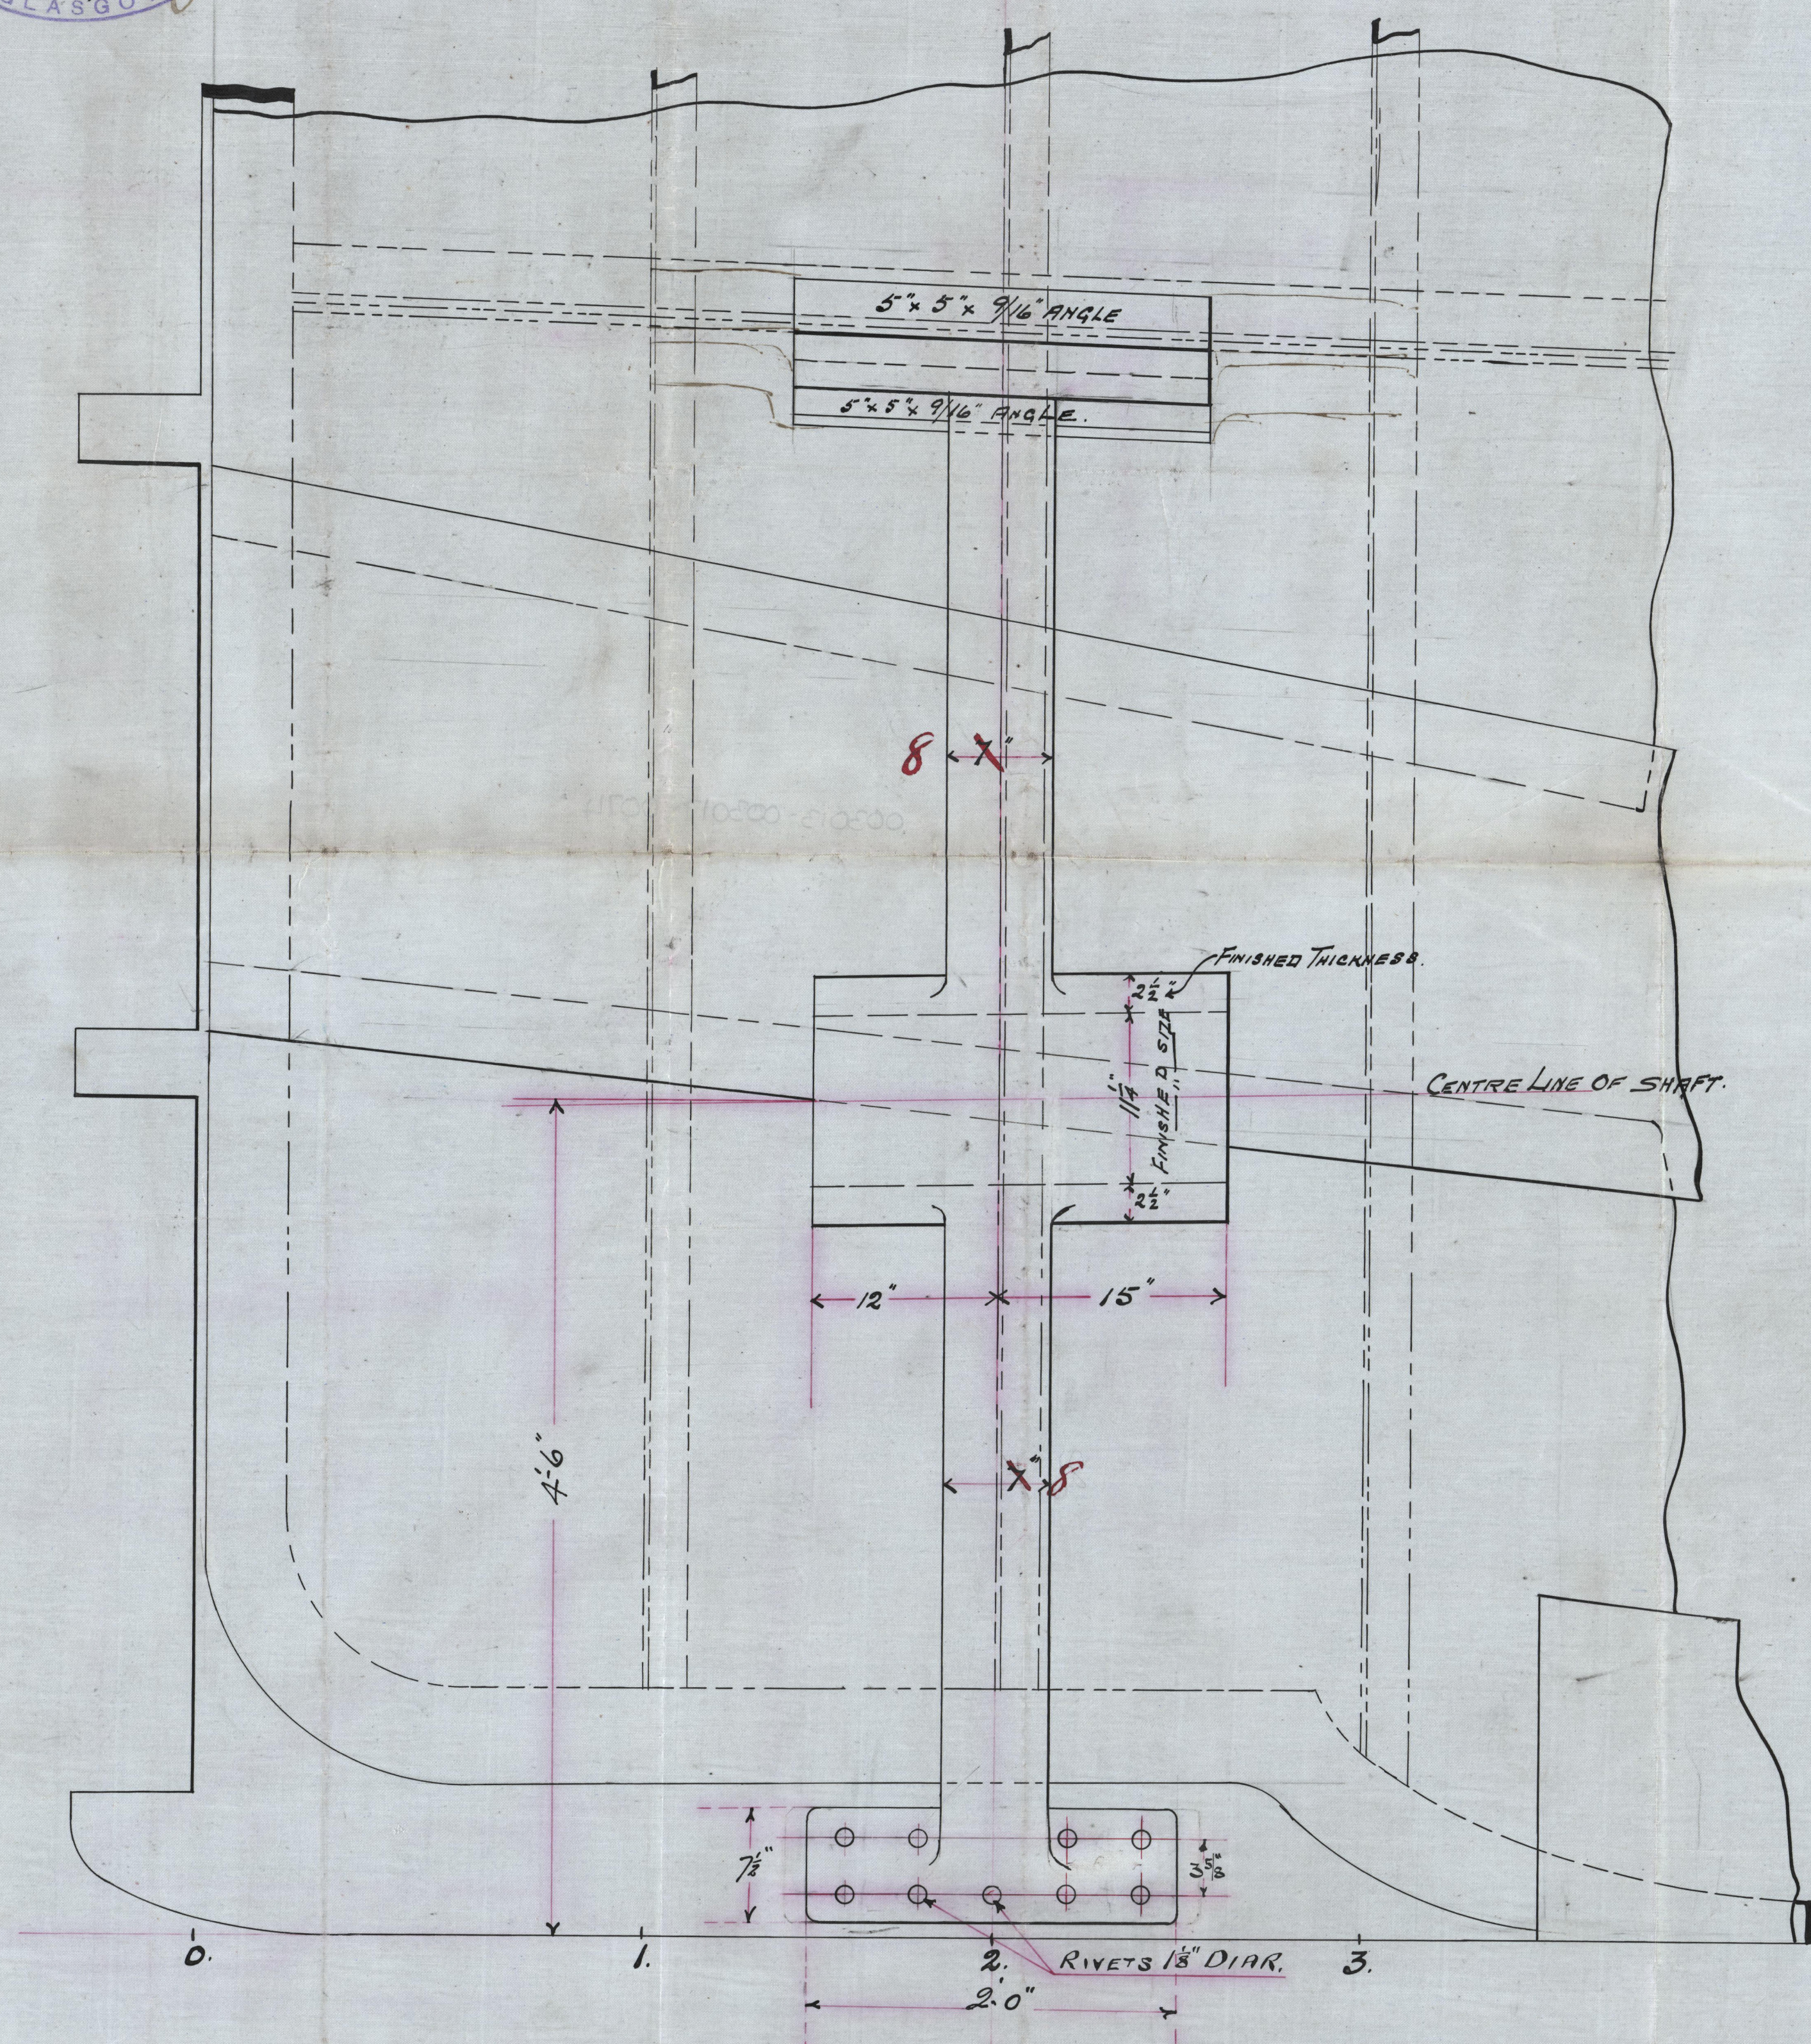

C.B.  
19.3.04





Shaft Brackets

Wm Beardmore & Co No 481

J. S. S. Dalmain

Gls. No 22016

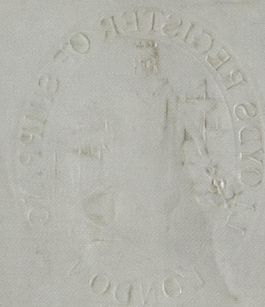
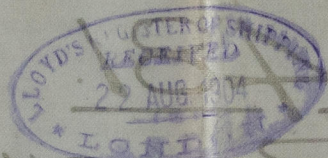


T. S. S. No 22016  
SHAFT BRACKETS

SCALE 1/2" = 1 FOOT

SHAFT BRACKETS TO BE MADE OF WROUGHT IRON

SECTIONAL ELEVATION

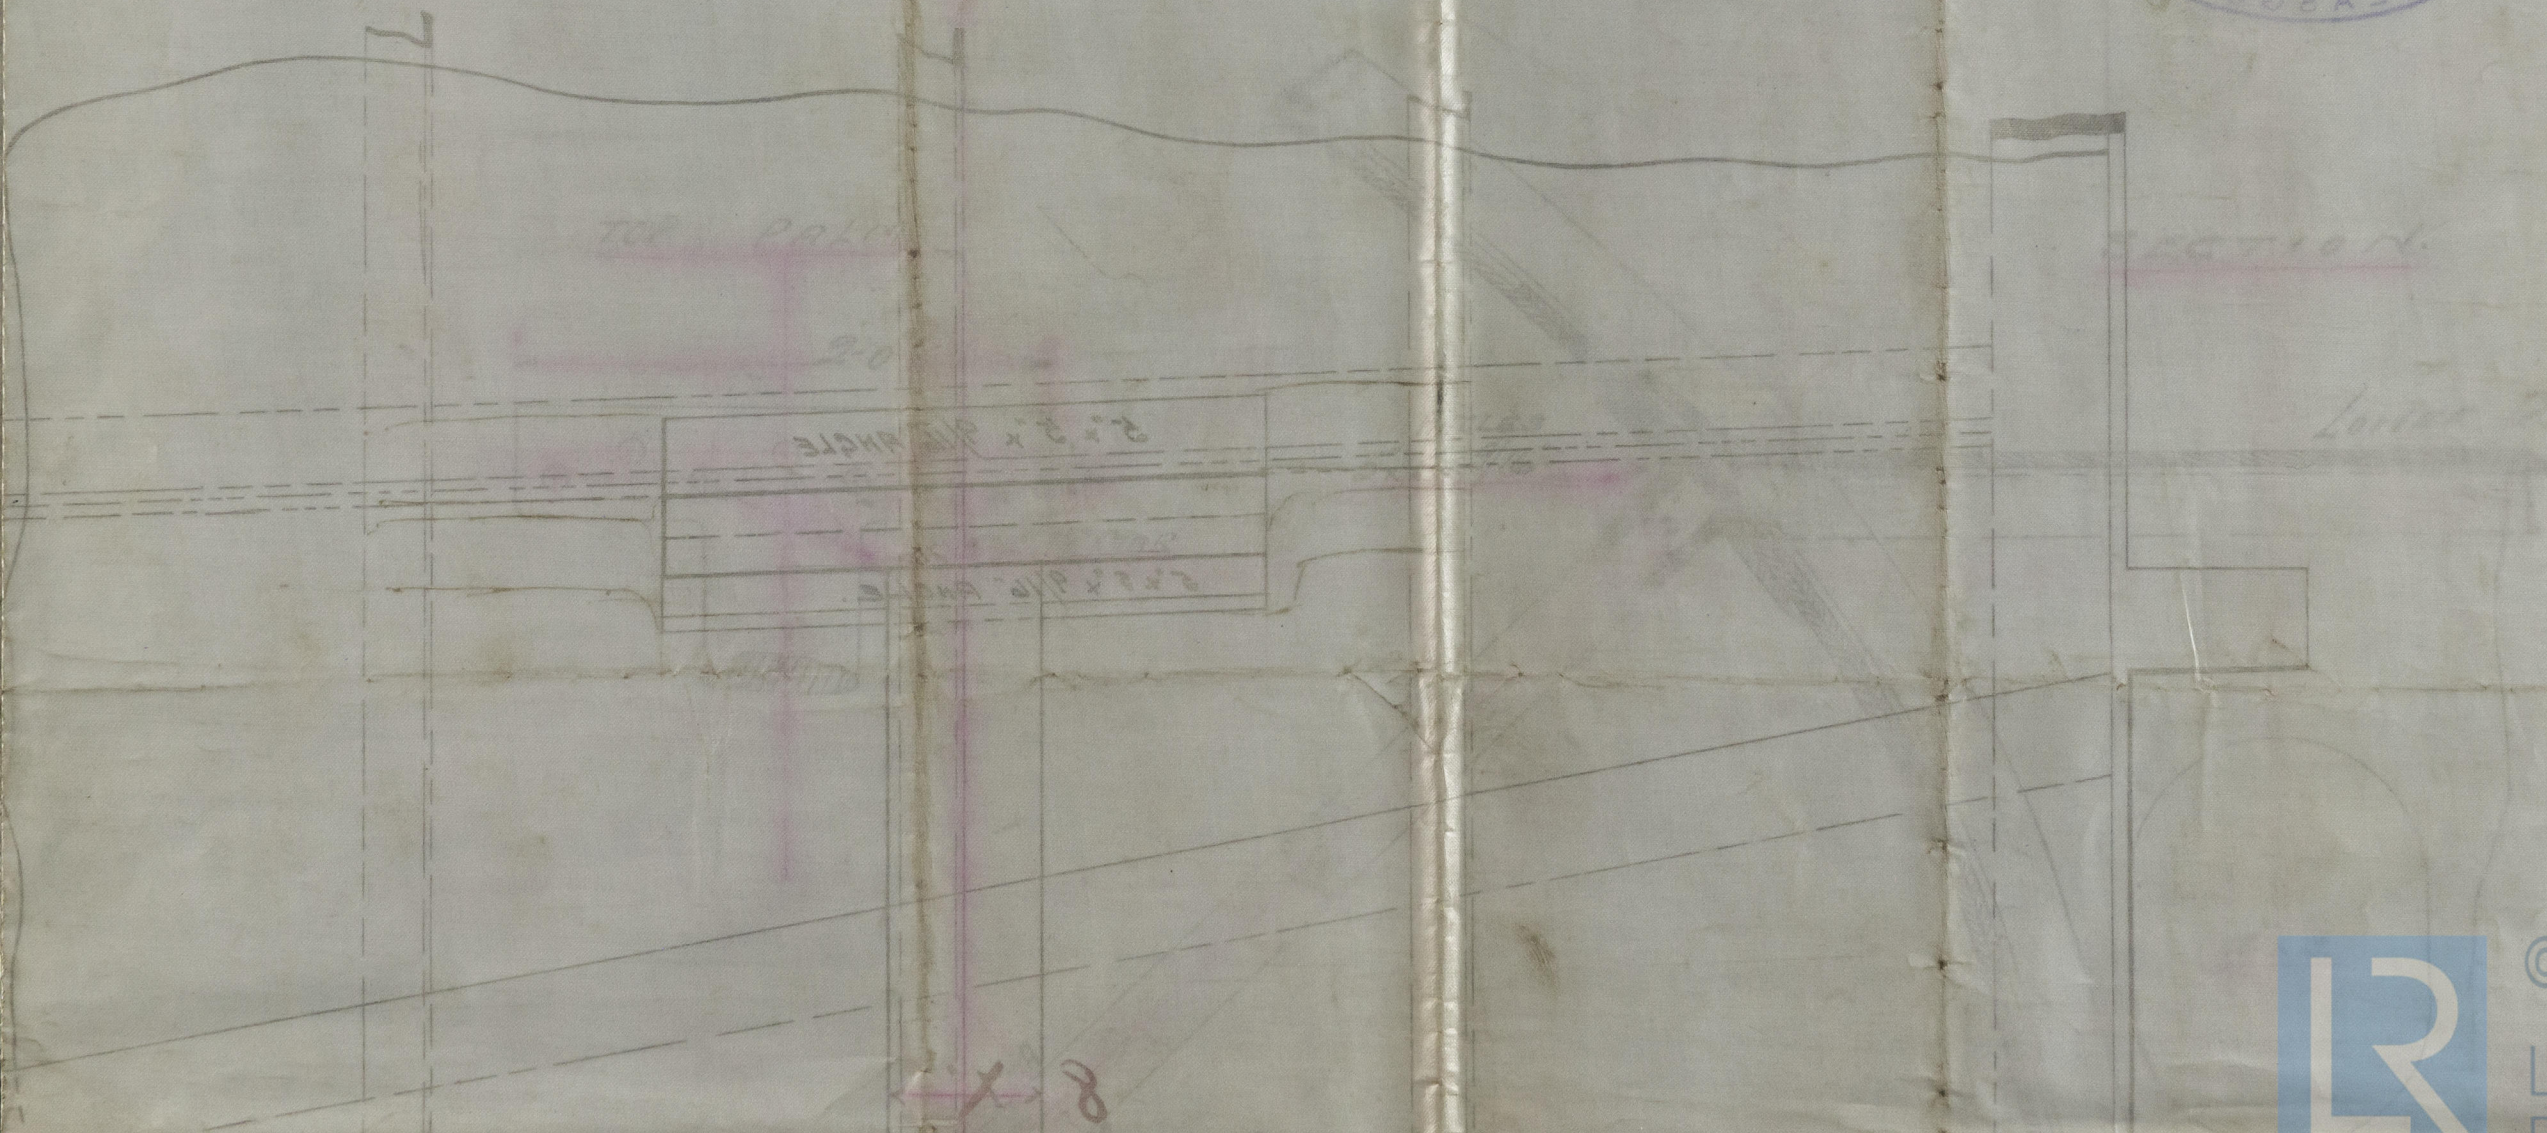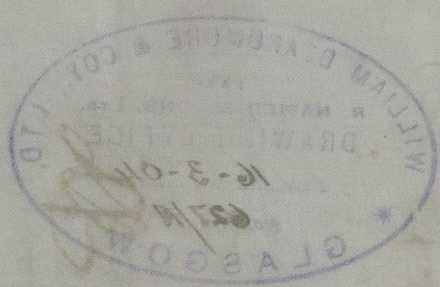

003013-003017-0074



© 2021  
Lloyd's Register  
Foundation