


TO BE ATTACHED TO DURBAN RPTN<sup>o</sup> 6843

MOTOR TANKER "ANGLO MAERSK"

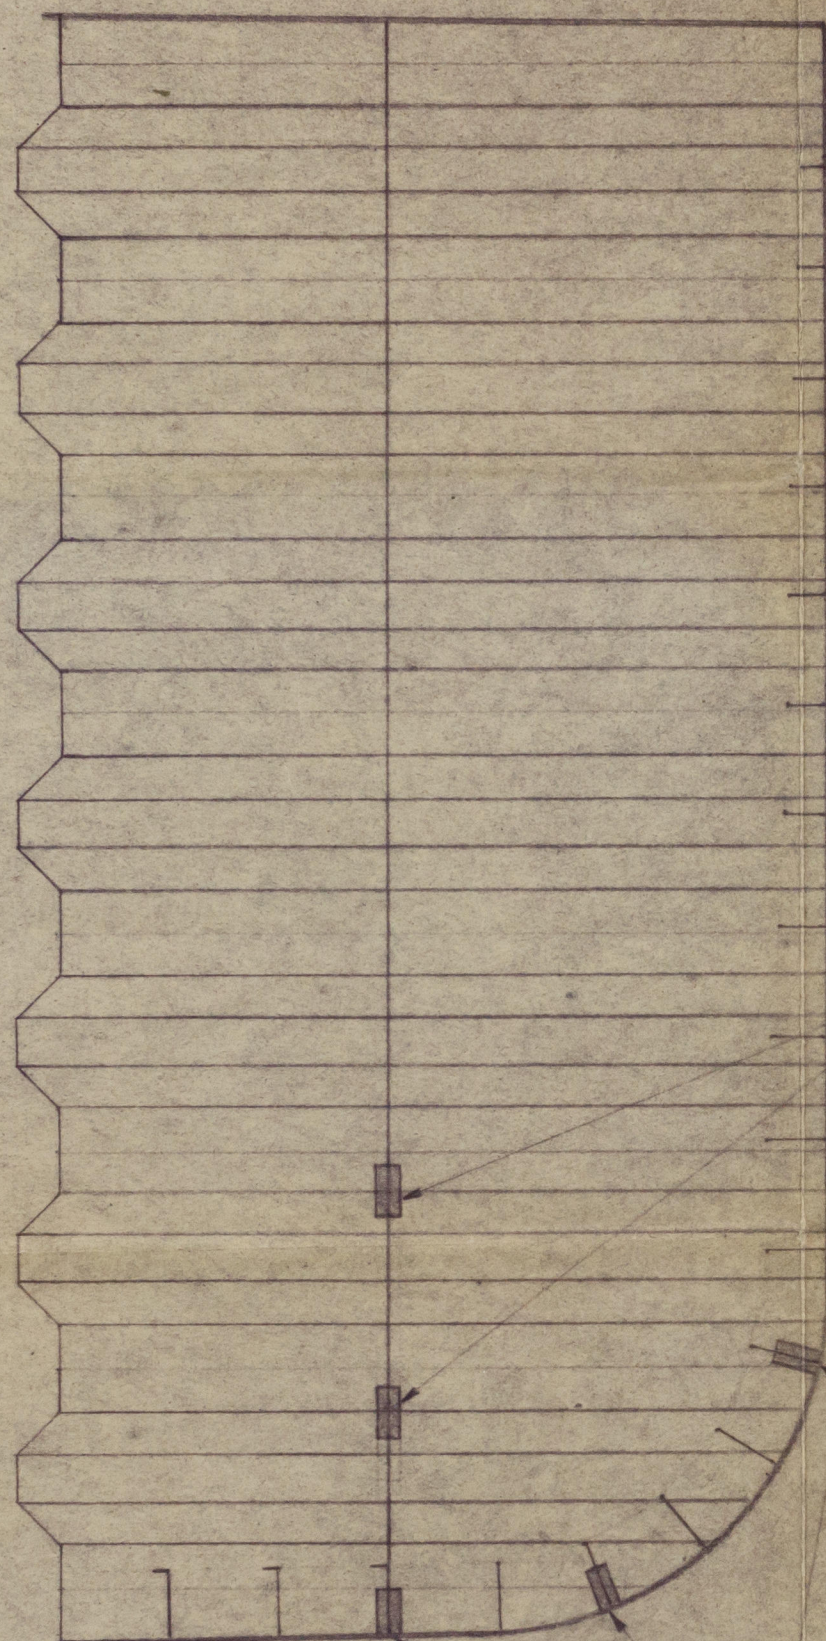

VERTICAL WEB CROPPED & CRANKED 15" x 6"  
DOUBLERS INSERTED. DOUBLERS WELDED  
ALL ROUND.

LONGITUDINALS CROPPED,  
DOUBLERS 12" x 6" INSERTED  
AND WELDED ALL ROUND

DATE BY		JAMES BROWN, LTD.	
DRAWN	2.8.55 JS.	MARINE AND GENERAL ENGINEERS	
TRACED		POINT, DURBAN, NATAL, S AFRICA	
CHECKED		MT. "ANGLO MAERSK"	
CH. DRAUGH.		REPAIRS TO BULKHEAD BETWEEN	
TECH. ENGR.		N° 5 STBD WING & COFFERDAM.	
MADE FROM:		Dwg No. A5918	



"

Anglo Maersk":

Repairs to bulkhead  
between No. 5. stbd wing +  
cofferdam.

Dur. rept No. 6843.



© 2020

Lloyd's Register  
Foundation

063018-003022-0018