

Lloyd's Register of Shipping.


Ship's Name "JEHANGIR" Official No. 147640

Memorandum of alterations reported since ship was surveyed for assignment of Load Lines in

BOMBAY.

NOW DONE (December 1953)

Alterations to existing ventilators and additional ventilators were now made as per sketch -

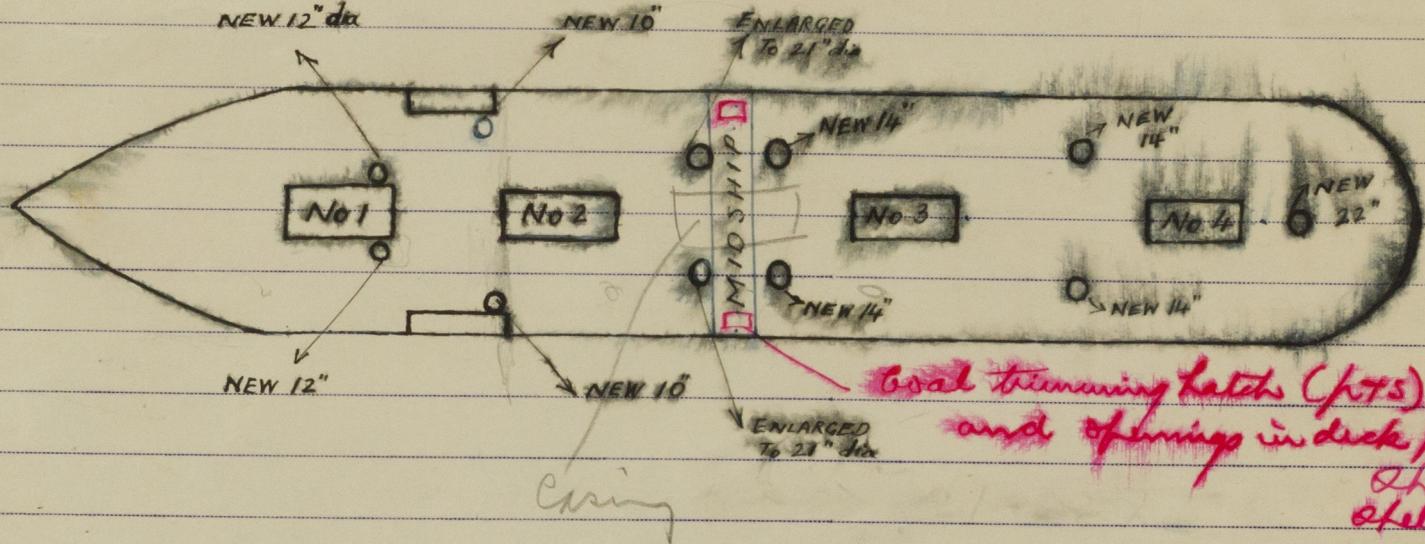

All these ventilator coamings are to Rule requirements and the plugs and covers are new and in good order. All these ventilators are on the shelter deck and are for additional ventilation to the shelter deck space above the freeboard deck. The coal trimming hatches on the shelter deck, midships, have been removed, one port one starboard, and the openings in the deck plated over and sheathed.

*compensation fitted in way of new vents
(See Rpt 8 No. 11346)*

Shreyth

15

11 MAY 1955