


12 JUN 1947

RECORDS DEPT.  
LONDON

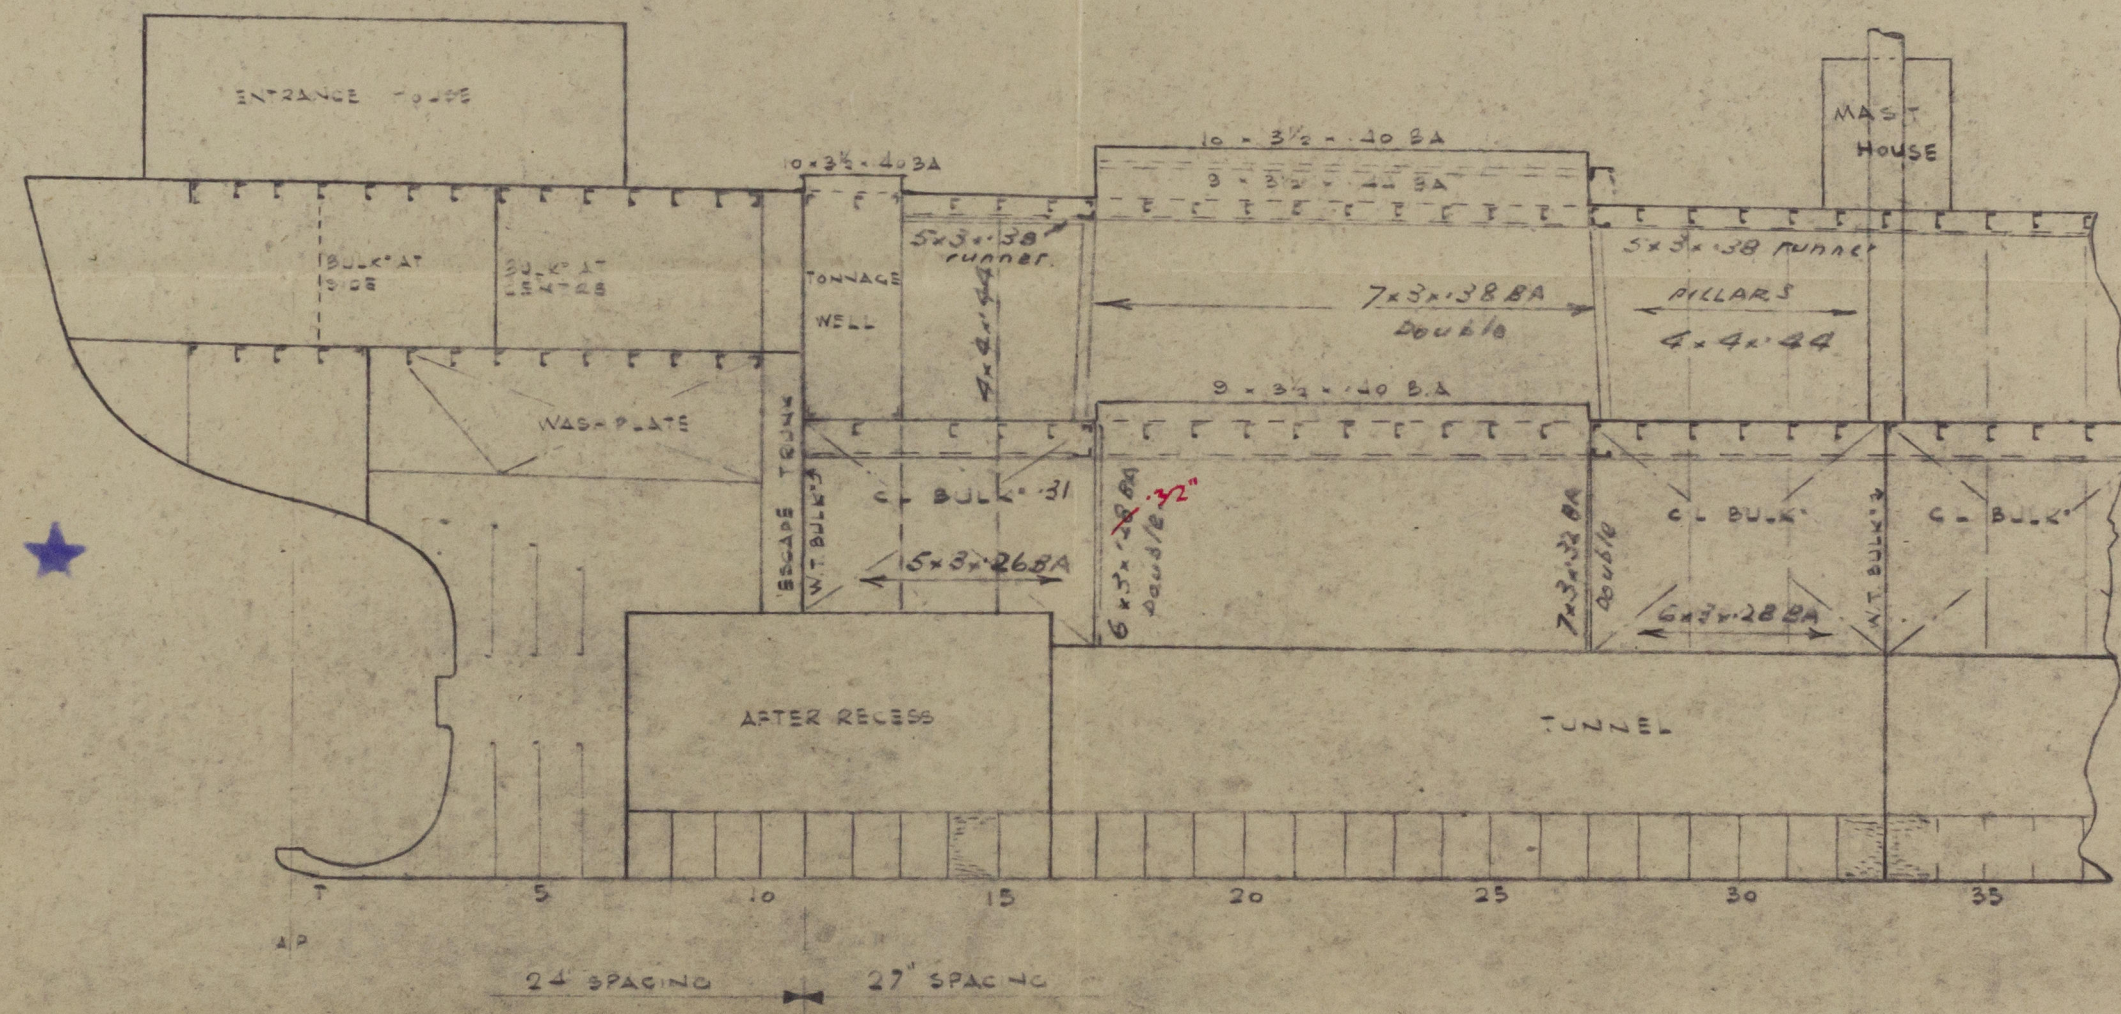

PART PLAN OF PROFILE.

No. 309.

scale 1/8" = 1 foot

AM  
12.6.47

W. PICKERSGILL & SONS LIMITED  
MAY 1947  
1518  
SHIPBUILDERS  
SUNDERLAND

© 2020  
Lloyd's Register  
Foundation

003018-003022-0077



Wm. Pickersgill & Sons.

Yard No. 309, 310. 311

Part Plan of Profile.

"Nefertiti"

SUNDERLAND RPT NO 34895

"Henzee"


SUNDERLAND RPT NO 34961

Admiral Fraser



SUNDERLAND RPT NO 34997

RECORDS DEPT..  
LONDON

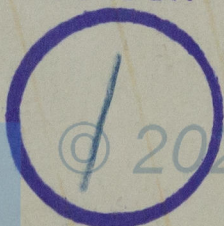

© 2020

Lloyd's Register  
Foundation

003018-003022-0077