


29. 10. 04

Note. Approved thicknesses in black
Actual thicknesses in red

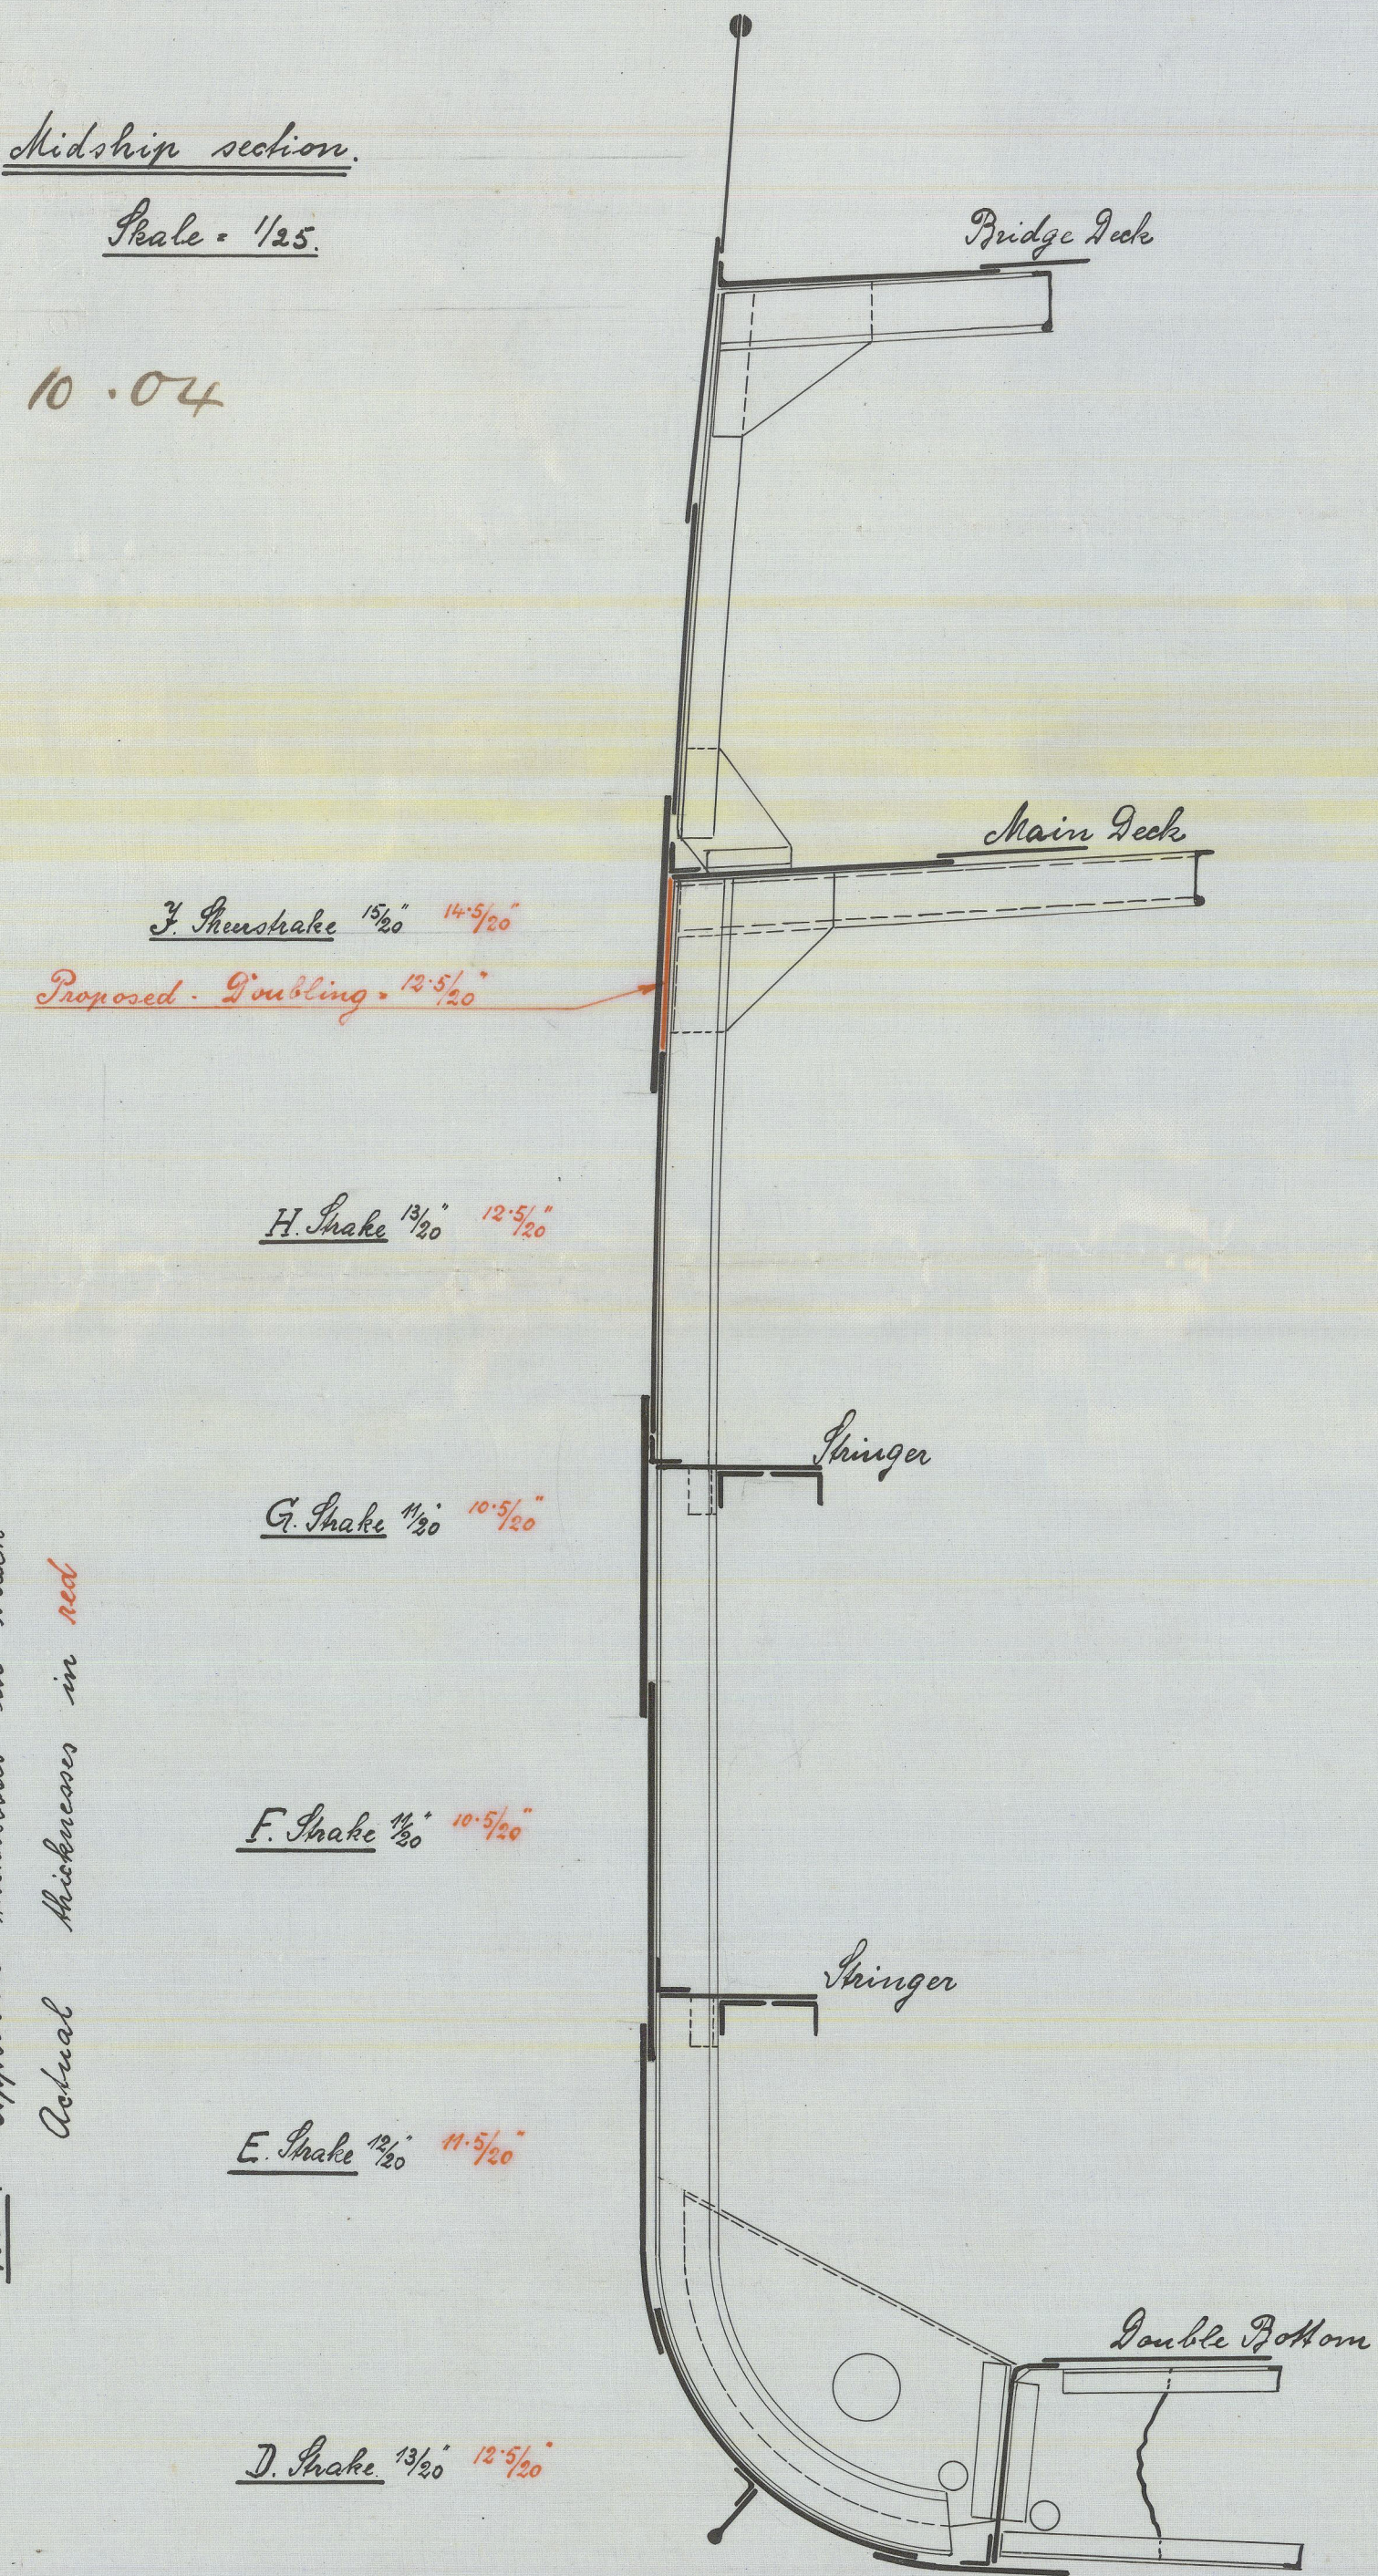


S. S. No 546.

Sketch shewing proposed doubling of Sheerstrake.

Scale = $\frac{1}{100}$.

Stettiner Oderwerke
Aktiengesellschaft
für Schiff- und Maschinenbau

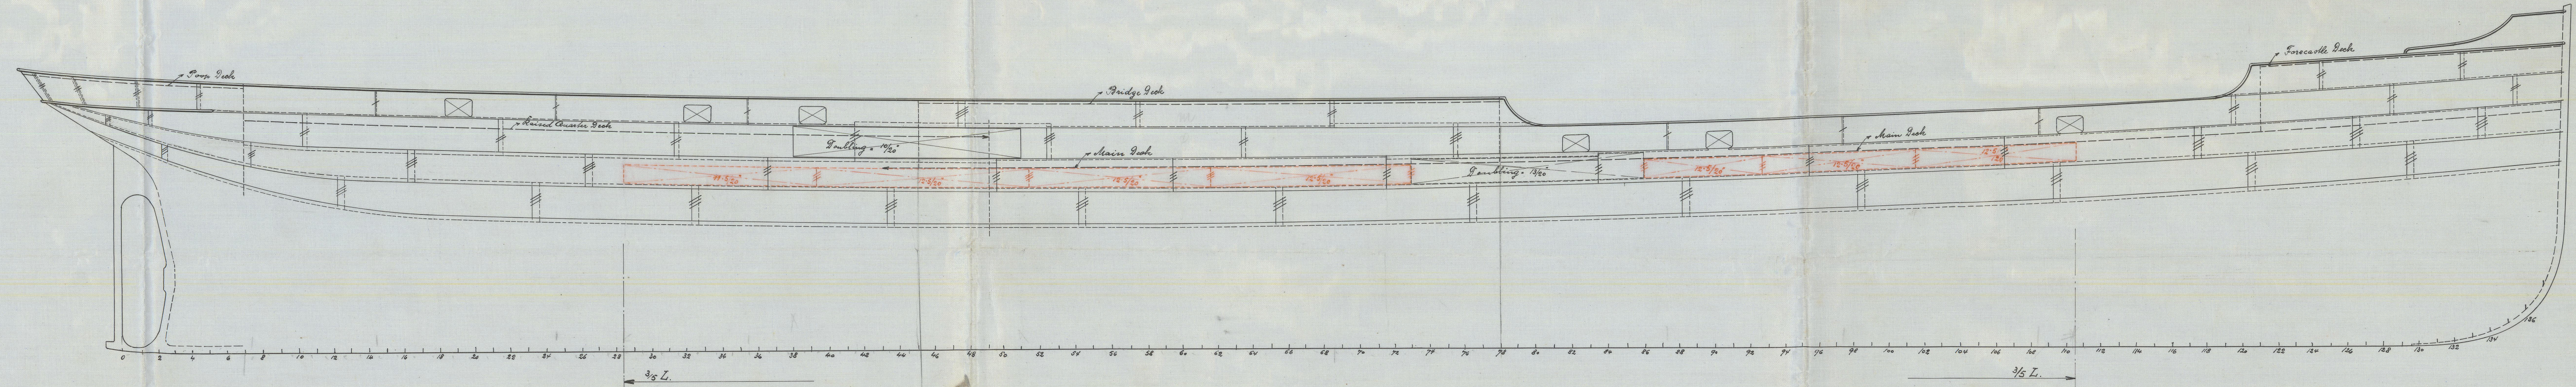

Schiffbau-Bureau
No. 2757

© 2021

Ency. No 378.
in, Jan 26. 10. 04.


Elwine Koppes
Stn 234







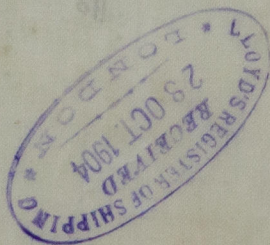



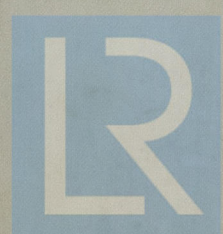

© 2021

Lloyd's Register
Foundation

003023-003028-0006