


3 Buganker (stocklos).....je 86 Cwts.
1 Stromanker (stocklos)..... 33 " "
Ankerstegkette... 300 Faden 68mm &
1 Stahl-Schlepptrosse... 430 " " 5 1/2" Umfg.
1 " --Stromankertrosse 420 " " 5" "
4 Manilaleinen....je 100 " " 8" " "

D	37'
$L \times D$	17945.
$L \times (B+D)$	51773,75.
$L:D$	13,108.

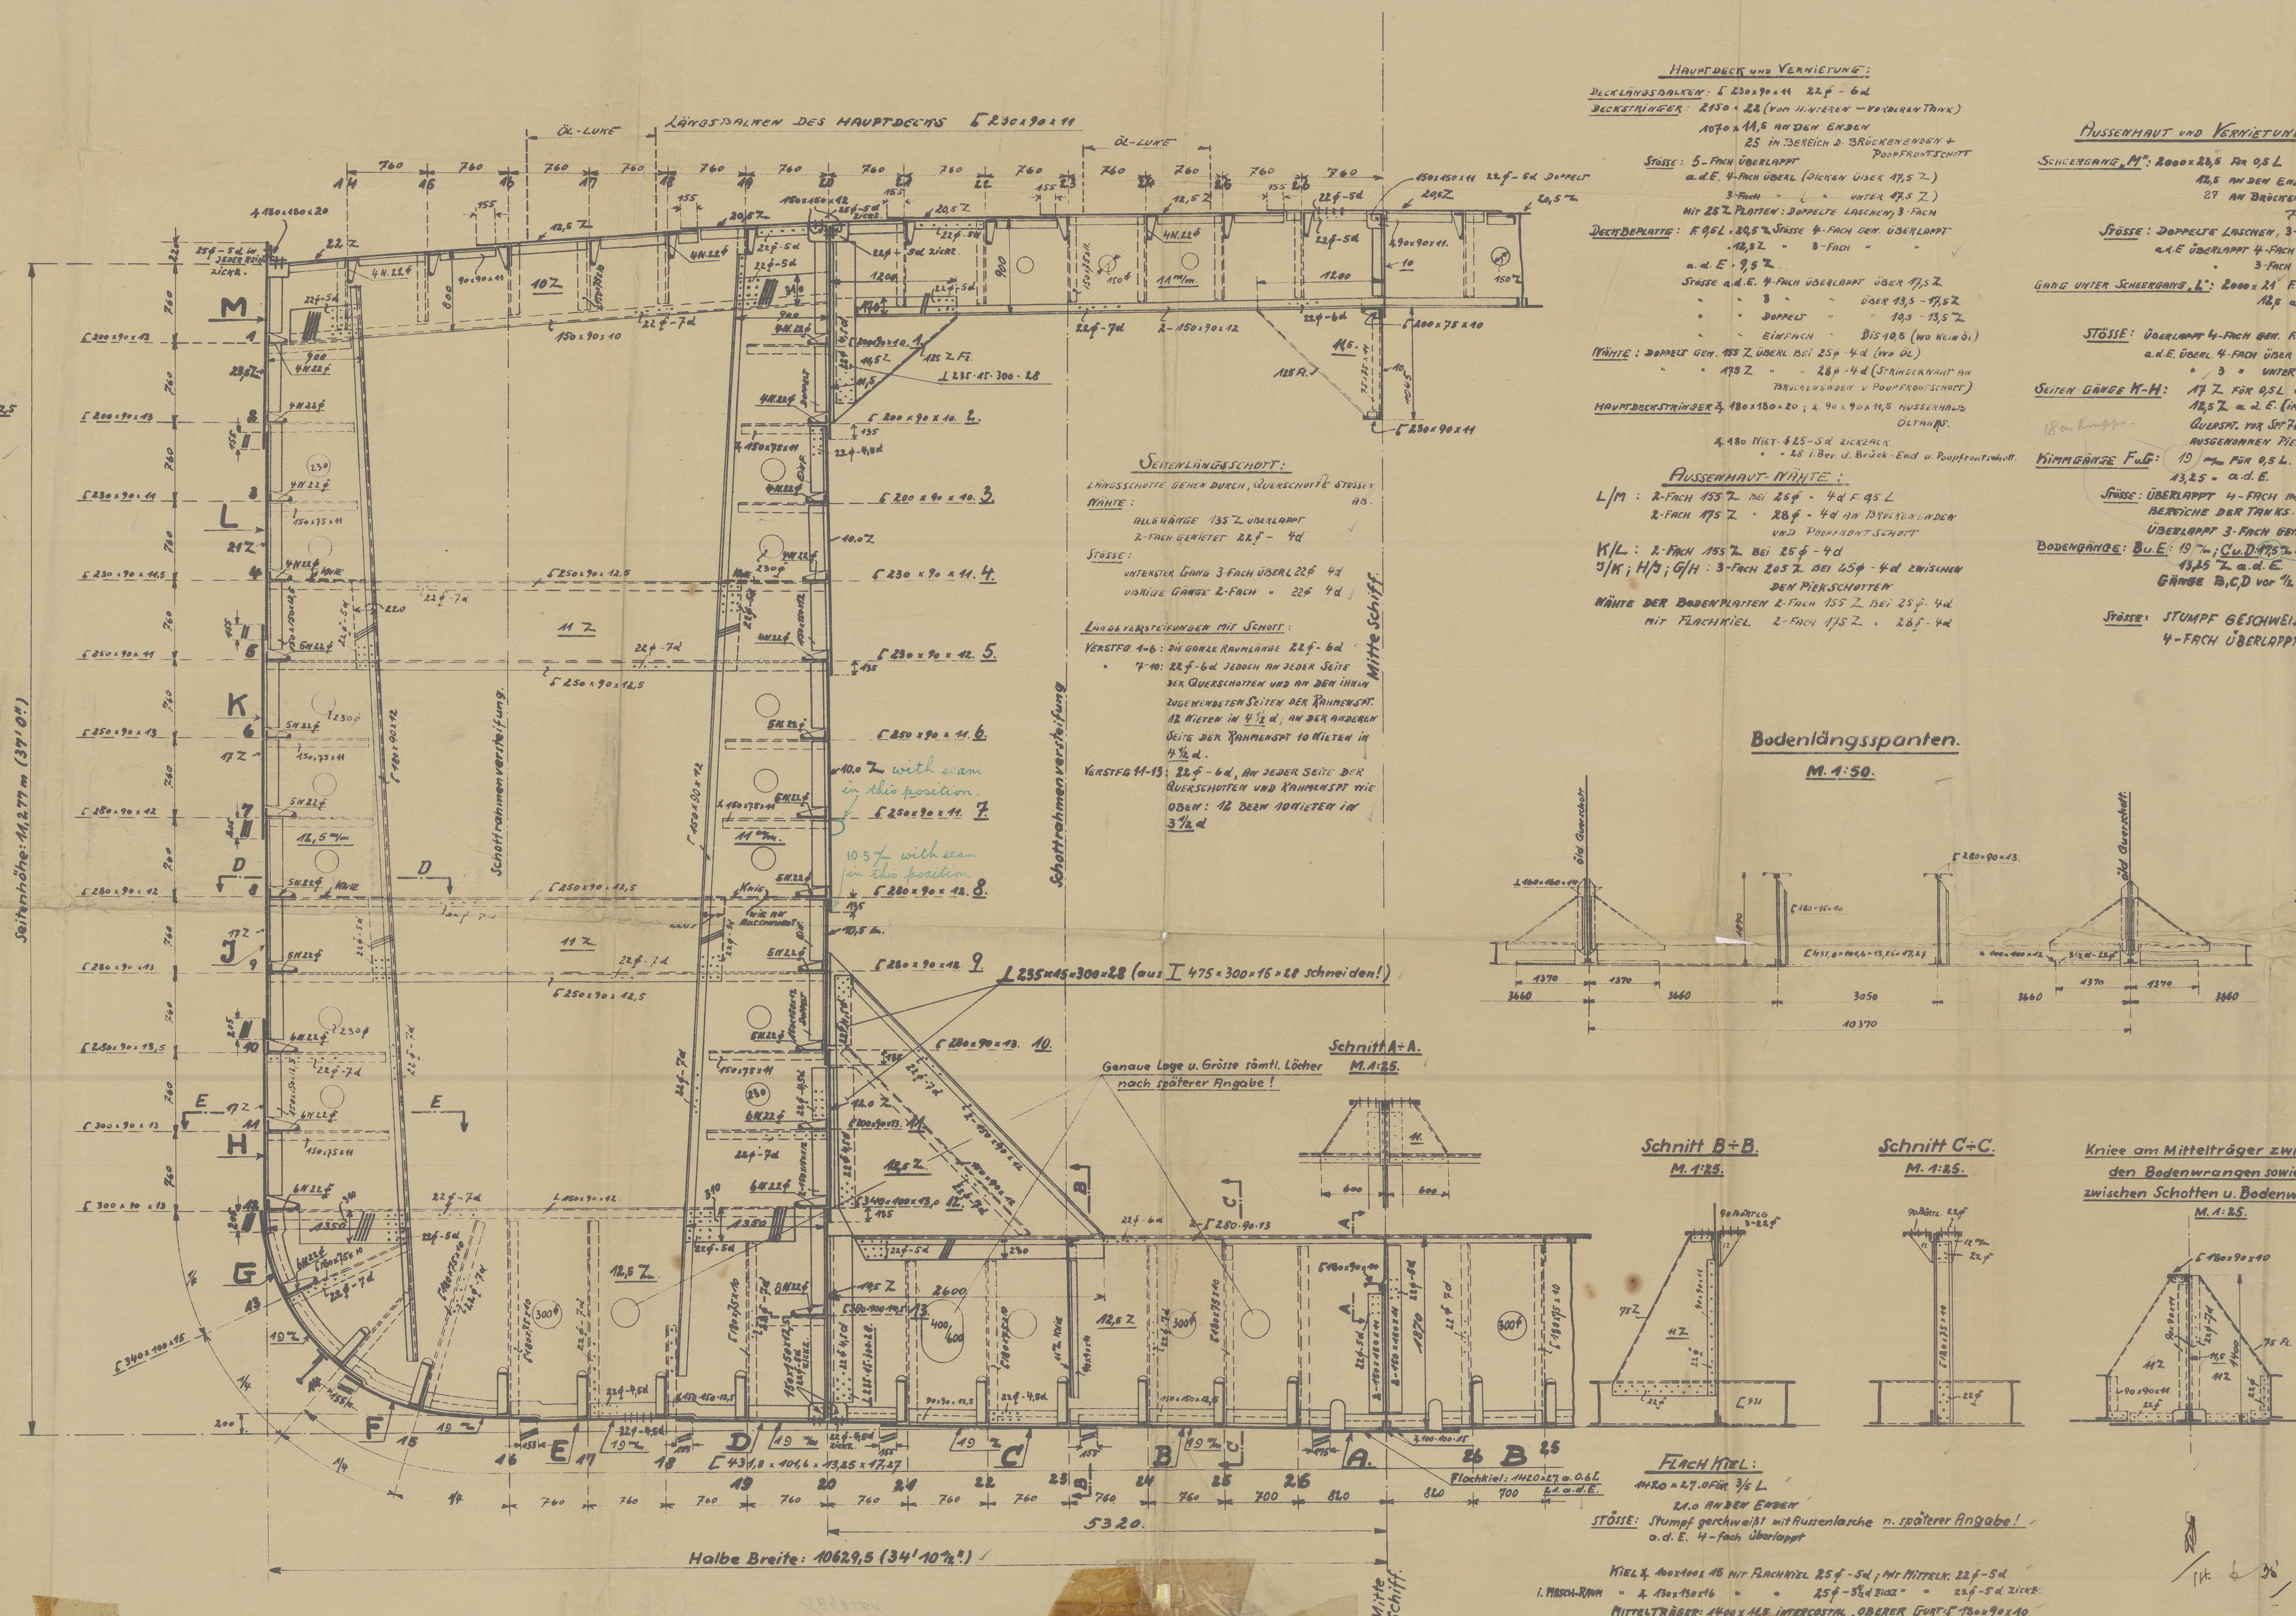

APPROVED BY
SIR JOSEPH W. FISHERWOOD & Co. LTD.,
4, LLOYDS AVENUE,
LONDON, E.O. 3.
DATE 11/6/35 *W.S.*

GEN. DOK. N° 634

S. 1350

F. SCHICHAU G.M.B.H. ELBING
29. MAI 1895
ABT. SCHIFFSWERFT
ZU DANZIG

(L)

Genehmigt von Germanischen Lloyd am 22. III. 95.

KLASSE:

Lloyd's Register of Shipping * 100A1
"for Carrying Petroleum in Bulk."

F. Schichau G.m.b.H., Elbing.
Abt. Schiffswerft zu Danzig.

Mud Ship Section TAGALAM

Haupt-Rahmenspant.

H. 32386.

S. 1350

M. 4:25, 4:50.

Georden: F.W. 95 Wand
Zeland el 8/11/95

B 2.

Now
"CASSIAN SEA"
EX
TAGALEM



© 2021

Lloyd's Register
Foundation

003023-003028-0149