


31 MAY 1938

YARD N° 438


ARRANGEMENT OF MANHOLES & DUCTS
FOR HEATING COILS

SCALE 1/2" = 1 FOOT.

Approved
J. H. A. W. W.
2/6/38

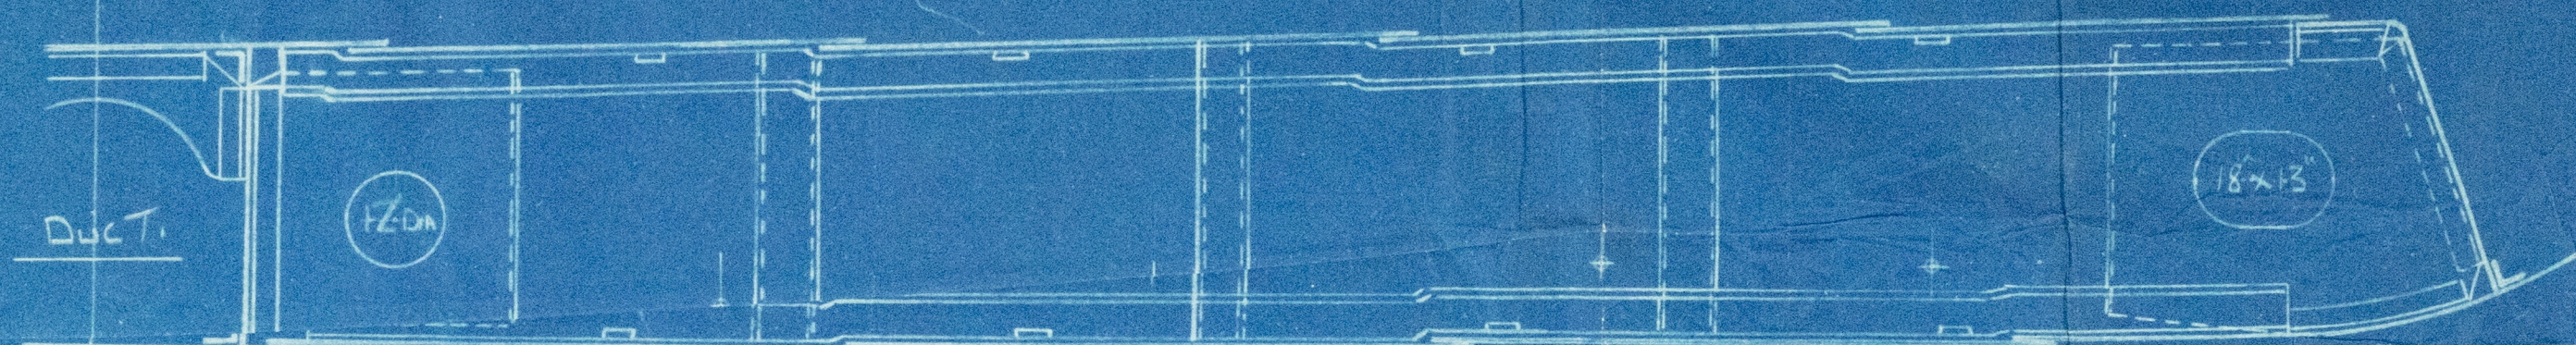

SECTION THRO BRACKET FLOOR

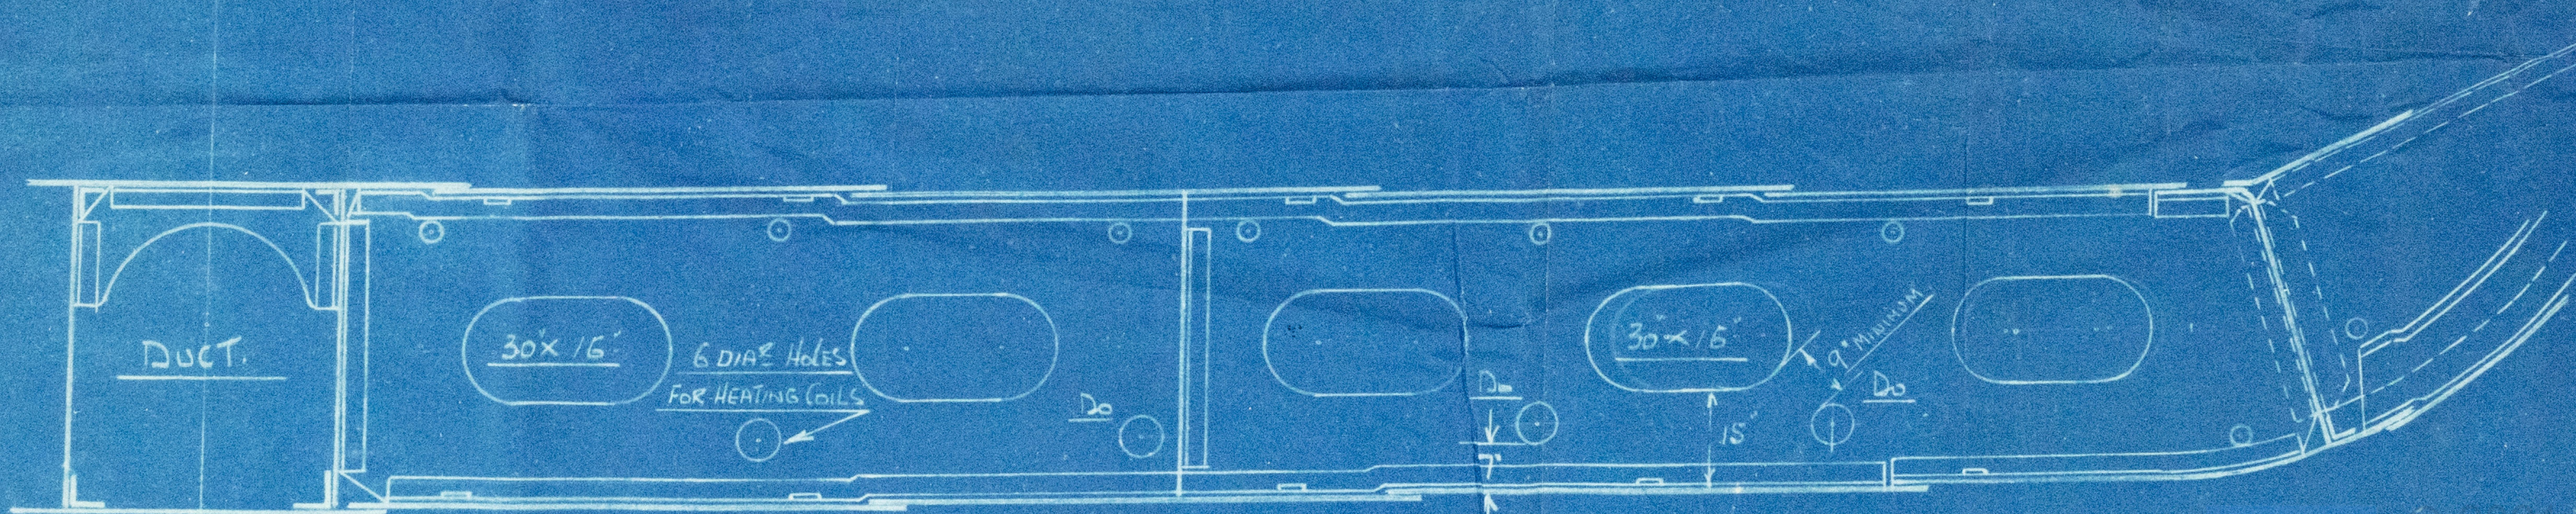

SECTION THRO. SOLID FLOOR.

003029-003037-0046.2



B. b



© 2021

Lloyd's Register

003029-003037 Foundation 2