

Nº 110.


PROFILE.

SCALE  $\frac{1}{8}'' = 1'$

Detail plans to be submitted



Approved  
See letter No 2-6  
(sig'd) J.T.K.

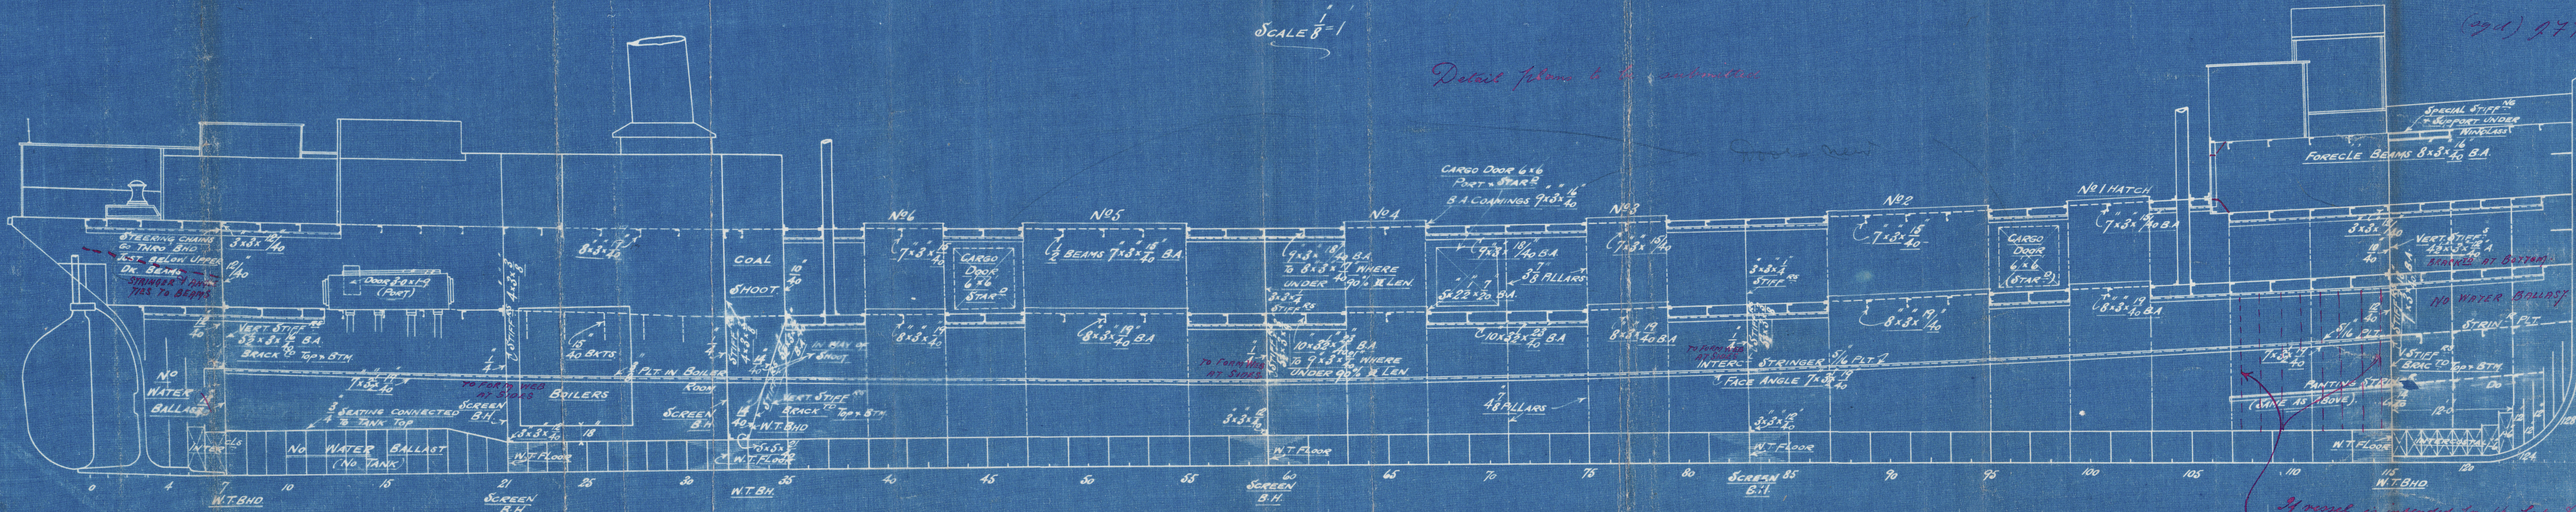

If vessel is intended for the Lake & Canal service it is recommended that shell stiffening angle be fitted in each frame space as shown from No 7 frame to 115' extending on height from above line up to new gunwale.



00704 003037-0130



R STEPHENSON N<sup>o</sup> 110

TRANSFERRED TO  
L. R. SYSTEM

PROFILE

S.S. EDMONTON

~~S.S.~~

TRANSFERRED TO  
L. R. SYSTEM



© 2021

Lloyd's Register  
Foundation