



Approved Confirmed
12/11/28

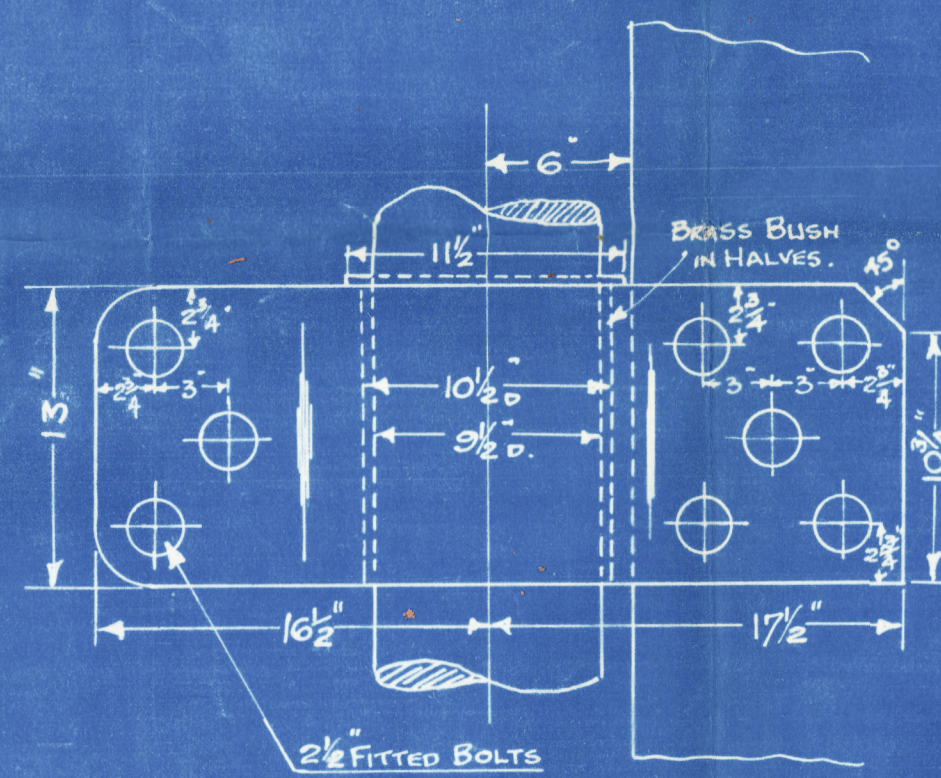

ALL CASTINGS & FORGINGS TESTED TO REQUIREMENTS
OF BRITISH CORPORATION & CANADIAN STEAMBOAT INSPECTION

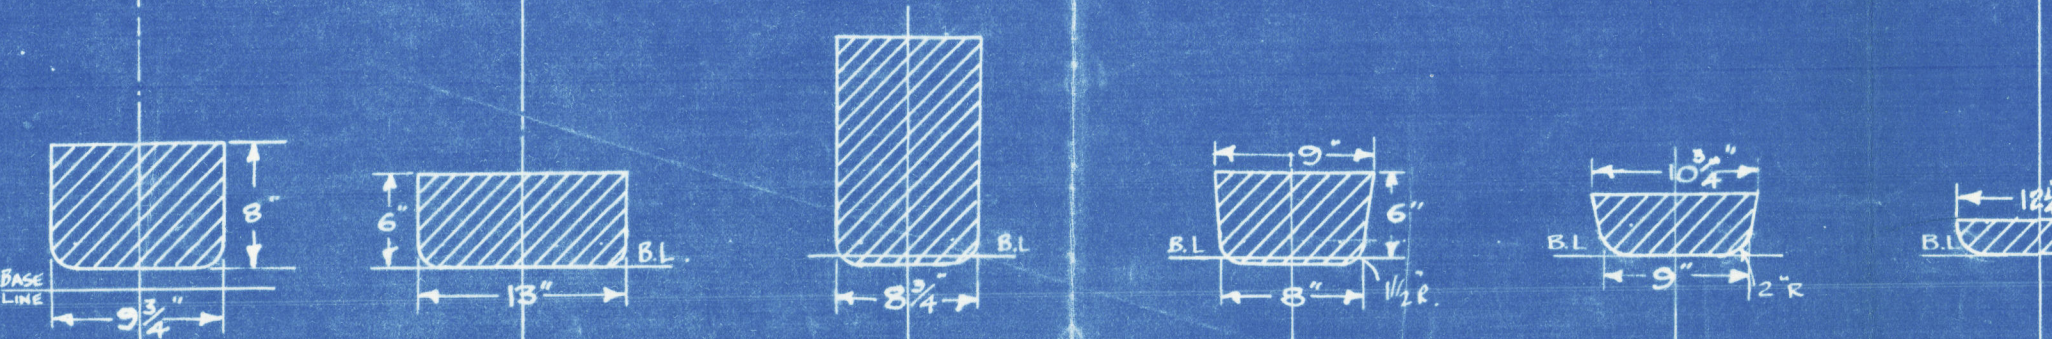

STERNPOST & RUDDER

THE BRITISH COMMONWEALTH
REGISTER OF SHIPS
AND AIRCRAFT
APPROVED. _____
DATE _____

Foundation
003038-003045-020

3

Rudder & Sternpost

Dave S & R. Co.

N^o 501. ~~Midland N^o 23~~


12. 11. 28.

Dave N^o 501. $\frac{5}{8}$ "CITY of WINDSOR"

~~Midland N^o 23. $\frac{5}{8}$ "Hermie"~~

00 3038-00 3045-0257

Dave S & R. Co. 501.

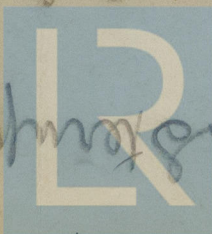

© 2020

Lloyd's Register
Foundation