
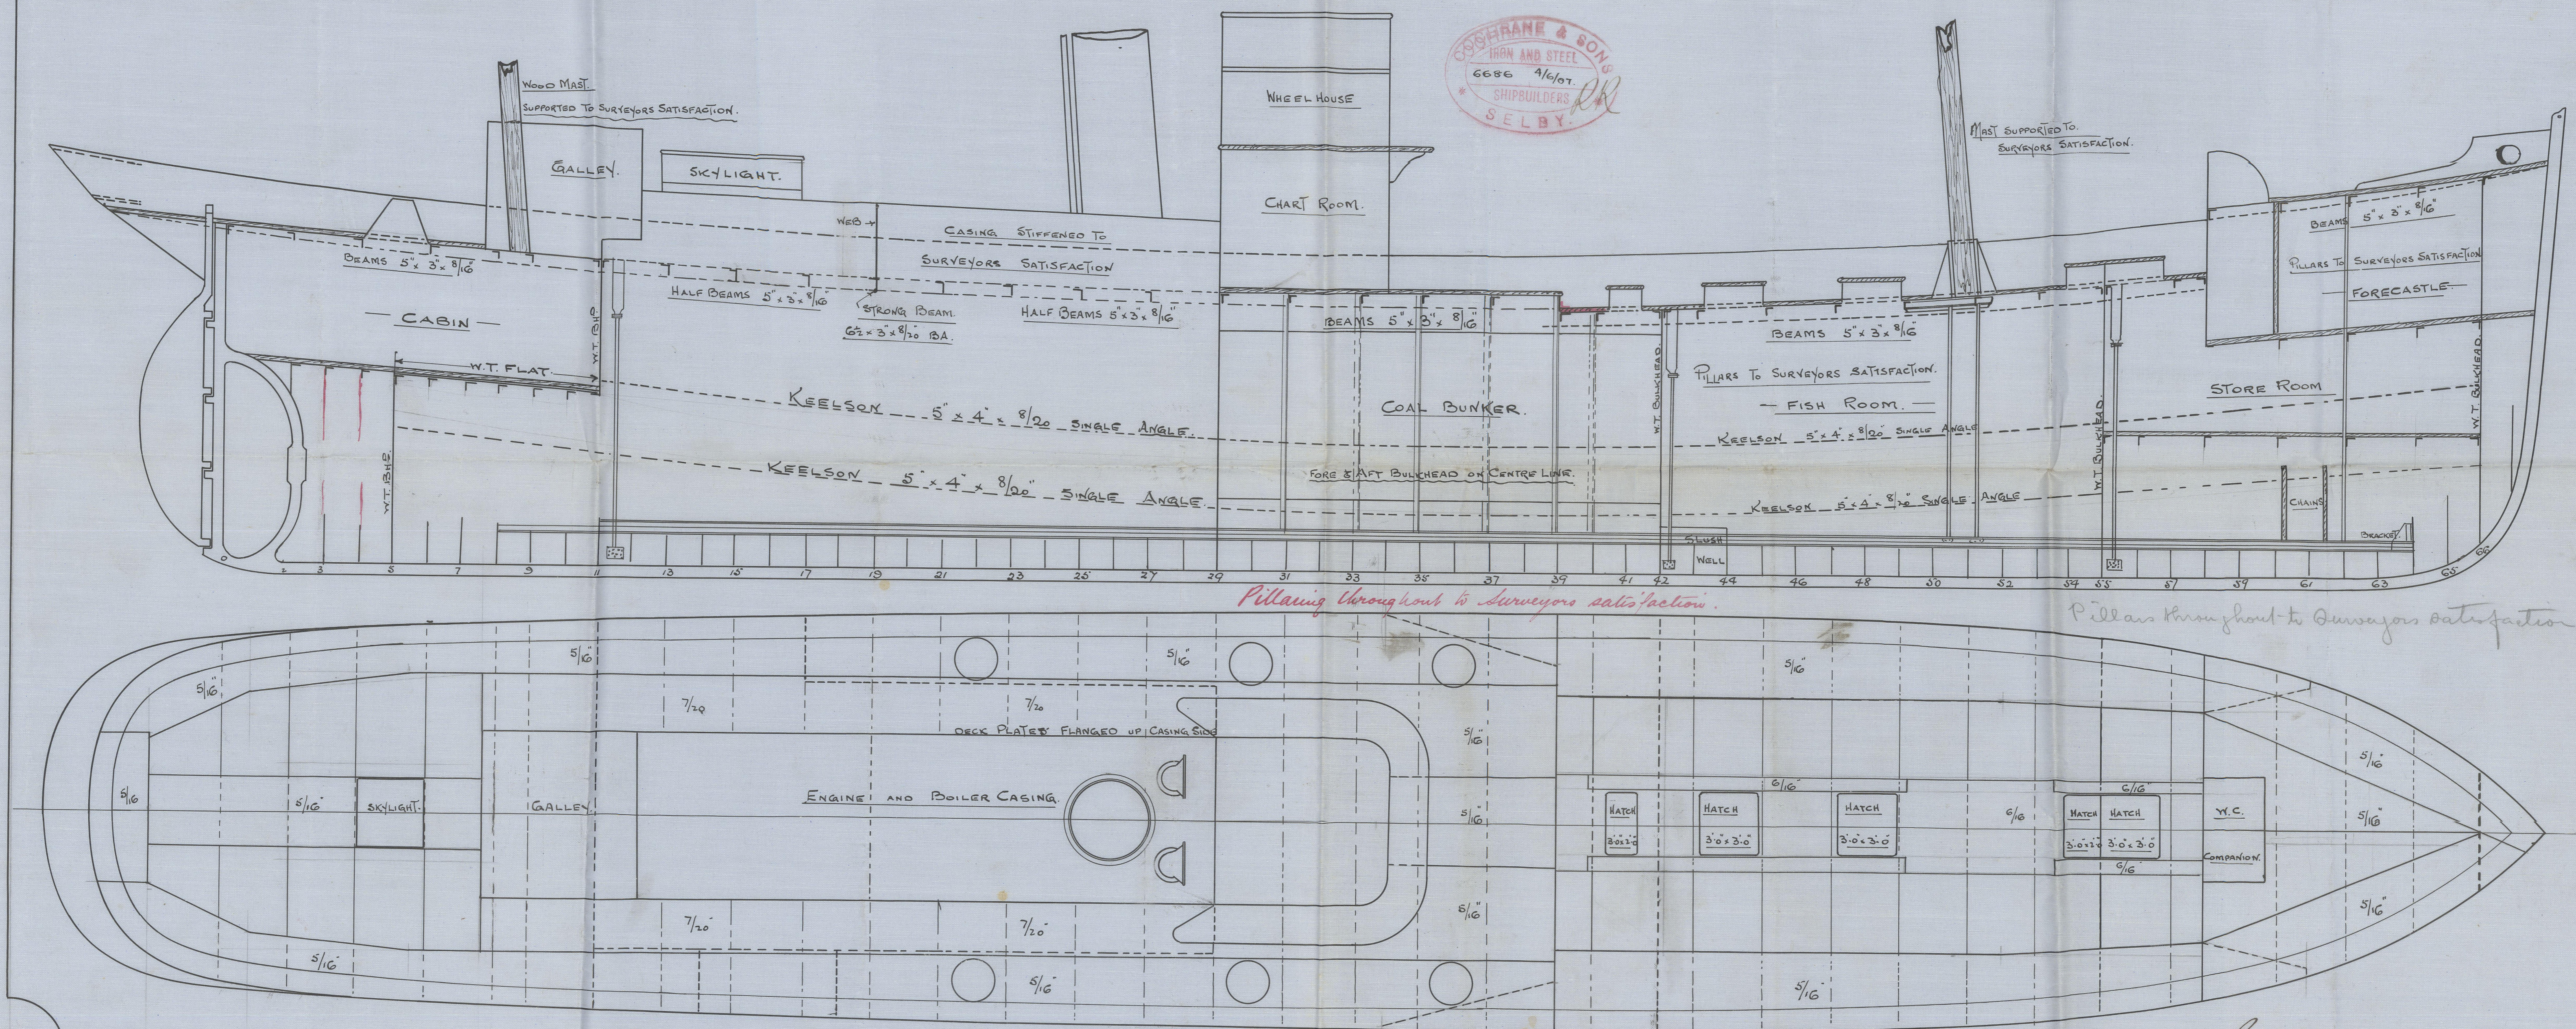


8.6.07
17.6.07

PROFILE AND DECK PLAN.
STEEL SCREW TRAWLER. No 421.



SCALE $\frac{1}{4}$ " = ONE FOOT.

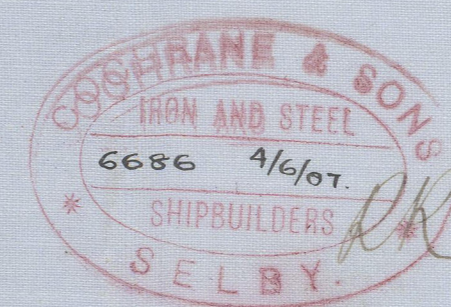




C.B.
7.6.07.

Handwritten notes in red ink at the bottom center of the page, including 'No 421' and 'Steel screw trawler'.

4s Dewland
- Profile & Deck Plan -
Lochrane & Sons, Selby
Hull Report No 196241
- 4s No. 421 -

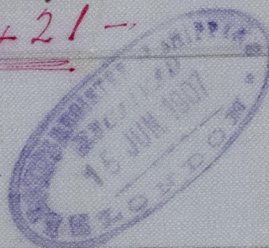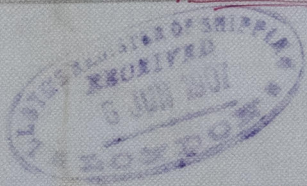

003046-003055-0144

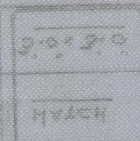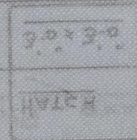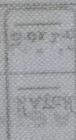

© 2020

Lloyd's Register
Foundation