


11 1/2" DIA COUPLING  
6- 1/4" DIA BOLTS ON 8 1/2" P.D.C.  
BOLTS LOCKED WITH SPLIT PINS.

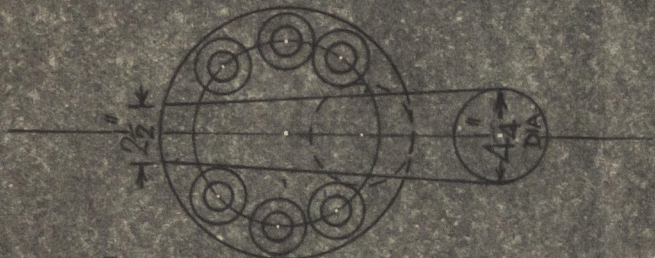

FAVING SURFACES OF COUPLING TO BE  
CLOSED TO SURVEYOR'S SATISFACTION.

NOTE.  
COUPLINGS WILL CLEAR FOR  
UNSHIPPING WHEN SWUNG  
40° PORT & STARBOARD  
RESPECTIVELY.


KEYWAY 6x 1/32 x 1/16

1" DIA WHIT  
EYEBOLT


S/S "DOWNSHIRE"

RUDDER FRAME

DO NOT SCALE FIGURED DIMENSIONS  
TO BE WORKED TO

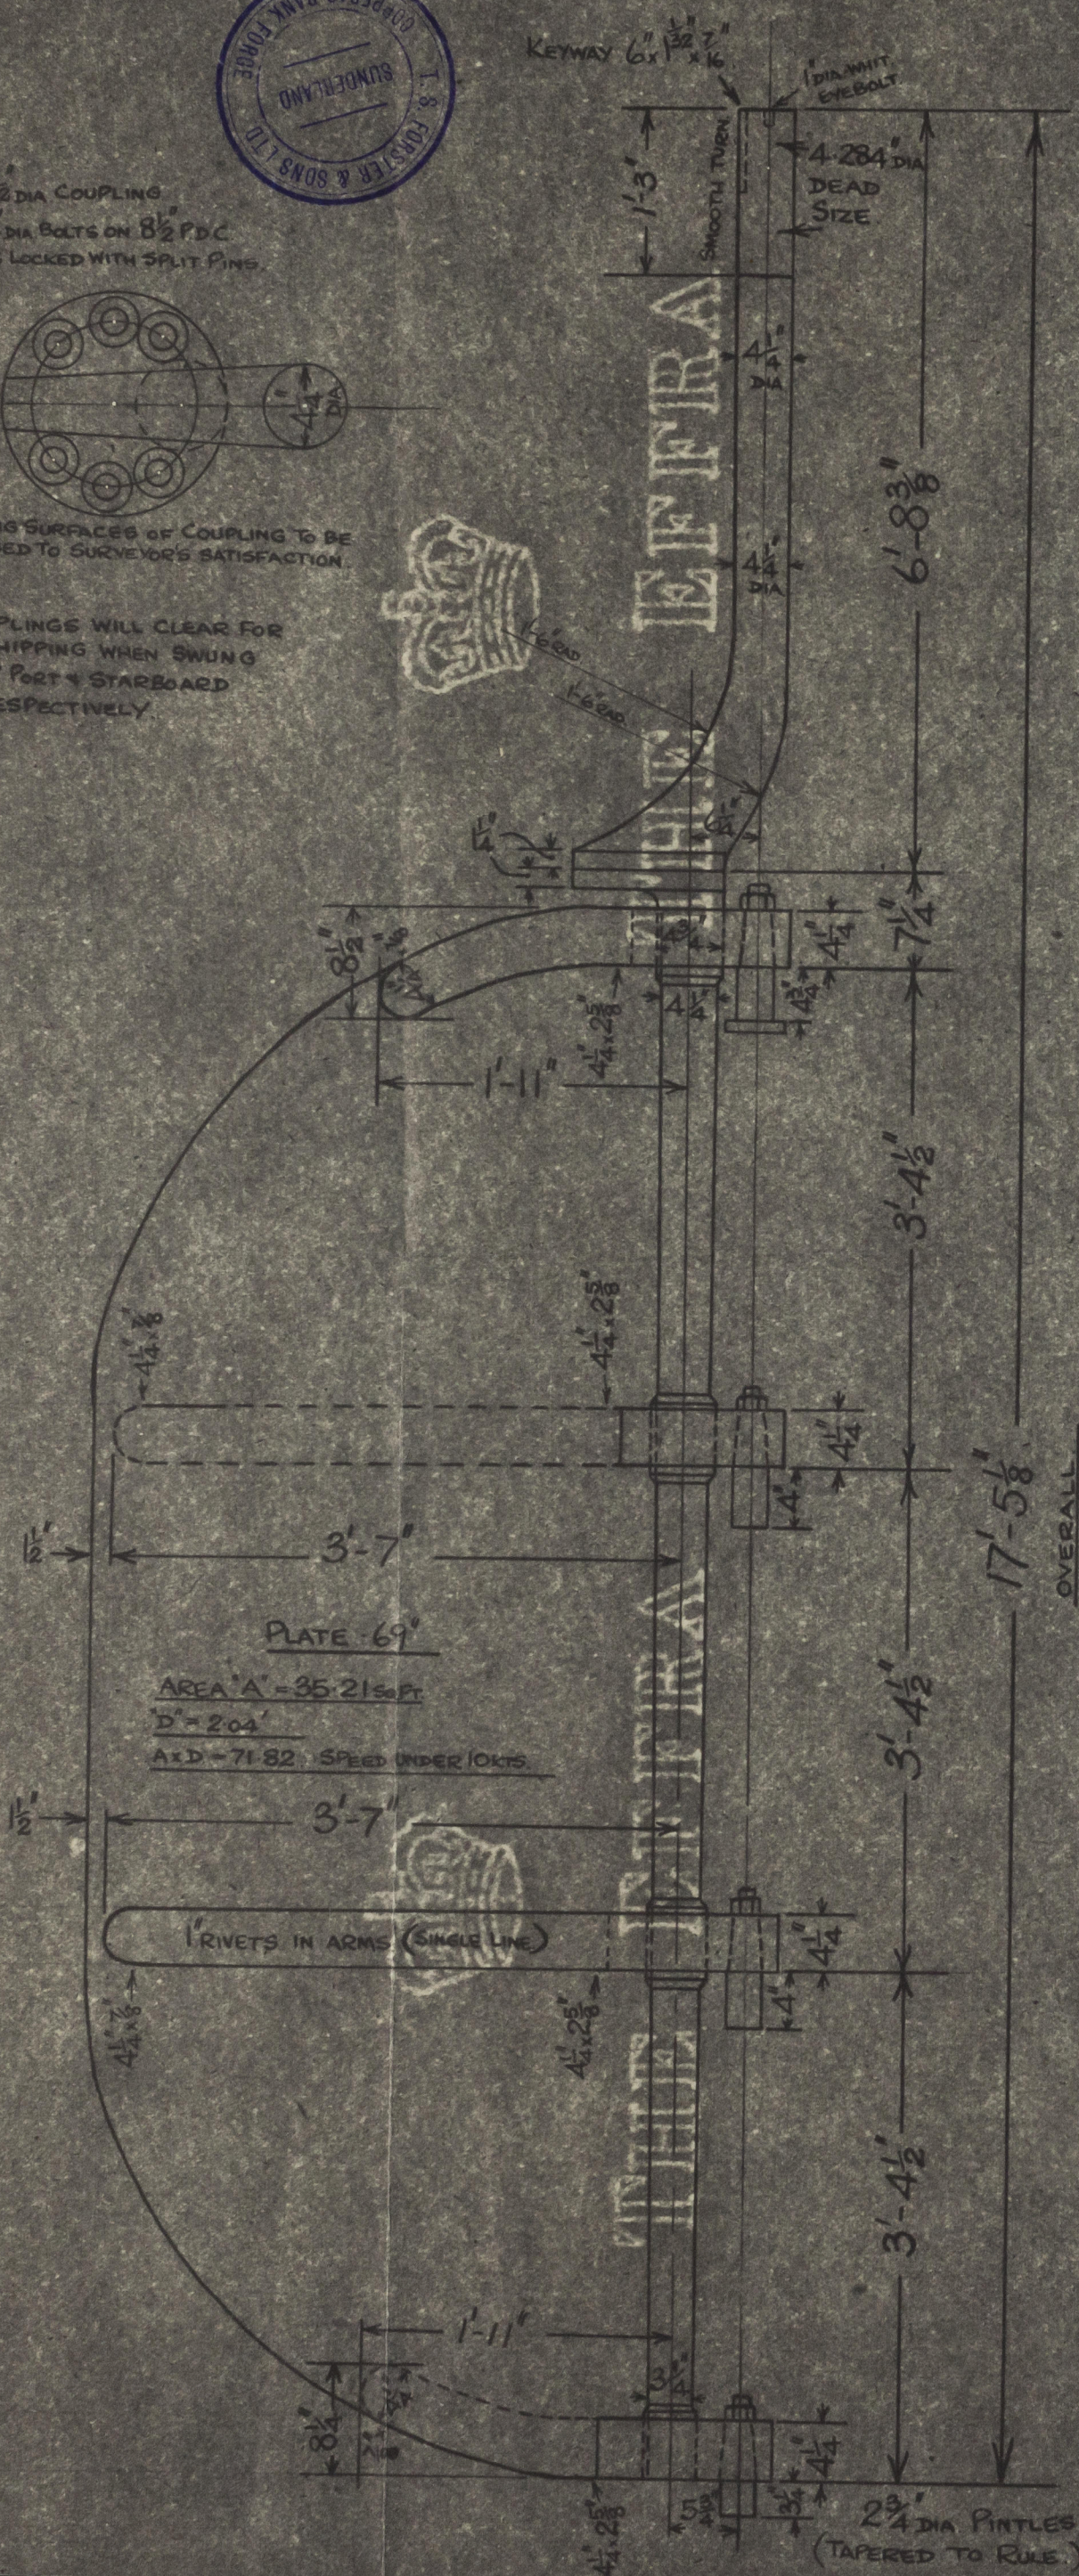

Approved  
15.2.55

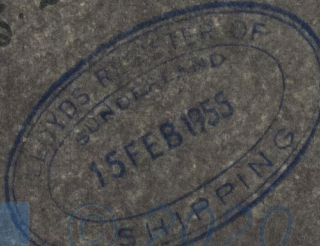

Lloyd's Register  
Foundation

003056-003064-0001




"Downshire"

Rudderframe

Rpt. no. Bot. 15935

---

 

003056-003064-0001



© 2020

Lloyd's Register  
Foundation