

# RUDDER & STERNFRAME.

S. S. N° 297


SCALE 1" = ONE FOOT.

HOLES IN RUDDER ARMS BORED  $1\frac{1}{8}$ " FOR 1" RIVETS  
SPACED  $4\frac{1}{2}$ " APART AND COUNTERSUNK

$A \times D = 70.86$

SPEED UNDER 10 KNOTS

HOLES IN STERNFRAME BORED  
 $1\frac{1}{8}$ " FOR 1" RIVETS.

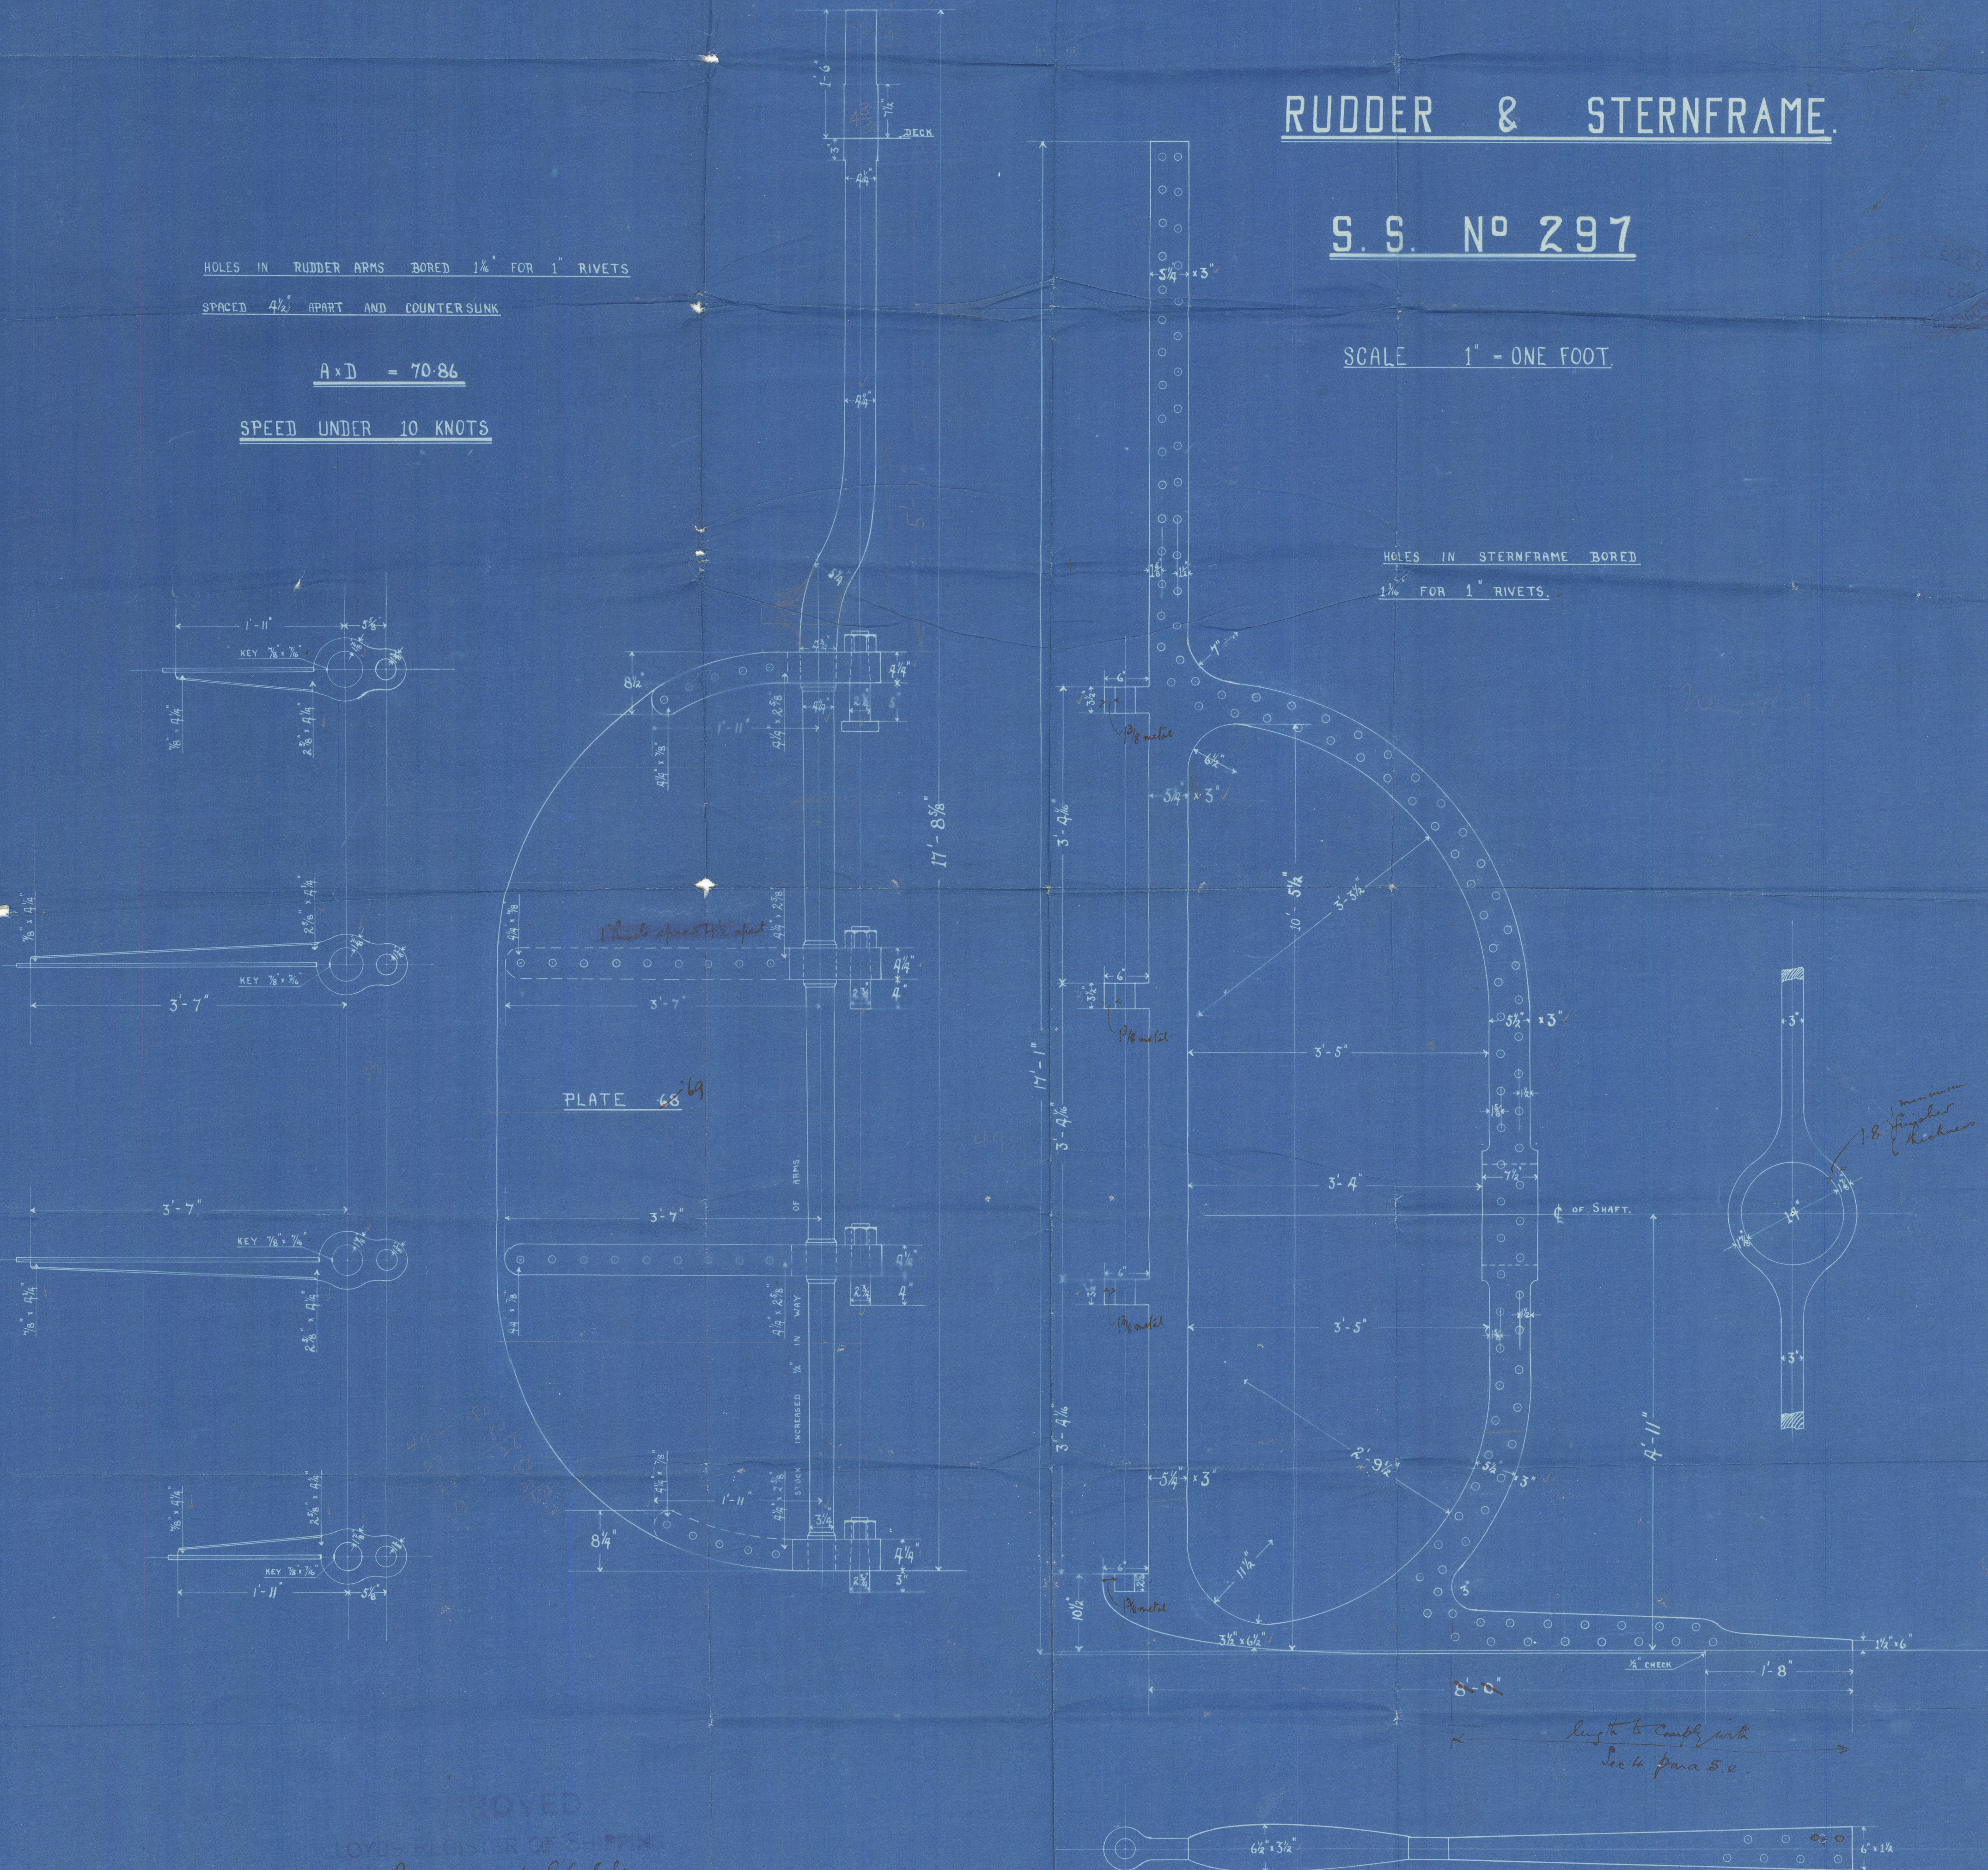

APPROVED  
LOYD'S REGISTER OF SHIPPING


J. Montgomerie & Co. Ltd.  
2/8/24



Russell &  
Stemframe  
of 297  
Scotts

GLASGOW REPORT No. 44306

A. D. Downshire

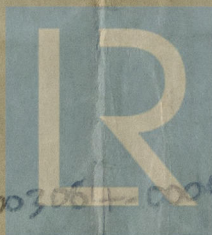

© 2020

Lloyd's Register  
Foundation

003056-00306-0004