

Lloyd's Register of Shipping.


Ship's Name

"GLENBANK"

Official No.

147907

Memorandum of alterations reported since ship was surveyed for assignment of Load Lines
in

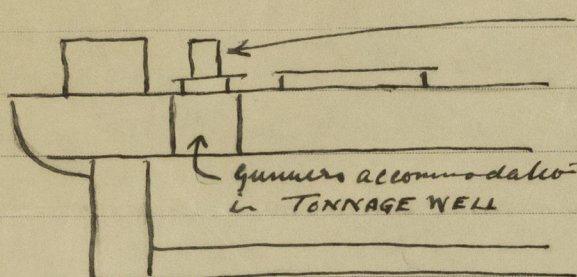

Substantially constructed
steel companionway on closing plating
of tonnage opening.
- 38' casing with stiffeners 30" spacing
Solid wood door 21'x48" sill 27" high.

Edw. T. King
Swansea.

14th Jan 1942

Notes

19/1/42