
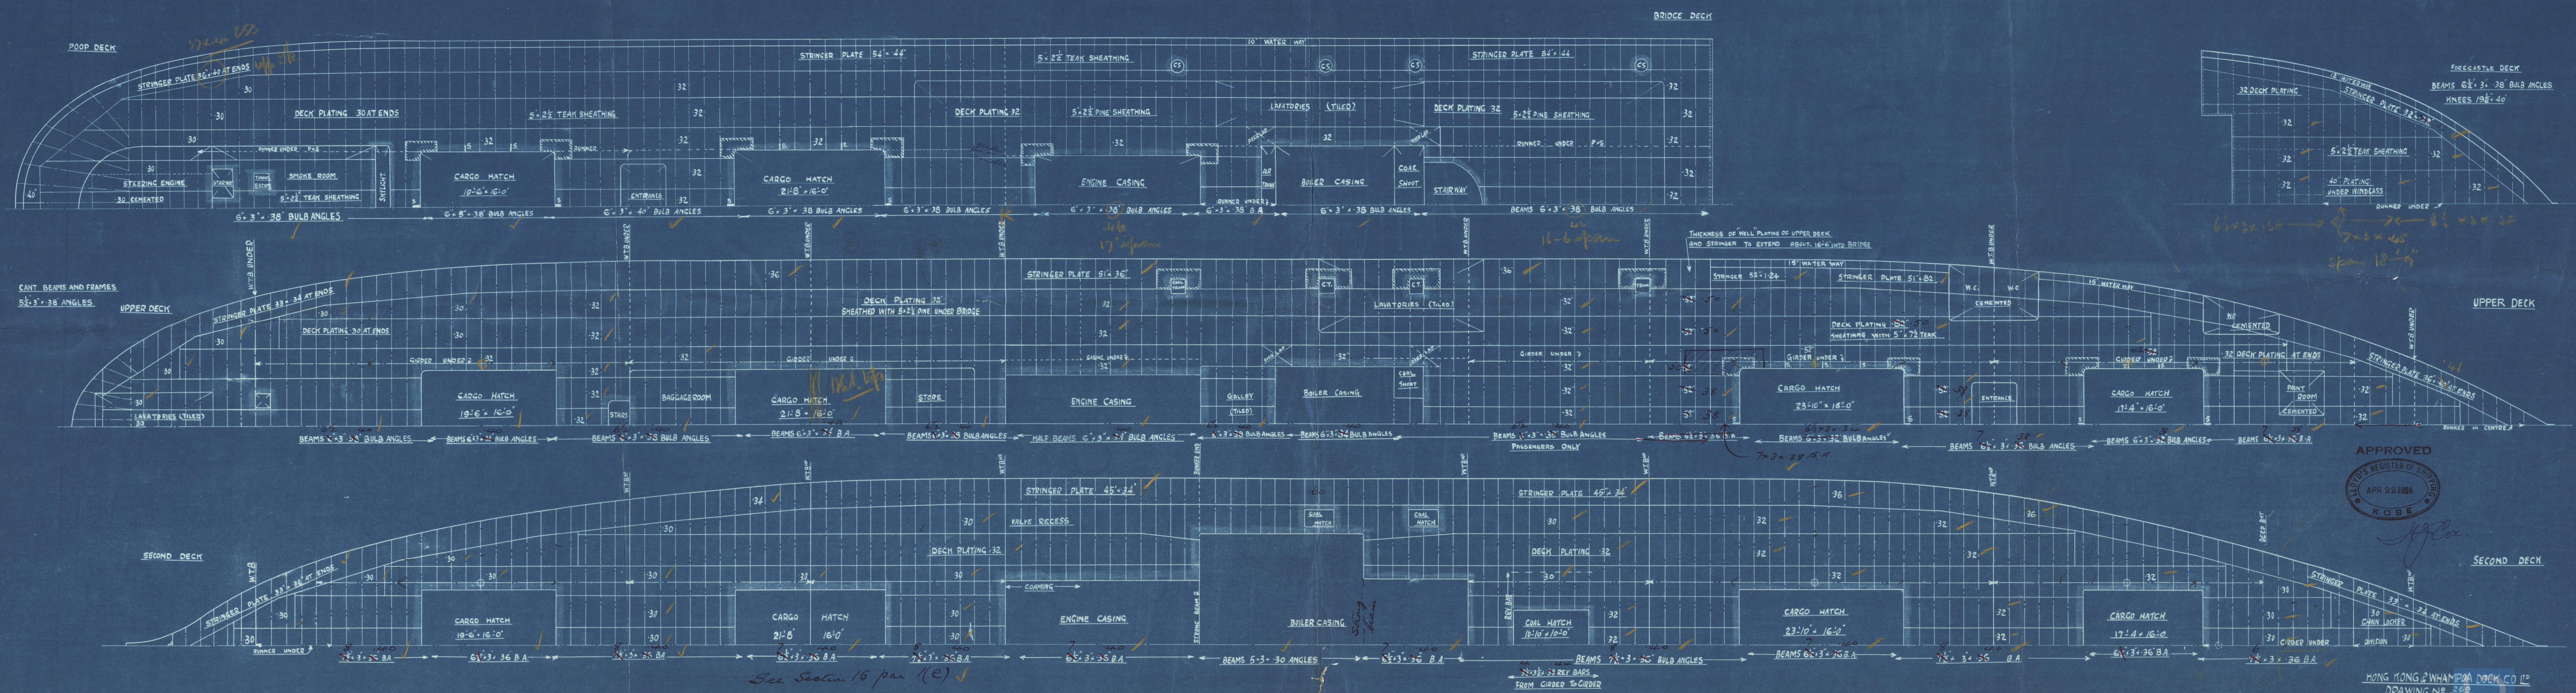
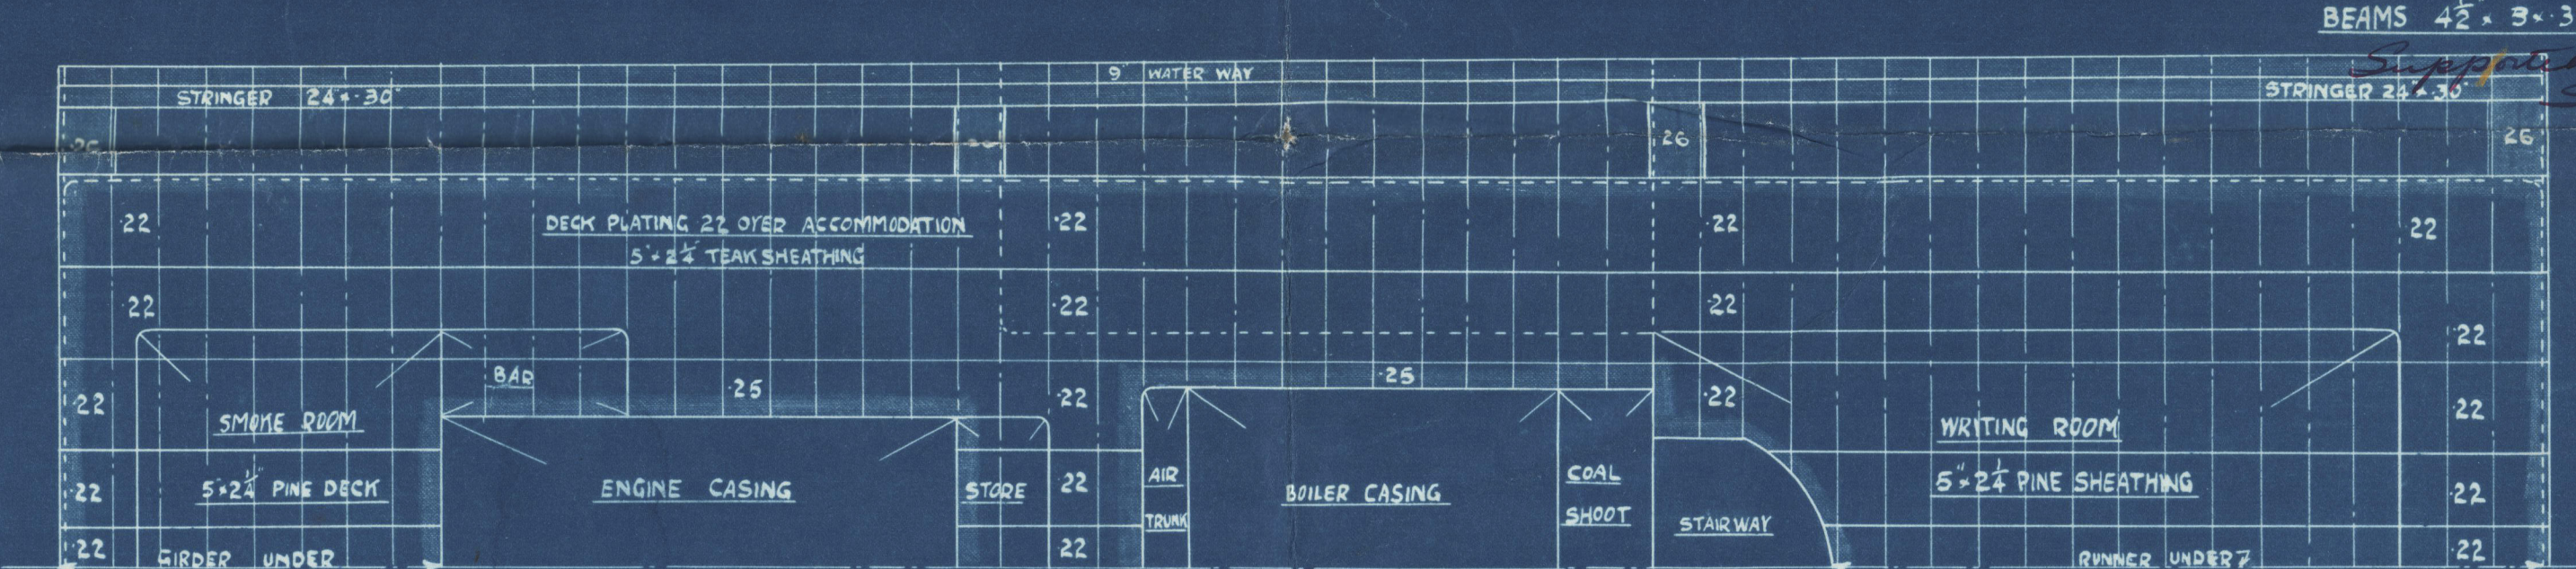
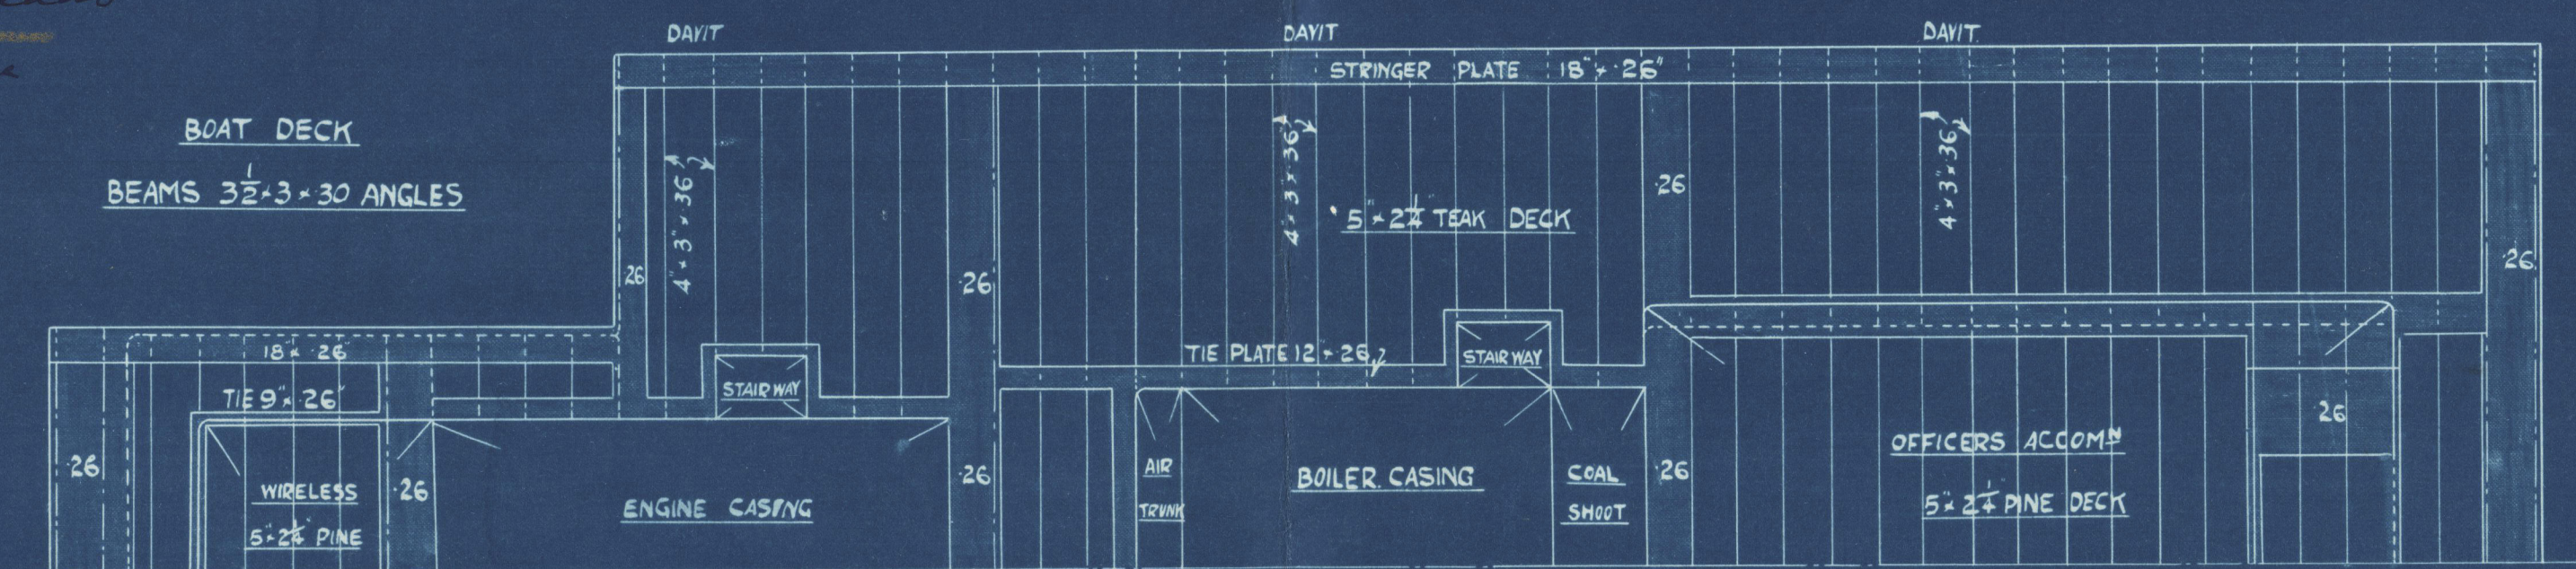


PROFILE AND DECK PLAN.
STEEL SINGLE SCREW STEAMER.
LENGTH B.P. 350'-0" DEPTH M^d 26'-0".
BREADTH M^d 48'-0" DRAFT 23'-0" EXT.
SCALE 1" = ONE FOOT
CLASS * 100 A.I. LLOYDS. FULL SCANTLINGS.

SHEER
FORWARD 6 1/2" AFT 3 1/2"
BEL FROM FP 3 1/2" BEL FROM AP 1 1/2"
BEL " " 1 1/2" " " 1 1/2"
BEL " " 5 1/2" " " 2 1/2"
MOULDED DEPTH = 26'-0"
FOR ERECTIONS SEE MIDSHIP SECTION

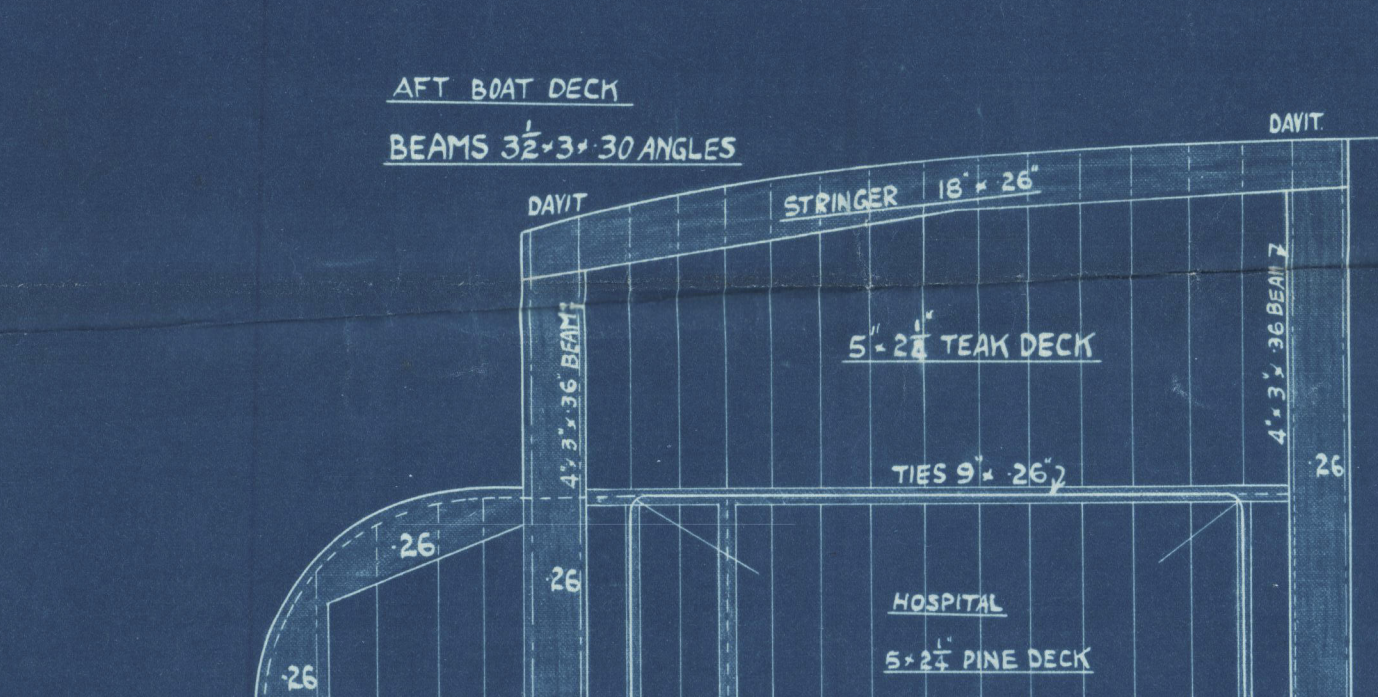

HONG KONG WHARF CO. LTD.
DRAWING NO. 558
3/24

London

1 Hong Kong & Whampoa

Profile & DK ^{Papels}

~~Gen. Box 266.~~

2/5 Changte ¹ Taipei

003056-003064-0292



© 2020

Lloyd's Register
Foundation