

23.9.12





S.S. N° 253.  
PROFILE AND DECK PLAN.

CLASS 100 AL LLOYDS 1908 RULES.

SCALE 1/4" = 1 FOOT.



DIMENSIONS:-

LENGTH BP	155' 0"
BREADTH MID	25' 0"
DEPTH	11' 8"
FORECASTLE SOLE TO MAIN DECK (TOP OF BEAM TO TOP OF BEAM)	7' 0"
MAIN DECK TO QUARTER DECK	3' 6"
" " " BRIDGE	7' 0"
" " " FORECASTLE	6' 3"
ENGINE & BOILER CASING	7' 0"

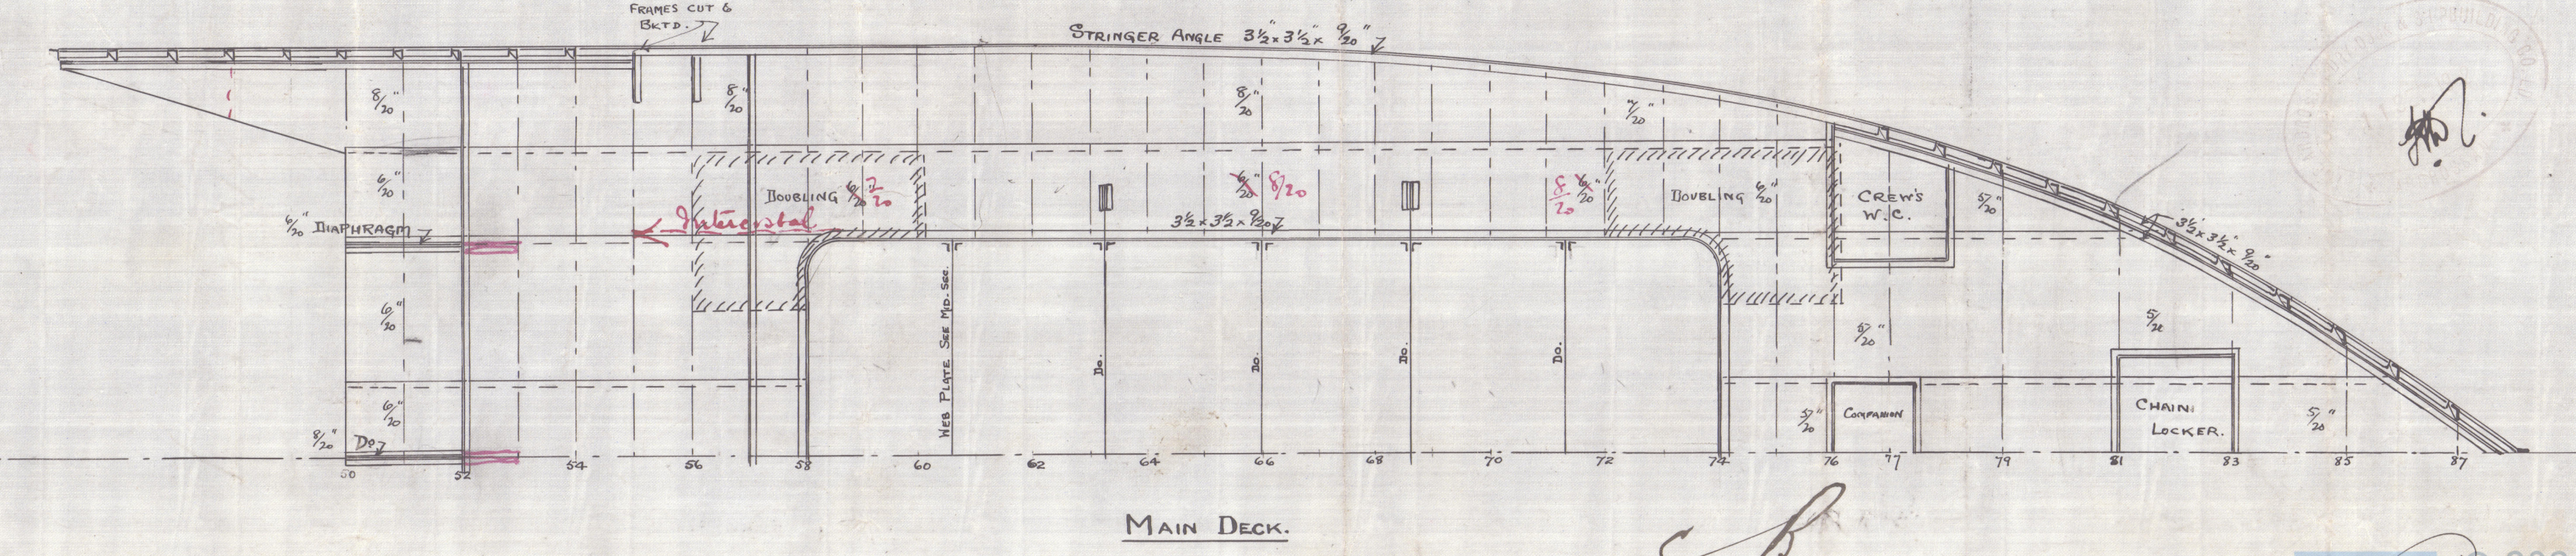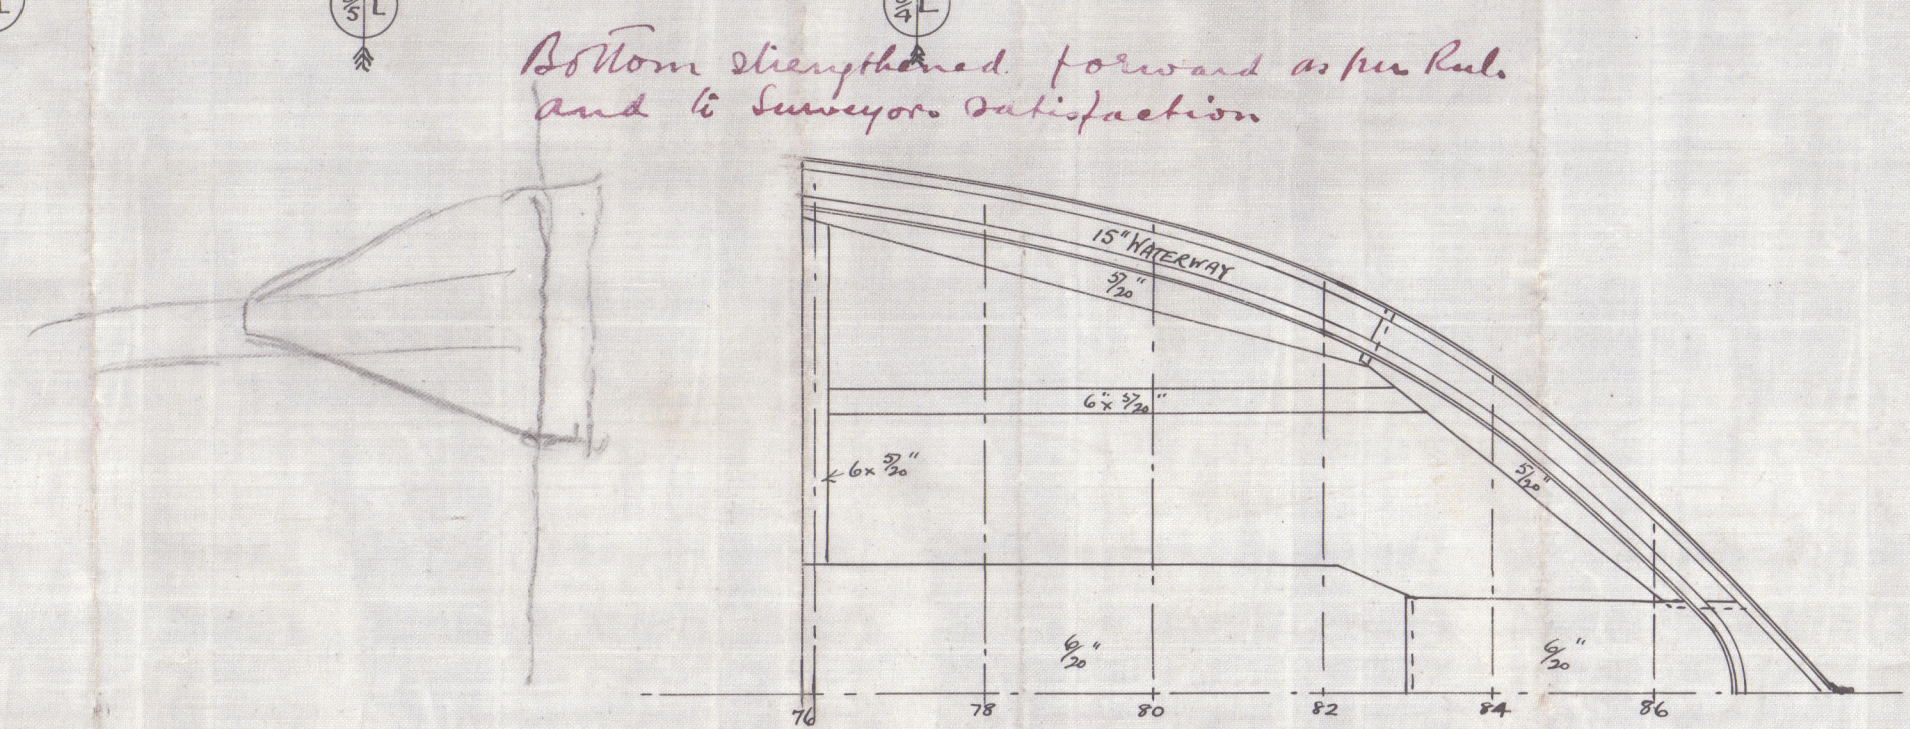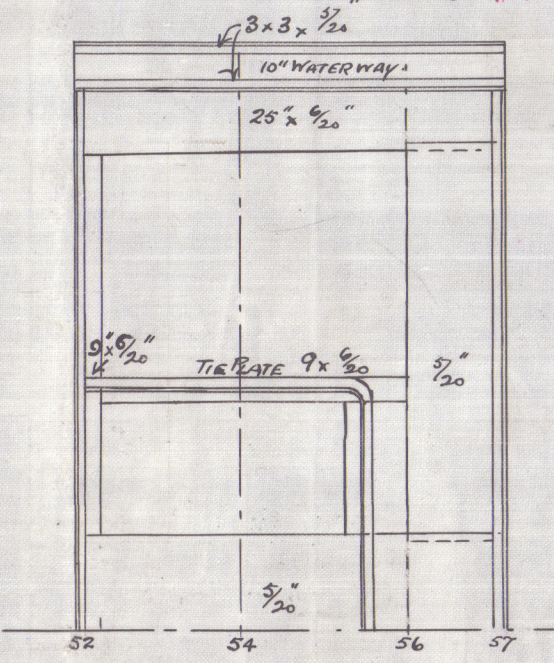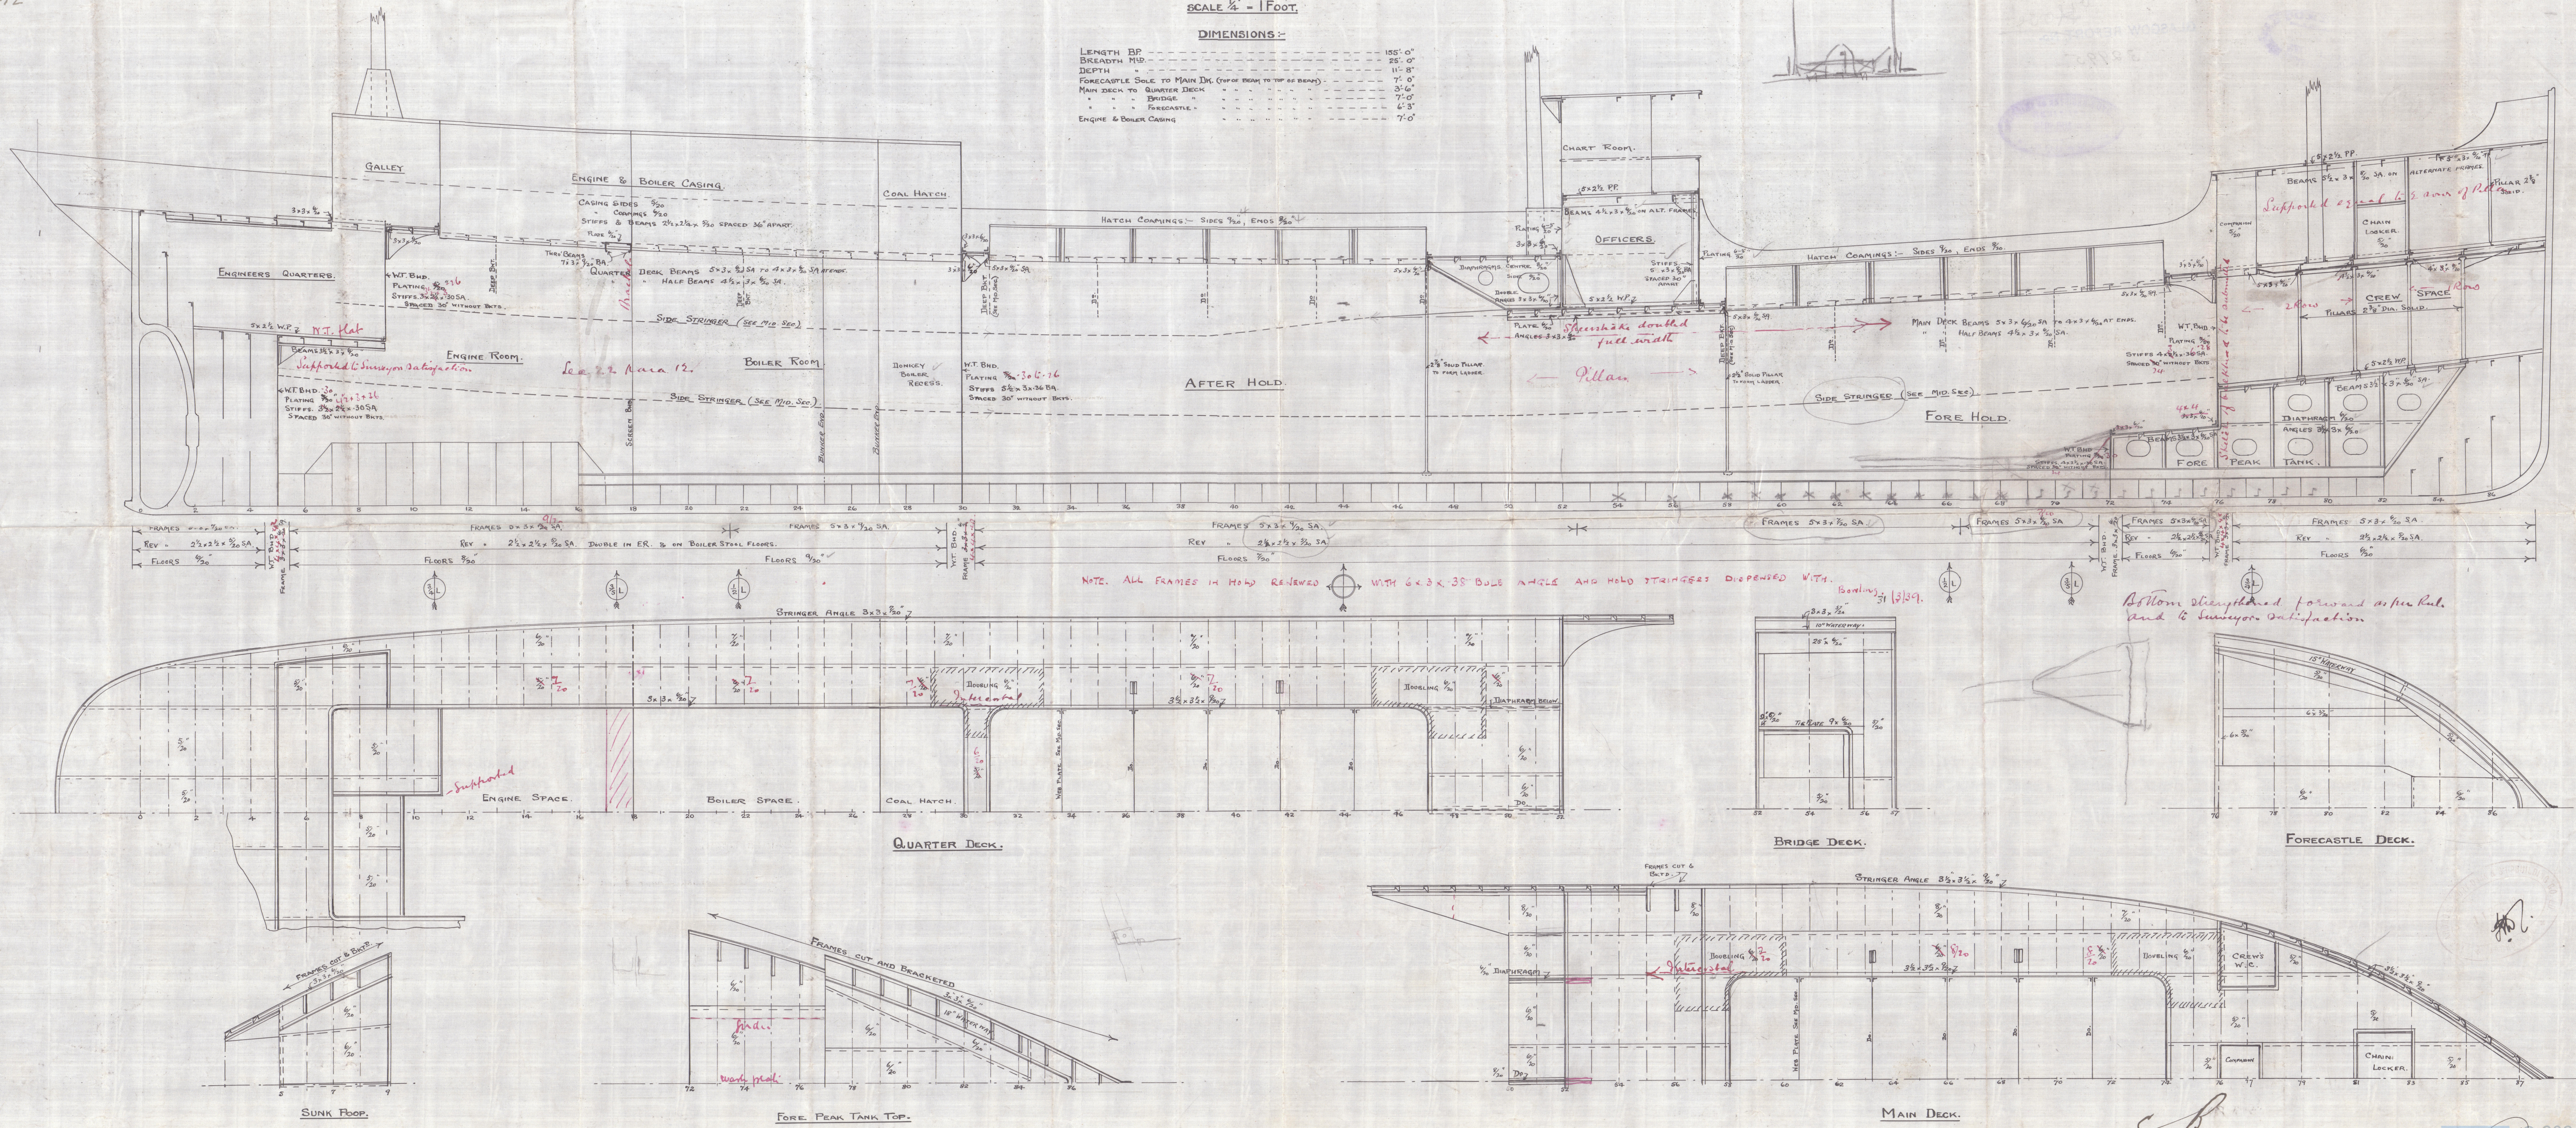

C.B.  
23.9.12.



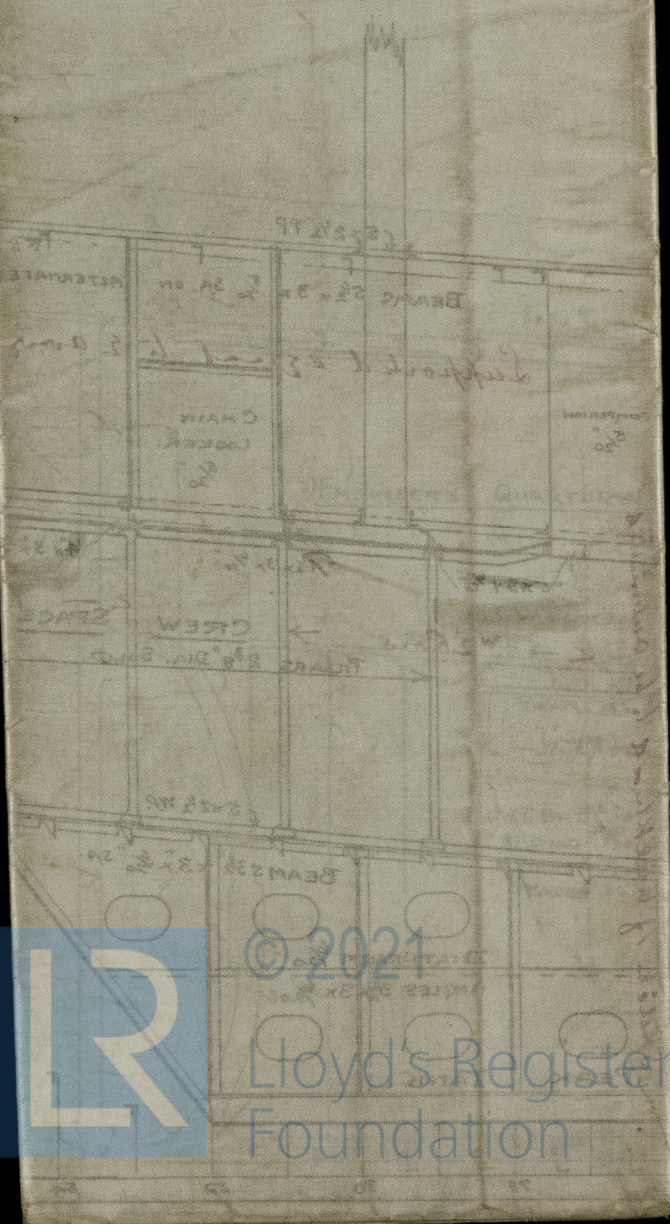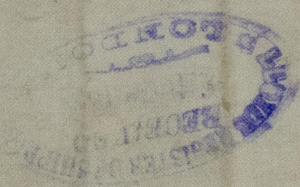

© 2021

Lloyd's Register  
Foundation

Profile & Decks  
And Stg. Cays  
253

"  
s/s Collairnie"  
Hove

GLASGOW REPORT No.

32995



© 2021

Lloyd's Register  
Foundation