


MID SECTION
SHOWING ALTERATIONS TO SEANTLINGS
MOTOR VESSEL "TERRA NOVA"

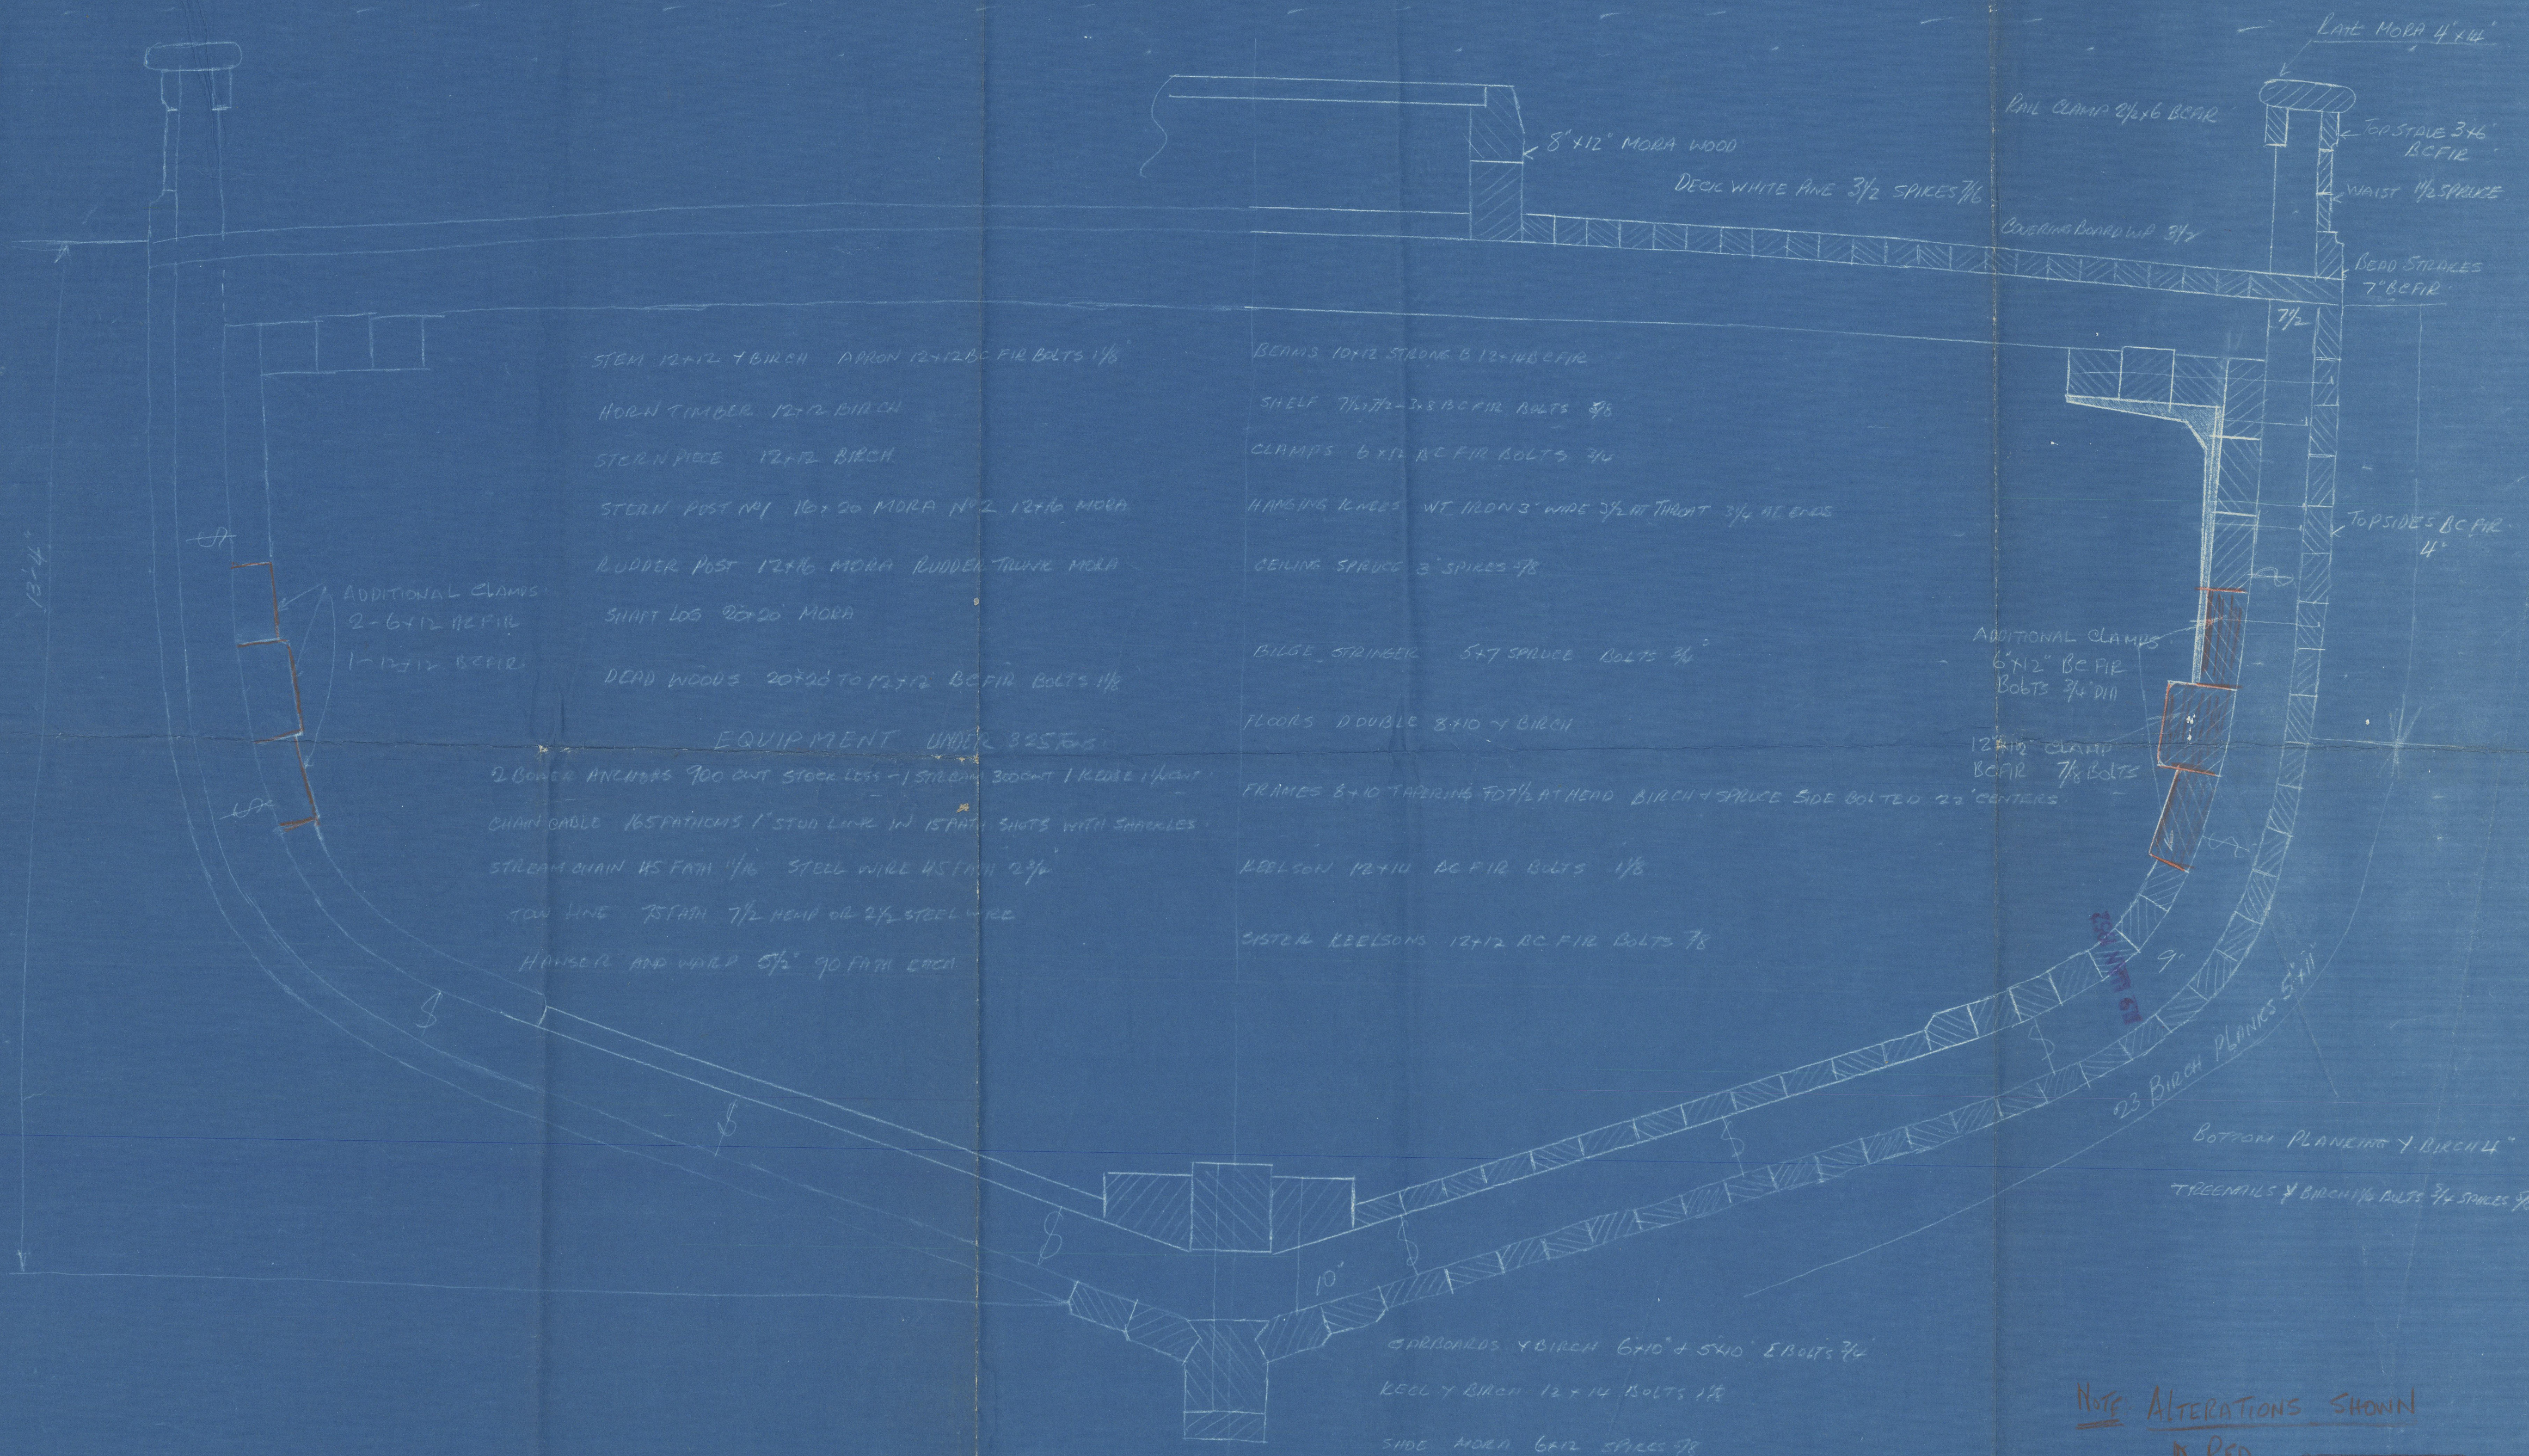

STEM 12x12 Y BIRCH APRON 12x12 BC FIR BOLTS 1 1/8"
HORN TIMBER 12x12 BIRCH
STERN PIECE 12x12 BIRCH
STERN POST NO. 1 16x20 MORA NO. 2 12x16 MORA
RUDDER POST 12x16 MORA RUDDER TRUNK MORA
SHAFT LOG 20x20 MORA
DEAD WOODS 20x20 TO 12x12 BC FIR BOLTS 1 1/8"

EQUIPMENT UNDER 325 TONS
2 BOWER ANCHORS 900 CWT STOCKLESS - 1 SPRING 300 CWT 1 KOWE 1/4 CWT
CHAIN CABLE 165 FATHOMS 1" STUD LINK IN 15 FATH SHOTS WITH SHACKLES
STREAM CHAIN 45 FATH 1 1/16" STEEL WIRE 45 FATH 2 3/4"
TOW LINE 75 FATH 7 1/2 HEMP OR 2 1/2" STEEL WIRE
HAWSEIL AND WARP 5 1/2" 90 FATH EACH

BEAMS 10x12 STANDING B 12x14 BC FIR
SHELF 7 1/2 x 7 1/2 - 3x8 BC FIR BOLTS 5/8"
CLAMPS 6x12 BC FIR BOLTS 3/4"
HANGING KNEES WT 110 LB 3' WIDE 3/4 AT THROAT 3/4 AT ENDS
CEILING SPRUCE 3' SPIRES 7/8"
BILGE STRINGER 5x7 SPRUCE BOLTS 3/4"
FLOORS DOUBLE 8x10 Y BIRCH
FRAMES 8x10 TAPERING TO 7 1/2 AT HEAD BIRCH & SPRUCE SIDE BOLTED 22" CENTERS
KEELSON 12x14 BC FIR BOLTS 1 1/8"
SISTER KEELSONS 12x12 BC FIR BOLTS 7/8"

RAIL CLAMP 2 1/2 x 6 BC FIR
8' x 12" MORA WOOD
DECK WHITE PINE 3 1/2 SPIRES 7/8"
COVERING BOARD WP 3 1/2"
LATE MORA 4' x 14"
TOP STAKE 3 1/2' BC FIR
WAIST 1 1/2" SPRUCE
HEAD STRAKES 7" BC FIR
7 1/2"
TOP SIDES BC FIR 4"
ADDITIONAL CLAMPS 6' x 12" BC FIR BOLTS 3/4" DIA
12" x 12" CLAMP BC FIR 7/8" BOLTS
23 BIRCH PLANKS 5' x 11"
BOTTOM PLANKING Y BIRCH 4"
TREENAILS Y BIRCH 1 1/4" BOLTS 3/4" SPIRES 7/8"

SPRBOARD Y BIRCH 6' x 10" + 5' x 10" E BOLTS 7/8"
KEEL Y BIRCH 12 x 14 BOLTS 1 1/8"
SIDE MORA 6' x 12 SPIRES 7/8"

NOTE: ALTERATIONS SHOWN
IN RED.

APPROVED
MAY 5 1951
REG. REGISTER OF SHIPPING
MONTREAL

1951
20/5/51

8595 of 18 on 18

003075-003082-0018

ALTERATIONS
Wood Vessel Terra Nova
BOWING BROTHERS LIMITED
56 JOHN'S MOUNTAIN