
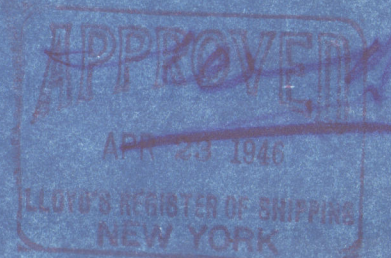


- MID SECTION -

- L.O.A. 140' - WL 130 - BP. 125' BEAM 28' MOULDED 27' 4" -

- DEPTH OF HOLD 12' 6" D. MOULD. 14' ROUD OF BEAM 8" DRAFT 11' 6" -

- DISP. 428 TONS -

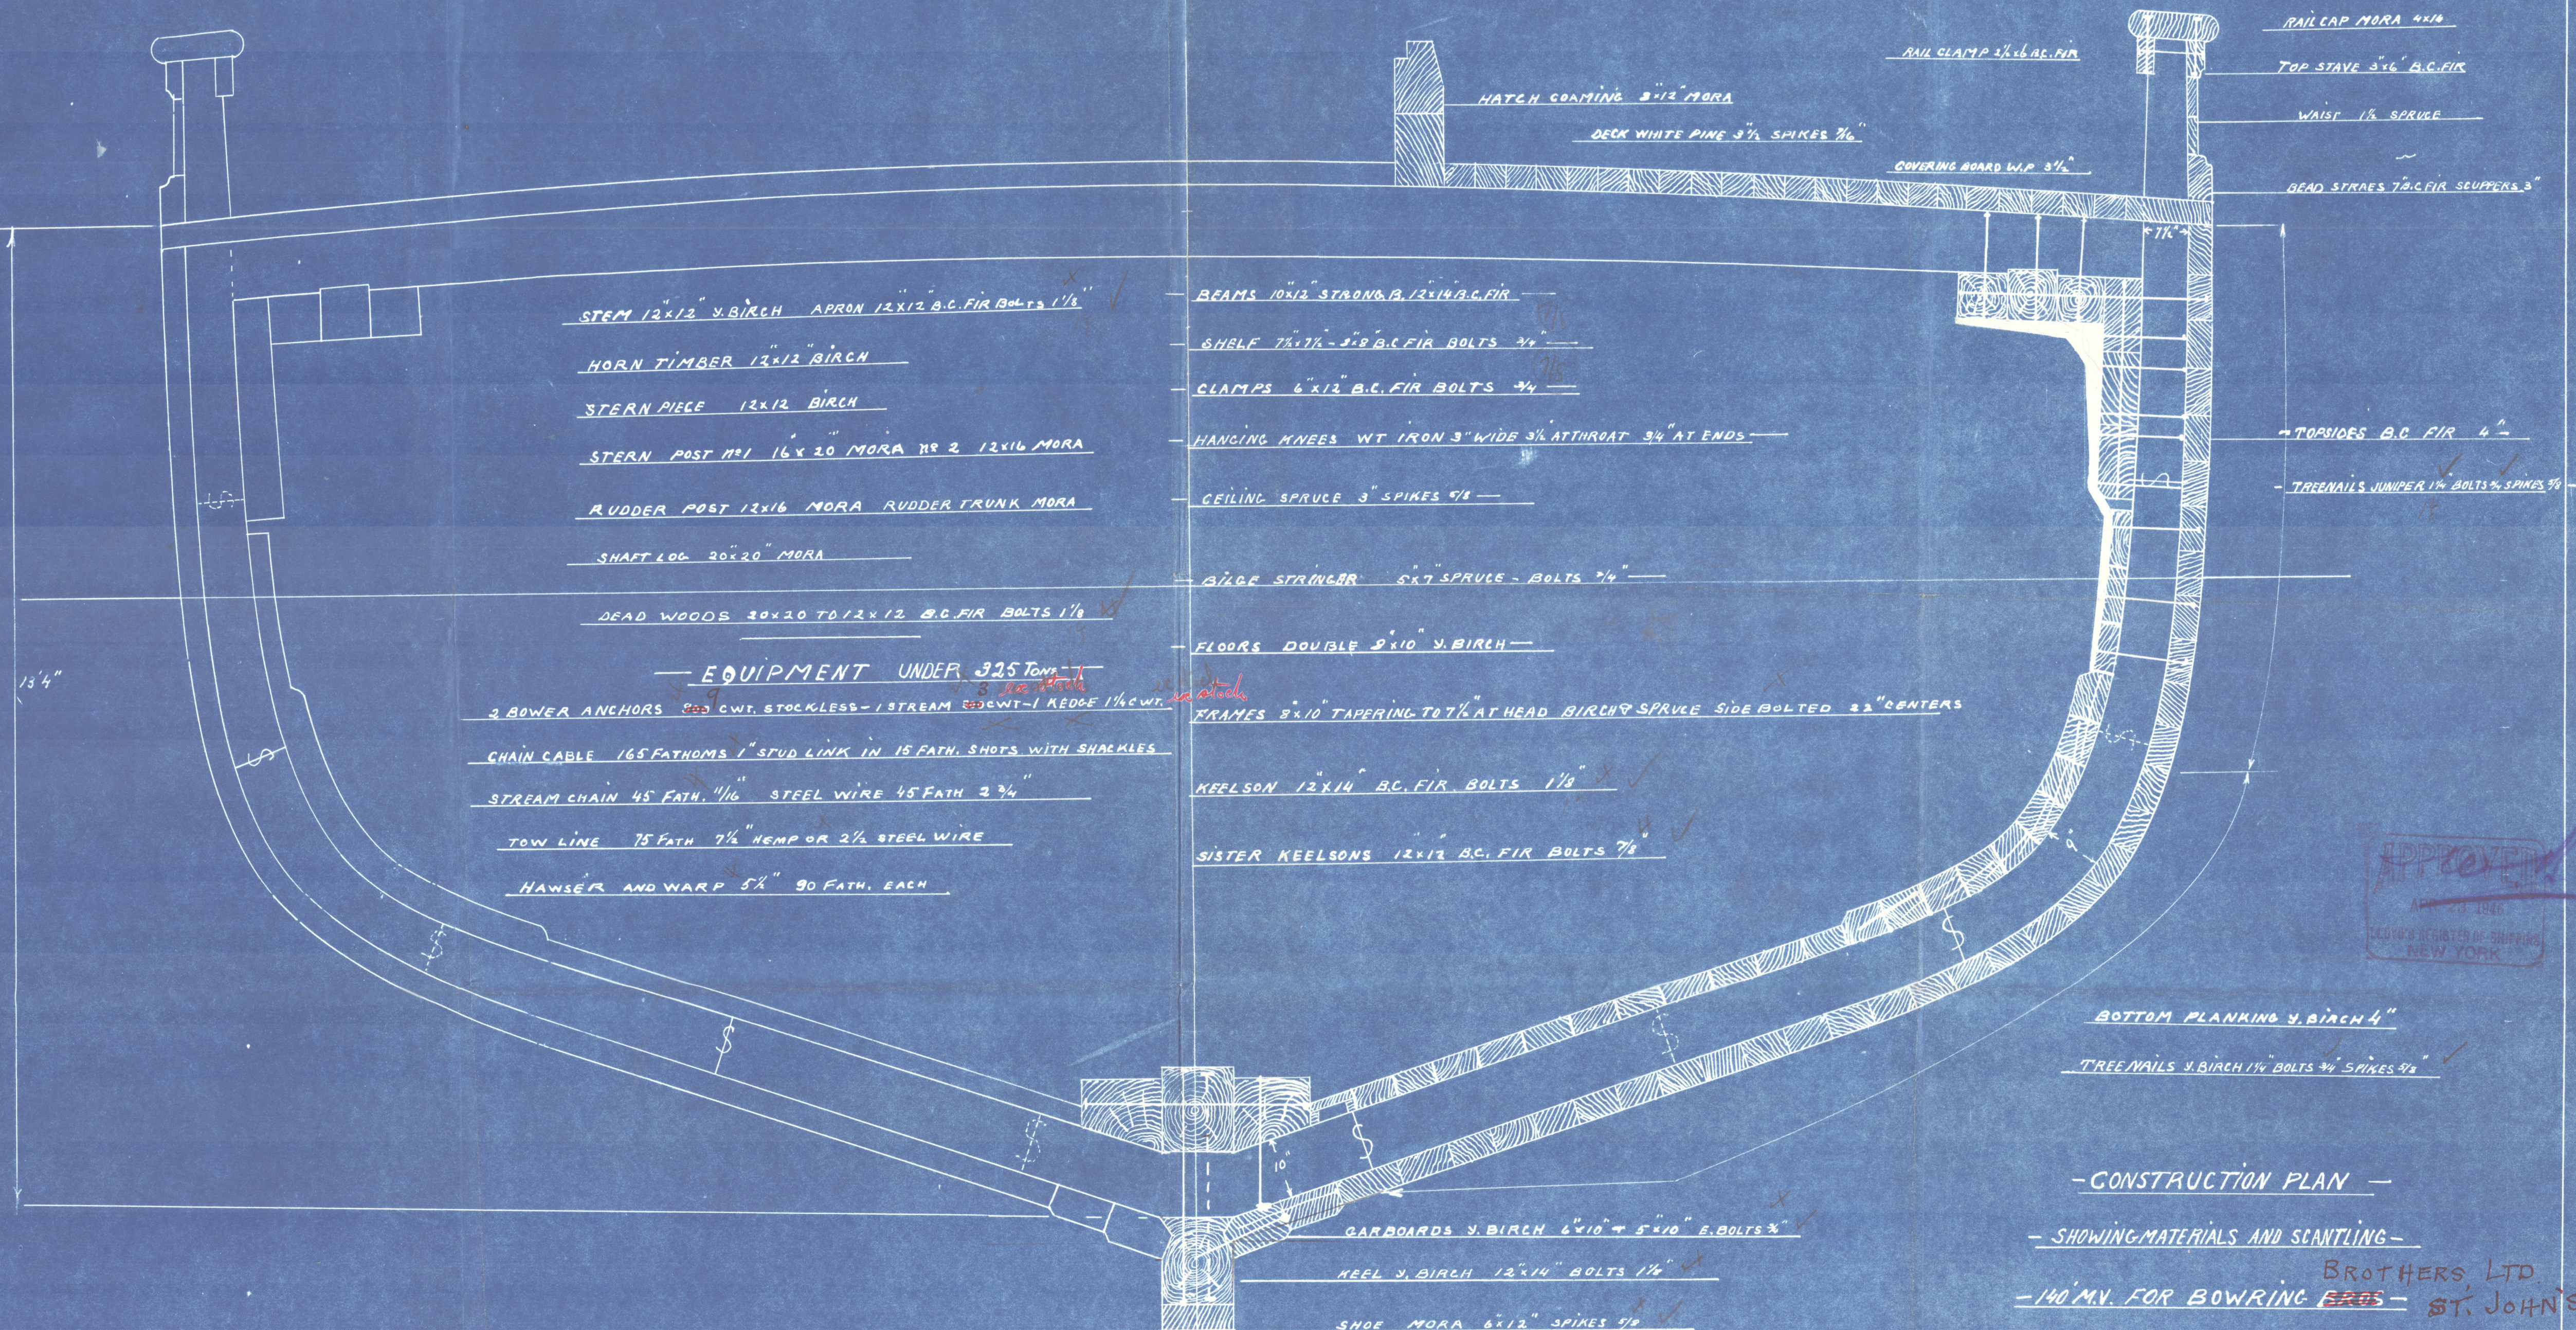



003075-003082-0021

RECORDS DEPT.,
LONDON

10

"TERRA NOVA" ★

J. H. W. STONE LTD. LTD.
WOODEN MOTOR SEALER

© 2020

MIDSHIP SECTION



Lloyd's Register
Foundation