

LLOYD'S REGISTER OF SHIPPING

UNITED WITH THE BRITISH CORPORATION REGISTER

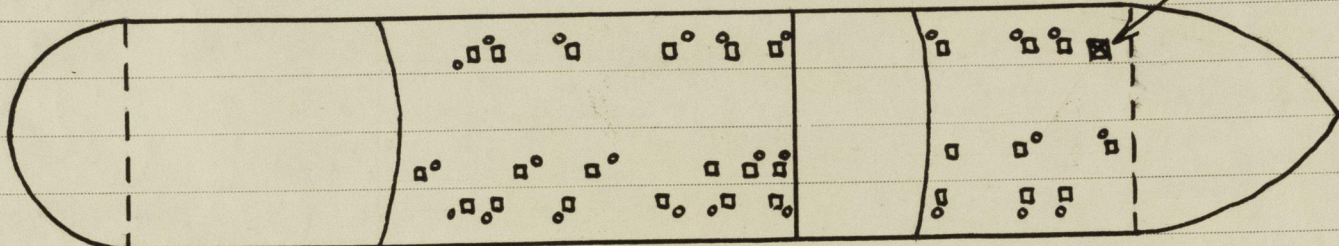
Ship's Name EACLESDALEOfficial No. 168248

Memorandum of alterations reported since ship was surveyed for assignment of Load Lines
in _____

Fitted at this timeHatch to emergency fire pump compartment shown thus: - ☒

Hatch 27"x27" with 30" high coaming .44" thick

Hinged steel cover .40" thick with 4 toggles

Noted at this time, but previously fitted + not shown on C11.Batterworth openings shown thus: - ☐

12" dia: cover of brass 1" thick: 10 studs

Existing + as shown on C11: cargo hatches shown thus: - ☒

R. Gerbitt Newcastle-on-Tyne

28 May 1954

Mr. Boulton

6 AUG 1954

Copy placed on board ship.