


SIDE TANK

BYGNING N^o 88

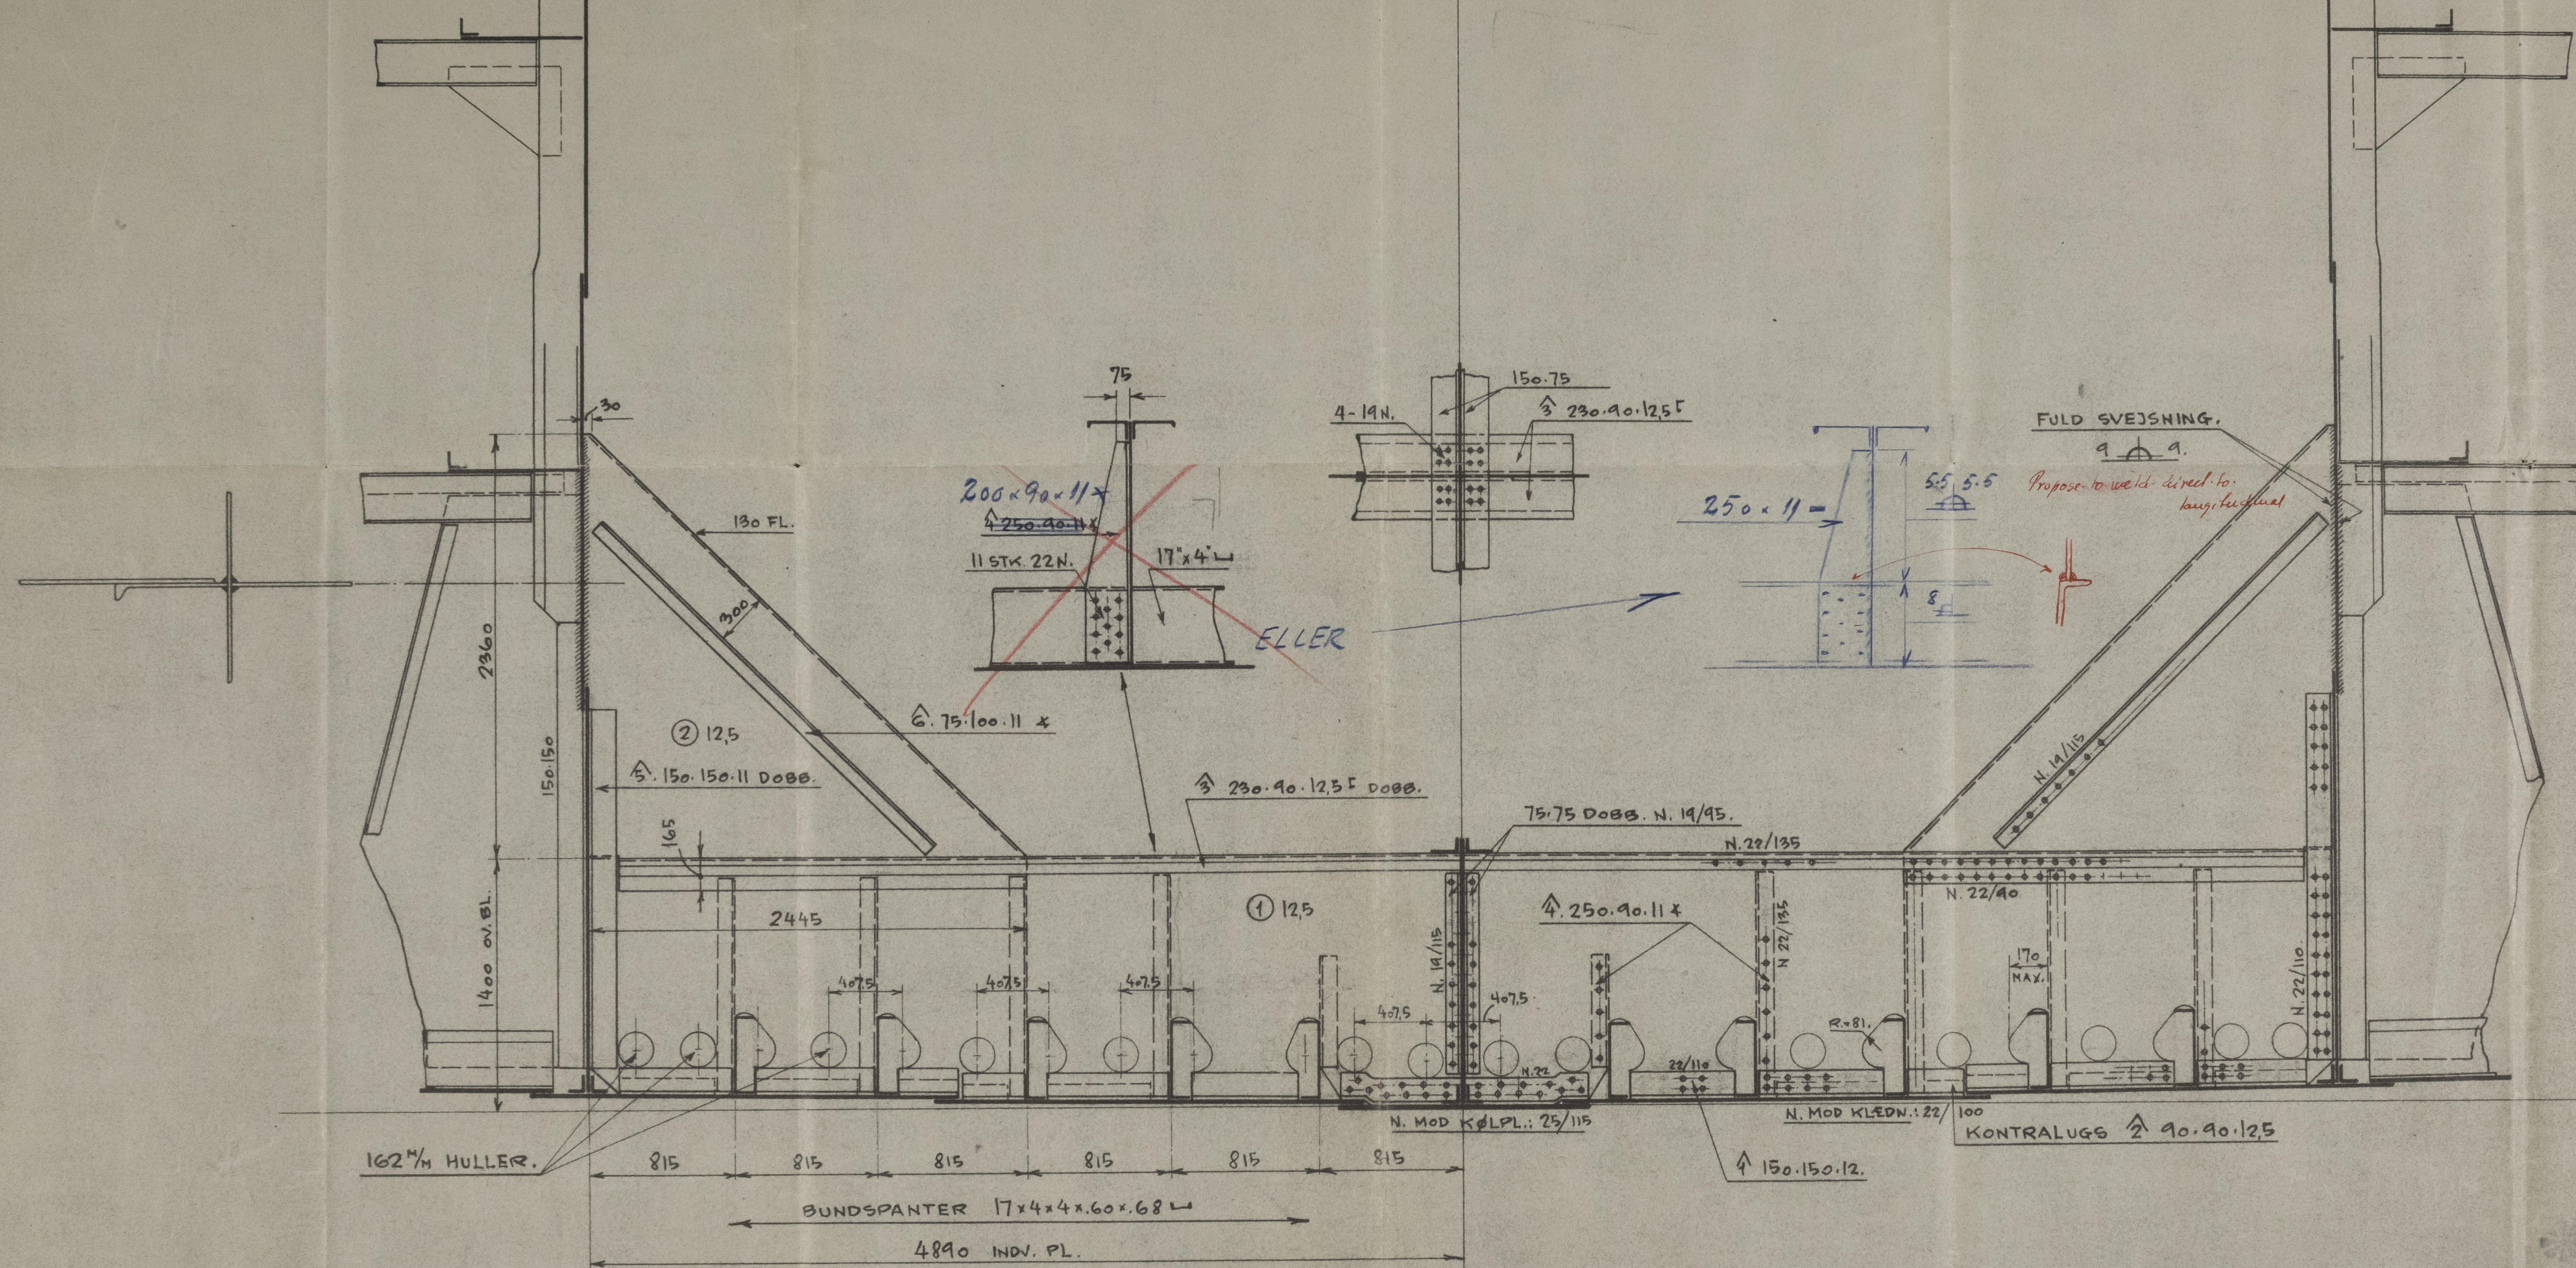

Alternative an^c of vertical
angles on both horizontal lines.

— yard 88 —


For J. H.

W. D.

10/6-4

ODENSE STAALSKIBSVÆRFT
VIA A. F. MØLLER



Alteration arrangement
of vertical angle bottom transv.
for.

Yard No. 88.

Odense Staalskibsverft



Mrs. Katrine Mørk of Fredericia
Copenhagen Report No. 11756

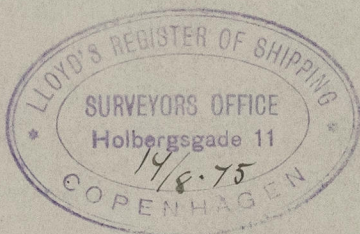

Only for Yard No. 88.



© 2020

Lloyd's Register
Foundation

003092-003099-0110