

YARD № 83-88.-PROFILE AND DECKPLANS — SCALE 1:100.

440-6602 00-2602 00

As built

Profile & Decks.


for

Yard No. 88.

Odense Staatskøbs værft ^{og}

Odense

* m/s. *Kabrine Marske* af Fredericia
Copenhague Report No. 117 ^{58.}

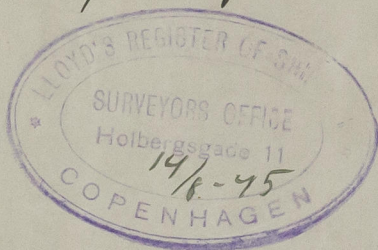

(H)



© 2020

Lloyd's Register
Foundation

003092-003099-0113