
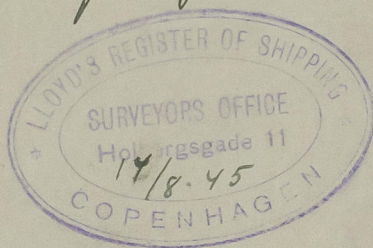


YARD N^o 88 - MIDSHIP SECTION - SCALE 1:25.

As built.
Machinery Section.
for.
Yard No. 88.
Oscar Steals kubo raft.

 M/s. Thabrie Mærsk.
of Fredericia
Copenhagen Ap. No. 11756.



①



© 2020

Lloyd's Register
Foundation

003092-003099-0115