"HELLENIC TRADER"

EX "CITY OF KEELUNG"

SURVEY 1947.

RECOMMENDATIONS IN YELLOW
CARRIED OUT FOR 1 YEAR CERTIFICATE

RECOMMENDATIONS IN RED
IN ADDITION TO YELLOW FOR
5 YEAR CERTIFICATE.

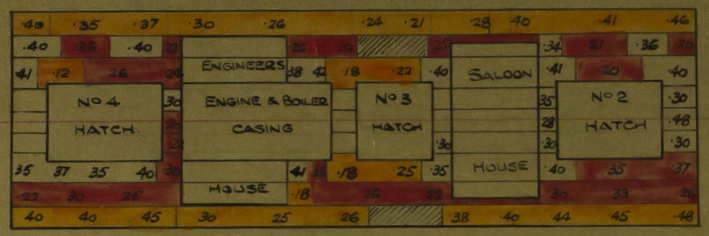

BRIDGE DECK

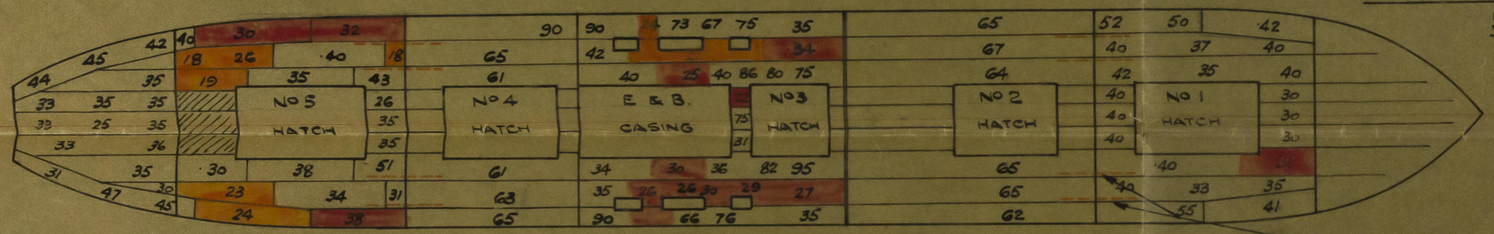

UPPER DECK

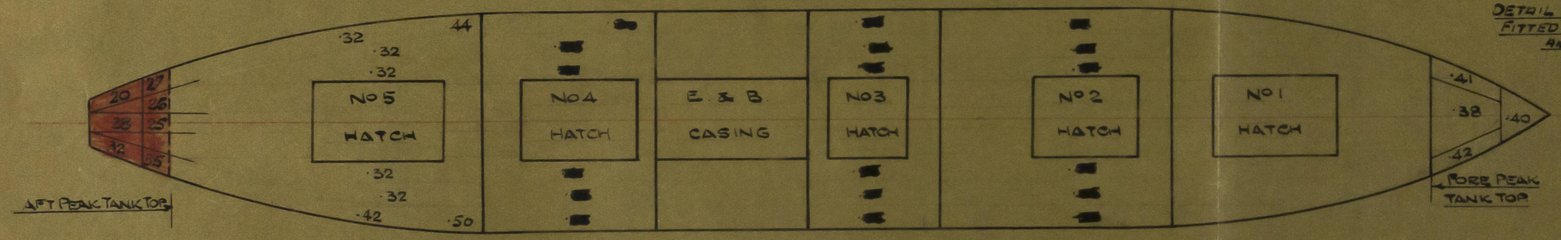

SECOND DECK

TANK TOP

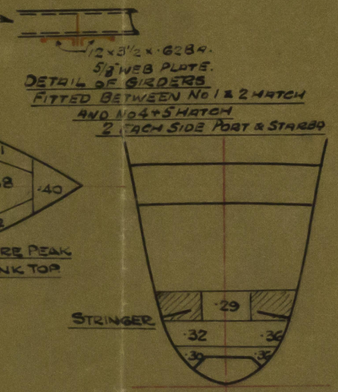

FORE PEAK D.H.
LOOKING FORD.

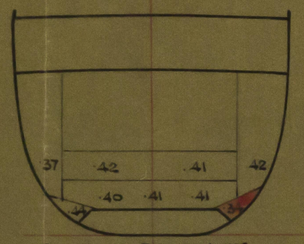

BULKHEAD BETWEEN Nos 1 & 2 HOLDS
LOOKING FORWARD.

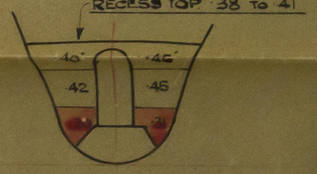

AFTER PEAK BULKD
LOOKING AFT

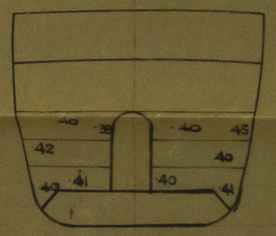

BULKD BETWEEN Nos 4 & 5 HOLD
LOOKING AFT.

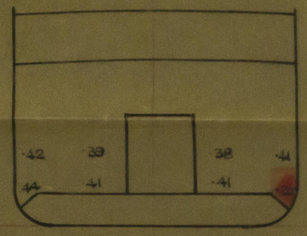

AFTER ENGINE ROOM BHD
LOOKING FORD

TUNNEL RECESS TOP	42 – 46
" " SIDES	40 – 50
" " FRONT	44 – 48

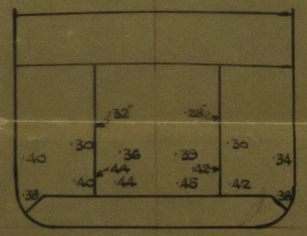

STOKEHOLD BHD
LOOKING AFT.

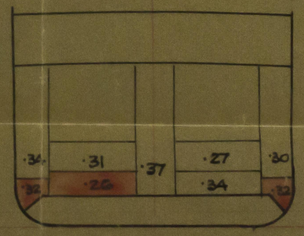

BULKHD BETWEEN Nos 2 & 3 HOLDS.
LOOKING FORWARD.

1/2 × 5 1/2 × 62 BR.
5/8" WEB PLATES.
DETAIL OF GIRDERS
FITTED BETWEEN No 1 & 2 HATCH
AND No 4 & 5 HATCH
2 EACH SIDE PORT & STARBD

SIDE SHELL DRILLINGS.

	P.	S.
SHEERSTRAKE (FORD OF POOP FRONT) 75 P.		
No 3 TWEEN DECK SPACE		
1ST STRAKE BELOW SHEER (FORD OF POOP BHD)	9/20	10/20
2ND " " " " " "	9/20	9/20
3RD " " " " " "	[illegible]	9/20
No 3 HOLD		
4TH " " " " " "	[illegible]	[illegible]
5TH " " " " " "	9/20	9/20
3RD " ABOVE BILGE (FORD OF TUNNEL RECESS)	9/20	8/20
2ND " " " " "	7/20	8/20
1ST " " " " "	10/20	8/20
No 3 UPPER TWEEN DECK SPACE		
SHEERSTRAKE (AFT END OF No 3 HATCH)	15/20	11/20
1ST STRAKE BELOW SHEER " ")	15/20	15/20
No 3 LOWER TWEEN DECK SPACE		
2ND " " "	12/20	11/20
3RD " " "	11/20	11/20
4TH " " "	10/20	10/20
No 3 HOLD		
3RD " ABOVE BILGE (FORD OF SIDE BUNKER BHD)	8/20	8/20
2ND " " " " " "	10/20	10/20
1ST " " " " " "	12/20	11/20
No 1 TWEEN DECK SPACE		
SHEERSTRAKE (AFT OF F.P. BULKHEAD)	11/20	11/20
1ST STRAKE BELOW SHEER " ")	10/20	9/20
2ND " " " ")	9/20	9/20
No 1 HOLD.		
3RD " " " " " ")	9/20	8/20
4TH " " " " " ")	[illegible]	9/20
5TH " " " " " ")	10/20	8/20
6TH " " " " " ")	7/20	7/20
7TH " " " " " ")	8/20	DOUBLED.

NOTE BOTTOM SHELL AND BILGE UP TO LIGHT LOAD LINE TO BE DRILLED.

© 2020 Lloyd's Register Foundation