


979 Nov 1948  
7-11-48

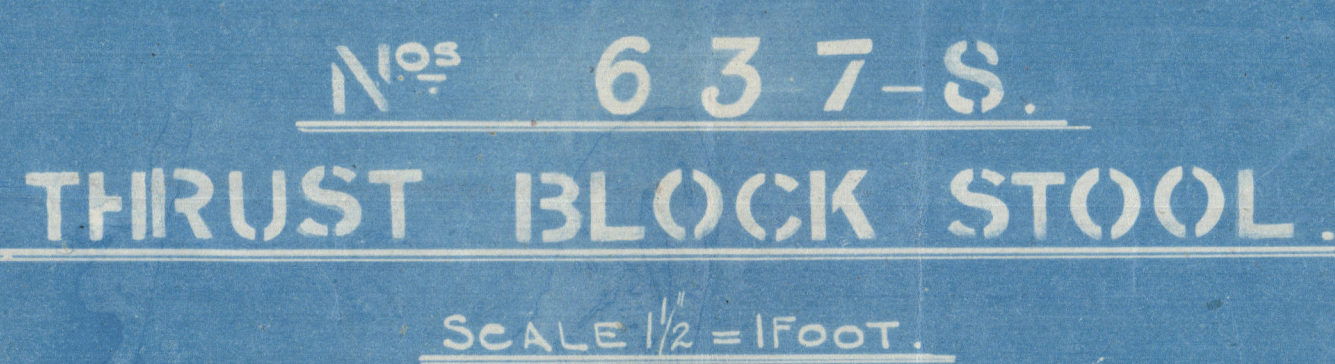



~~Arabistan~~  
~~Turkistan~~  
Spartan Prince

Urbino

Keelung NOW HELLENIC TRADER.

Sahor

Steel Cybers

Thrust Block Stools

Earle's 634-8  
Sto B

Washed by 1.

Machinery.

Messrs Earle's No 634. 638 "B"

Thrust Block Stools



April 11. 18.

Lloyd's Register  
Foundation

003092-003099-0158