


PROFILE & DECK PLANS
S.S. NICHIAN MARU
DIM'S 400' BP x 52 MLD x 31' MLD
SCALE 1/8" = 1'-0"

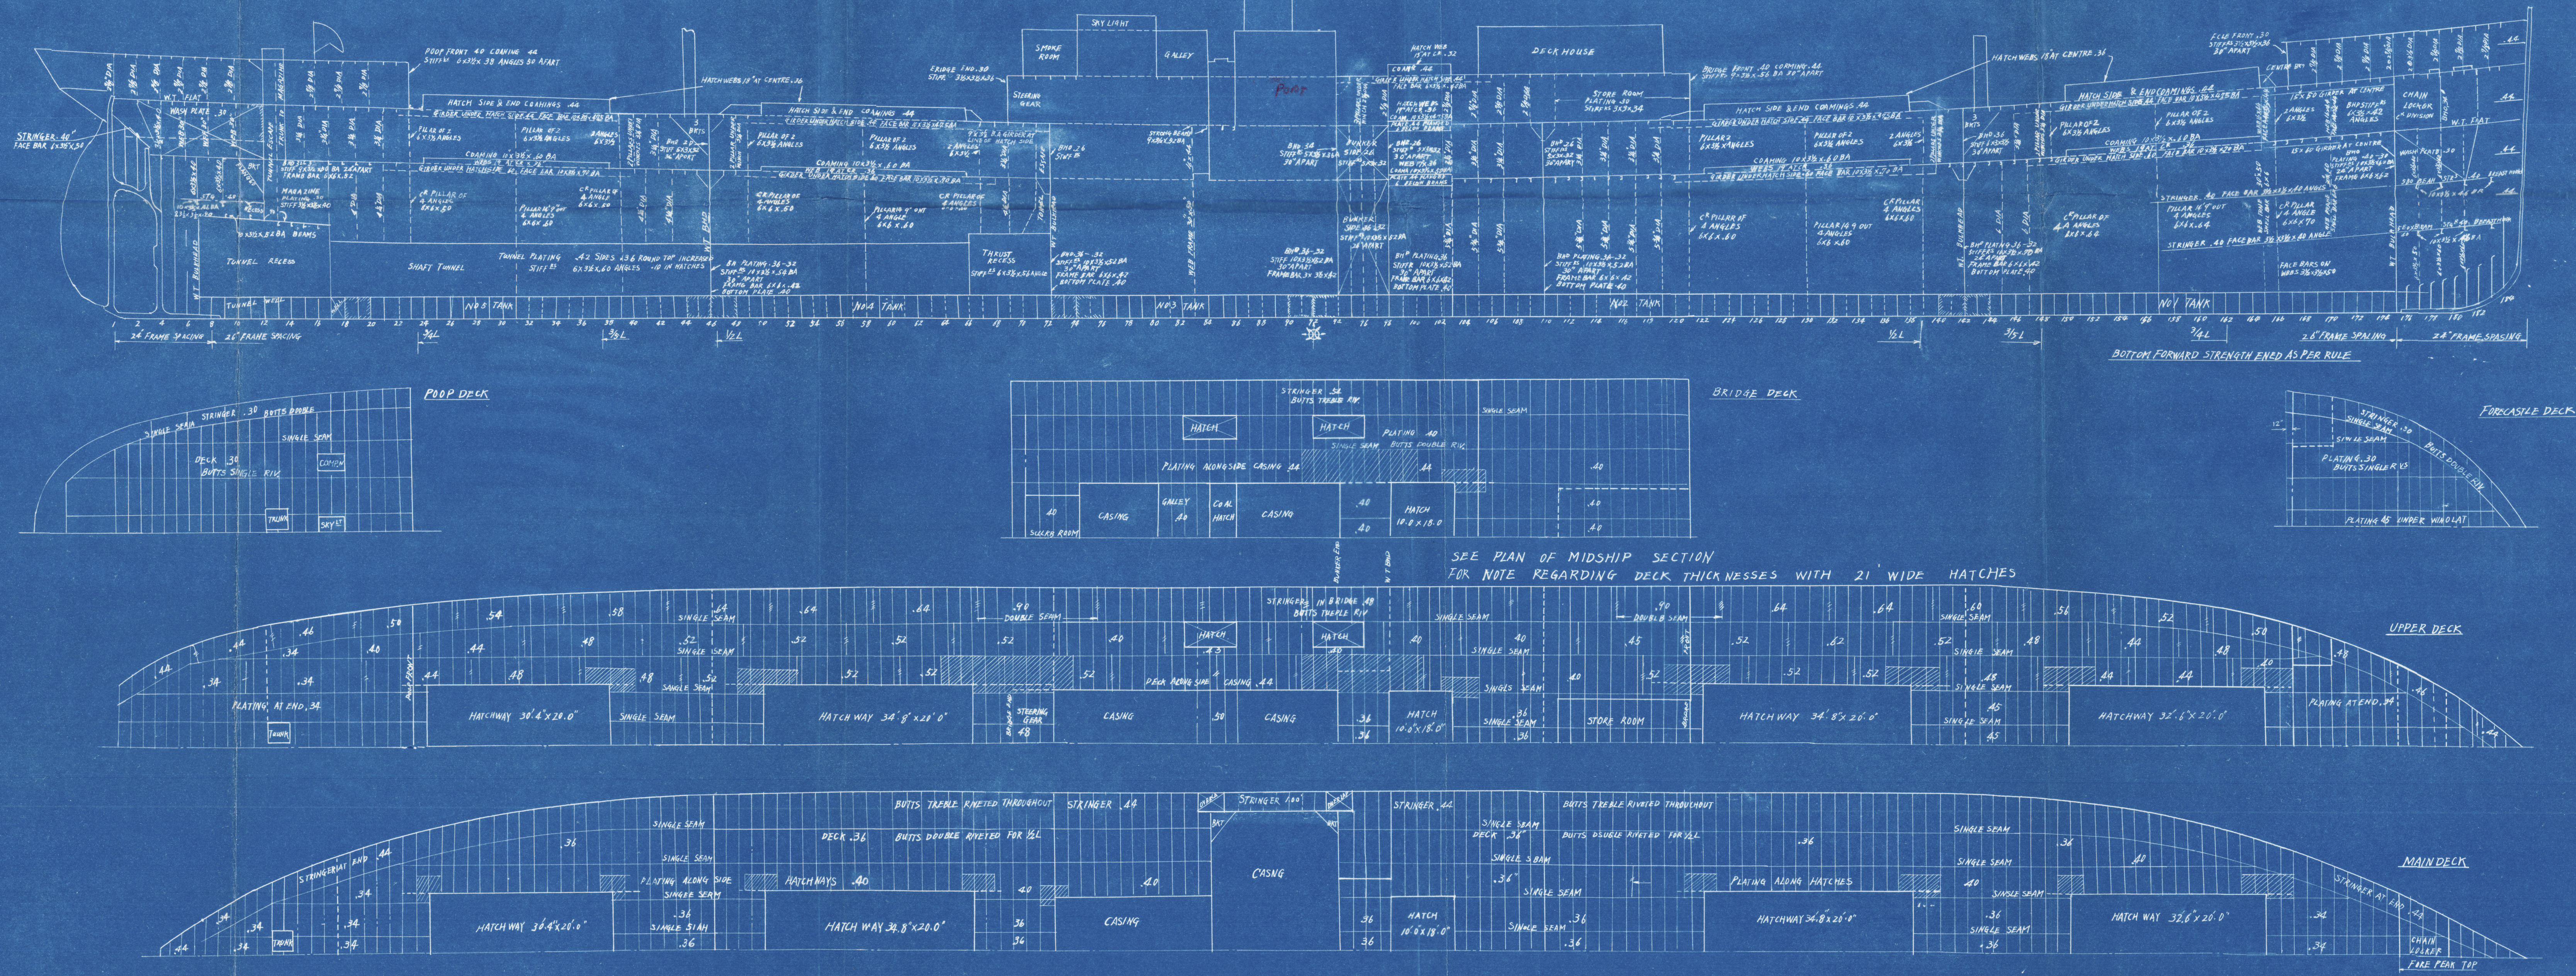

NICHIAN MARU

CONSTRUCTION PROFILE

SCALE 1" TO 12'-0"
DRAWN BY
TRACED BY
CHECKED BY

DATE
APPROVED BY

NIPPON STEEL TUBE CO.
ASANO DOCK YARD


JOB NO. DR. NO. B-2090

APPROVED BY

FOR REFERENCE

Noted
27-2-56



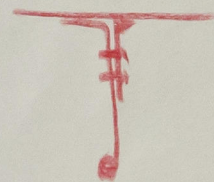

(19)

SS/ 18 NICHIAN MARU	
This Certificate	
Accompanies YOKOHAMA	
REPORT	No. <u>1894</u>
Date	



© 2020

Lloyd's Register
Foundation

003092-003099-0162

FEB 23 1900

Construction Profile
"Nichian Maru,"



© 2020

Lloyd's Register
Foundation

003092-003099-0162