

27 SEP 1945

Lloyd's Register of Shipping.

Ship's Name

Ardgantock

Official No. 142271

Memorandum of alterations reported since ship was surveyed for assignment of Load Lines
in


The crew's accommodation in the forecabin has now been removed to a new house built on the casing top aft and the new arrangement of the forecabin is as shown in the sketch below.

The openings in the fore bulkhead are as follows —

2 wood doors & 1 steel door, operated from both sides.

Tonnage opening 5' x 4', 15" sill with ~~shifting~~^{storm} boards in welded channels. A hatchway to the fore peak store has been constructed as shown, measuring 3'-0" x 2'-10" with 4" x 3" bulb angle coaming.

Wood covers 2 1/2" thick with 2 1/2" bearing surface are fitted and cleats, battens & 2 tarpaulins are provided.

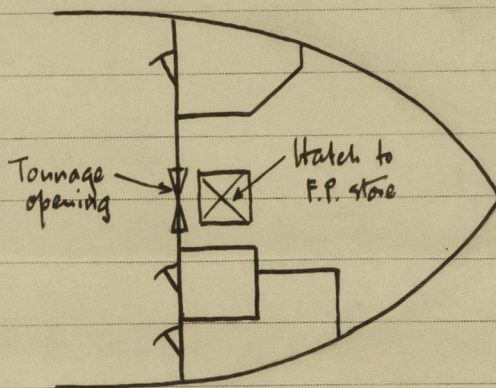

R. G. Welch

Greenock

26th Sept. 1945.

Noted
HJ
28.9.45



© 2020

Lloyd's Register
Foundation