

— MIDSHIP SECTION —

STEEL SCREW STEAMER N<sup>o</sup> 147.

SCALE  $\frac{1}{2}$  : ONE FOOT

CLASS 100 A.I. \*

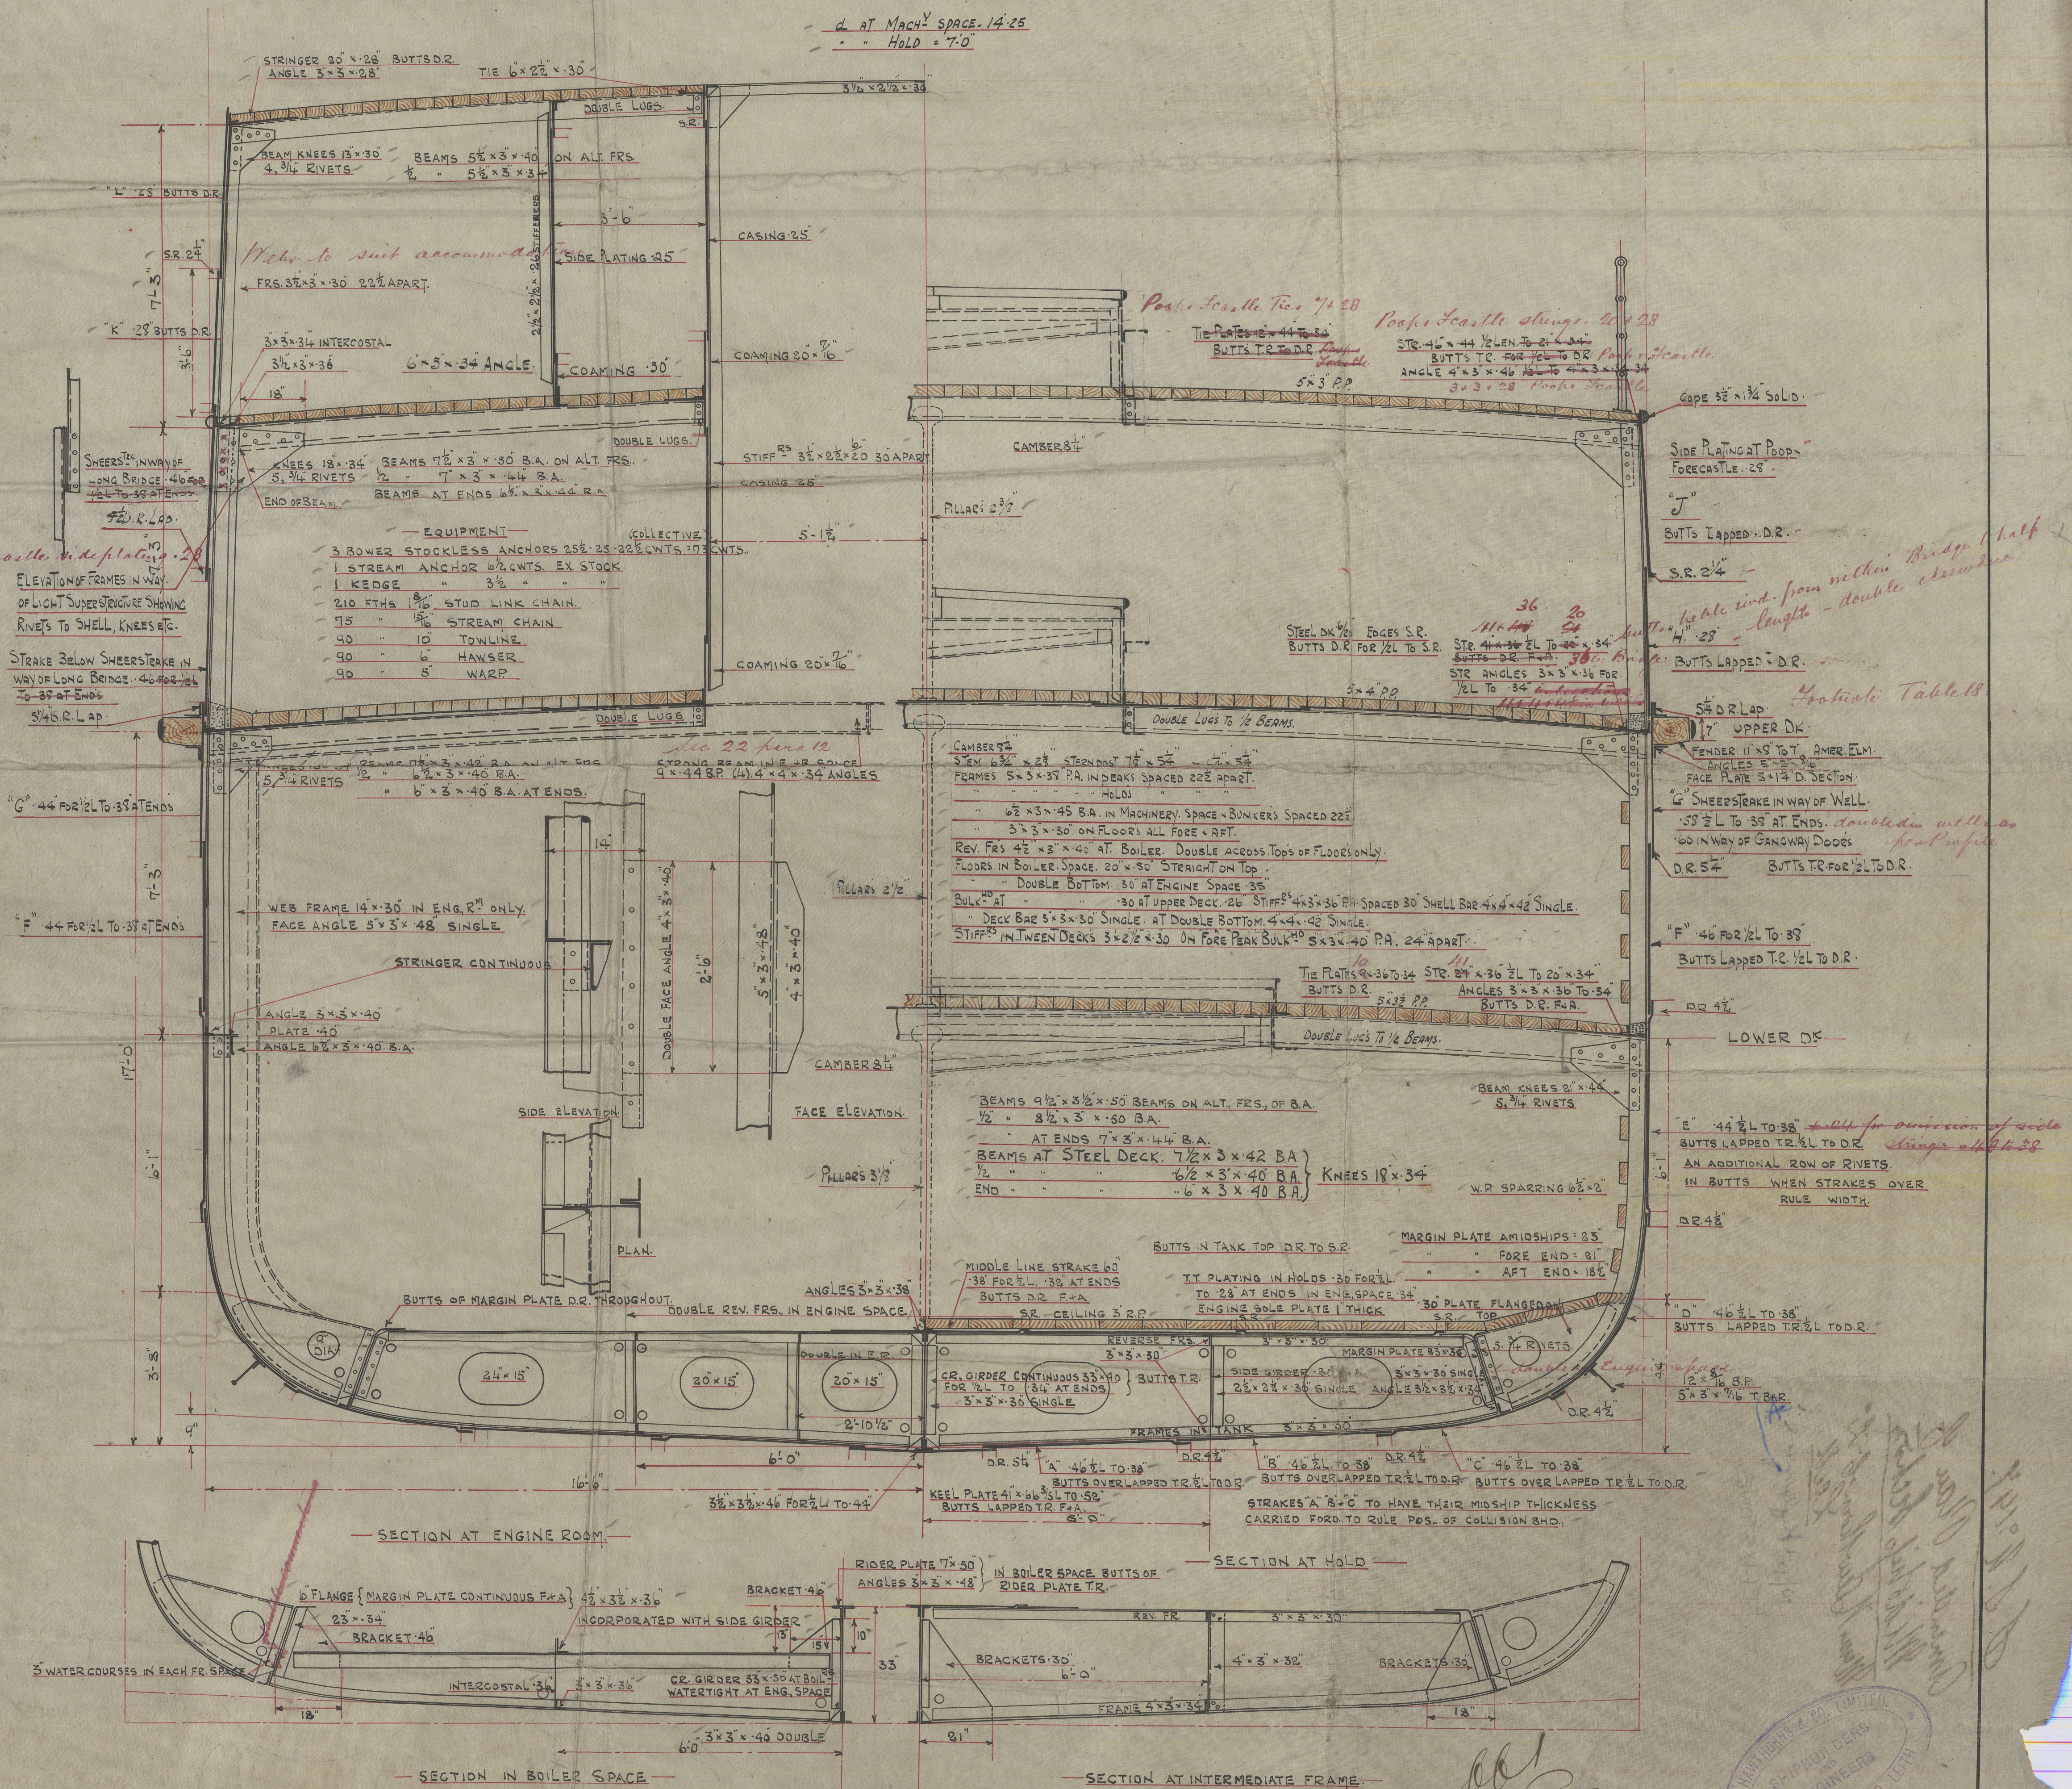
## PROPORTIONS

d. AT MACH<sup>y</sup> SPACE - 14.25  
" " HOLD = 7.0"

EQUIPMENT NO

LLOYDS 2 <sup>ND</sup> MD	10750
ADDITION FOR POOP	266.25
" " BRIDGE	346.50
" " FORESLT	315.00
" " SUPERSTRUCTURE	<del>306.50</del> 326
	<u>11993.75</u>
	12003

LLOYDS NUMERALS

$$\begin{array}{r} 33 \\ 17 \\ \hline 50 = 1^{\text{st}} \text{ No} \\ 215 \\ \hline 250 \\ 50 \\ \hline 100 \\ \hline 10,750 = 2^{\text{nd}} \text{ No} \end{array}$$


31.7.17.

© 2020

Lloyd's R

Lloyd S. F.

Foundat



S.S. 144

Amended Plan of  
Midship Section

Wm. Newthorn & Co  
Leith

"N/11 Rydamore"  
"FELIXSTOWE"

REGISTERED  
RECEIVED  
23 JUL 1907  
LONDON



© 2020

Lloyd's Register  
Foundation

003106-003115-0067