


Steel & Screw
15'-6" x 8'-10" x 13'-0"


20.6.13

PROFILE & DECK PLAN
STEEL SCREW TRAWLERS
N^o 5584
DIM^s 121'-8" P. x 22'-0" E. x 13'-0" M. L. D.
SCALE 1/4" INCH

PLAN No. 3752
FOR ENCLOSURE TO
Messrs Lloyd's Surveyors
Hull
FROM
DATE 22/12/13

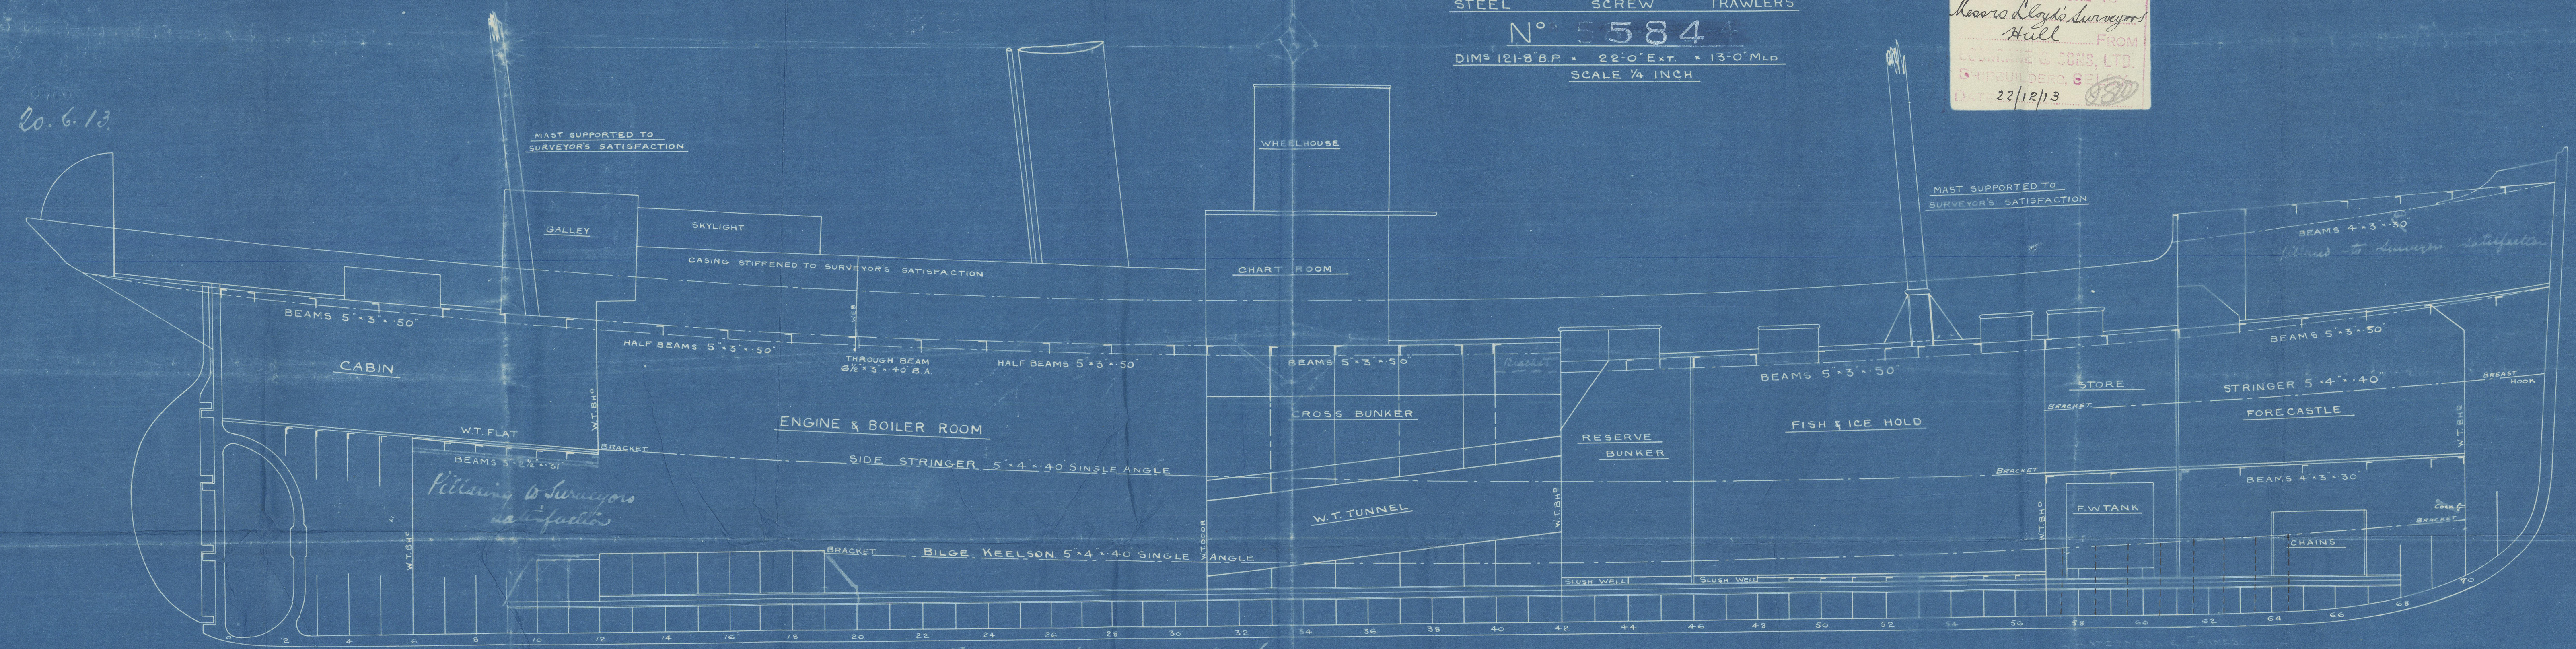

Pillaring throughout to Surveyors satisfaction

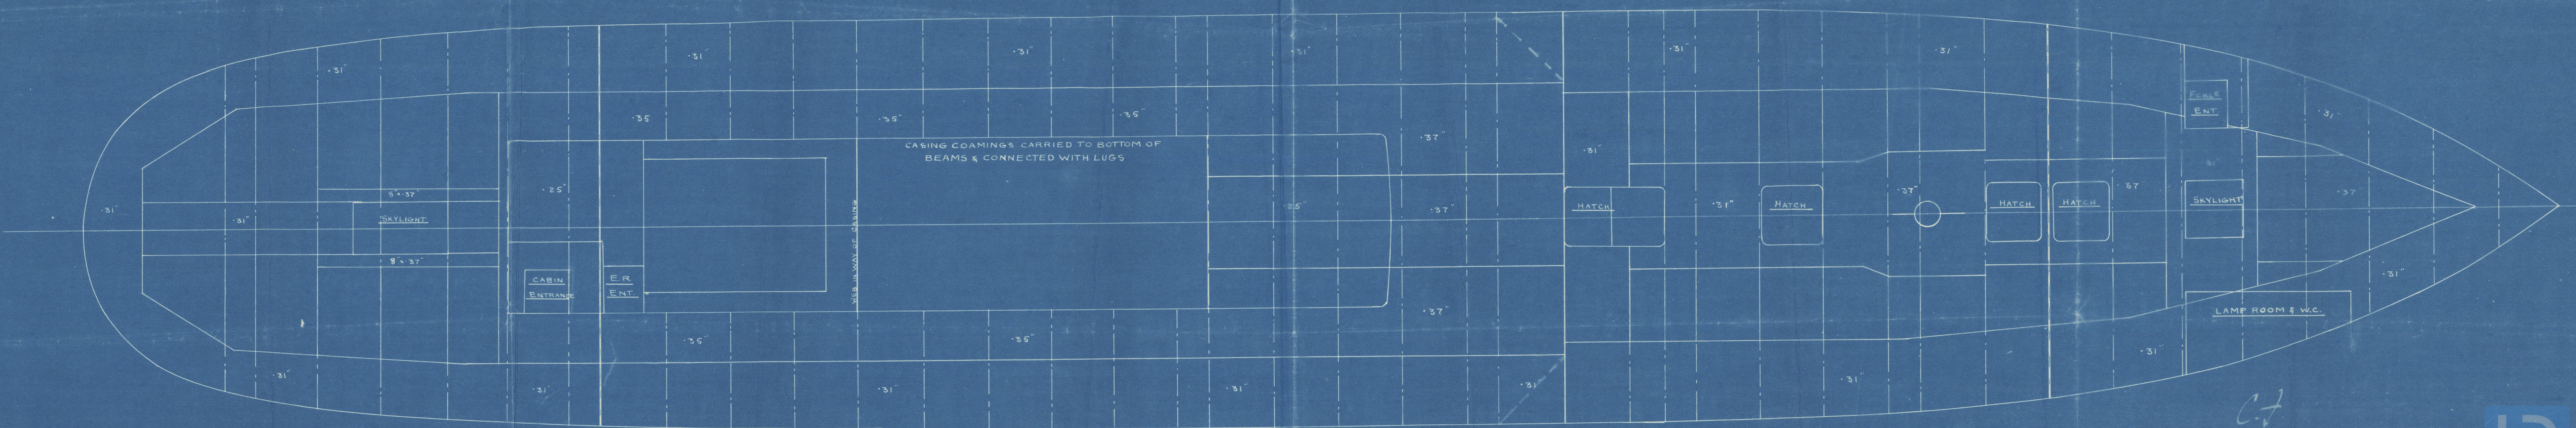

C.T.
20/6/13

Cochrane & Jones
Nos 581. 582. 583. 584.

Duplicate.

Profile and Decks.

s/s "Jacinth"

Hull Rpt No. 27271



© 2020

Lloyd's Register
Foundation

003106-003115-0097