

20.6.13.

MIDSHIP SECTION

N^o 5842334

STEEL SCREW TRAWLERS


DIMS 121'-8" BP x 12'-0" ET x 13'-0" ML

SCALE 1/2" INCH = 1 FOOT

TO CLASS 100 A1 LLOYDS STEAM TRAWLER

DECK PLATED OVER IN WAY OF
MACHINERY SPACE E. & B. CASING
AS PREVIOUSLY APPROVED

PLAN No. 3785
FOR ENCLOSURE TO
Messrs Lloyd's Surveyors
Hull FROM
COCHRANE & SONS, LTD.
SHIPBUILDERS, 37, N. Y.
22/12/13

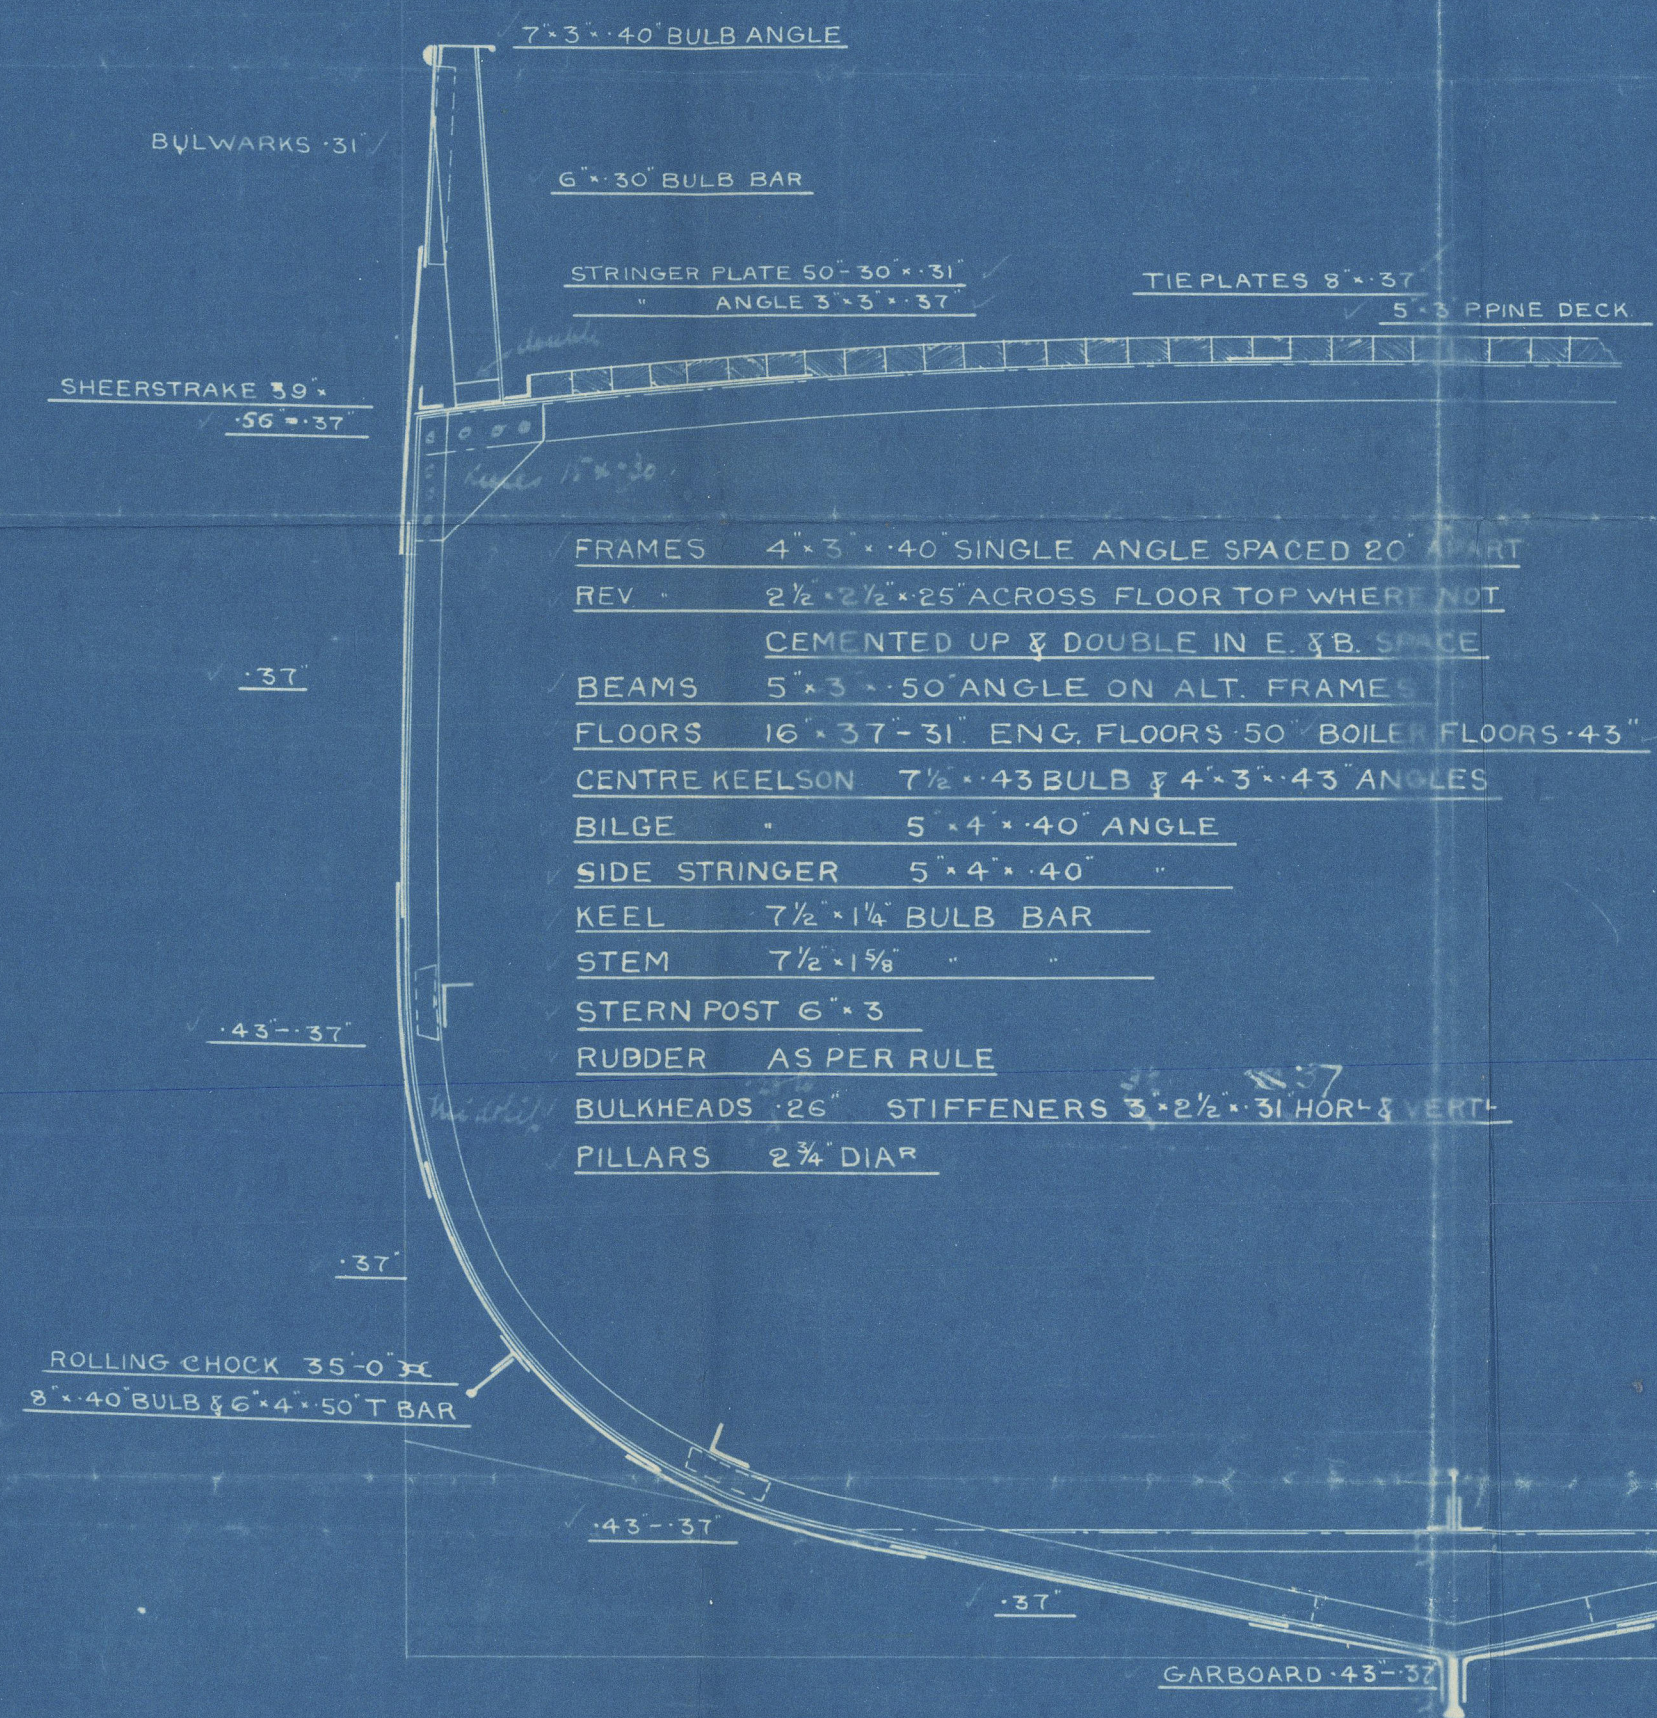

NUMERALS

B-D --- --- 34.85
L (B-D) --- --- 4239.85

PROPORTIONS

5 --- --- 9.35
5 --- --- 5.56

EQUIPMENT

1 ST BOWER ANCHOR	5 1/4 CWTs EX STOCK
2 ND " "	4 3/4 " " "
KEDGE " "	2 1/2 " " "
90 FATHOMS	1" CABLE
60 " "	6" HAWSER
60 " "	4 1/2" WARP

RIVETING

LANDINGS DOUBLE RIVETED BULWARKS SINGLE RIVETED
BUTTS TO BE LAPPED & DOUBLE RIVETED EXCEPT GARBOARD
& SHEERSTRAKE WHICH ARE TO BE STRAPPED & DOUBLE
RIVETED

4 1/2' x 6' 8" c. 5822.1825
Cochrane & Sons Ltd
15.1.14 x 22.1.14 x 22.1.14

C.F.
20/6/13


Cochrane & Sons. Ltd.
Nos 581, 582, 583, 584

Dupliant...

Midship Section.

s/s "Jacinth"

Hull Rpt No. 27271

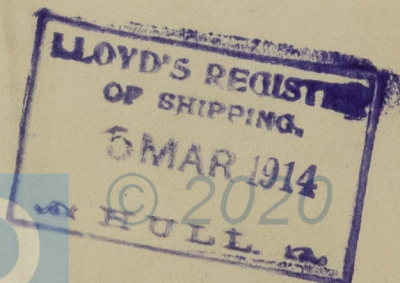

003106-003115-0098

Lloyd's Register
Foundation