

GOVT. COPY ISSUED


OWNERS' C.11 ISSUED

3/4/49
3/4/49
Lloyd's Register of Shipping.
SURVEYS FOR FREEBOARD.
(CONDITIONS OF ASSIGNMENT.)

3-AUG-49

Ship's Name BRITISH PROGRESS Port of Survey GLASGOW
 Official Number 182916 Surveyor's Signature Geo. Lockburn
 Nationality and Port of Registry BRITISH LONDON Date of Survey WHILST BUILDING

Disposition and dimensions of superstructures, trunks, deckhouses and machinery casings to be inserted in the diagrams and tabular statement:—

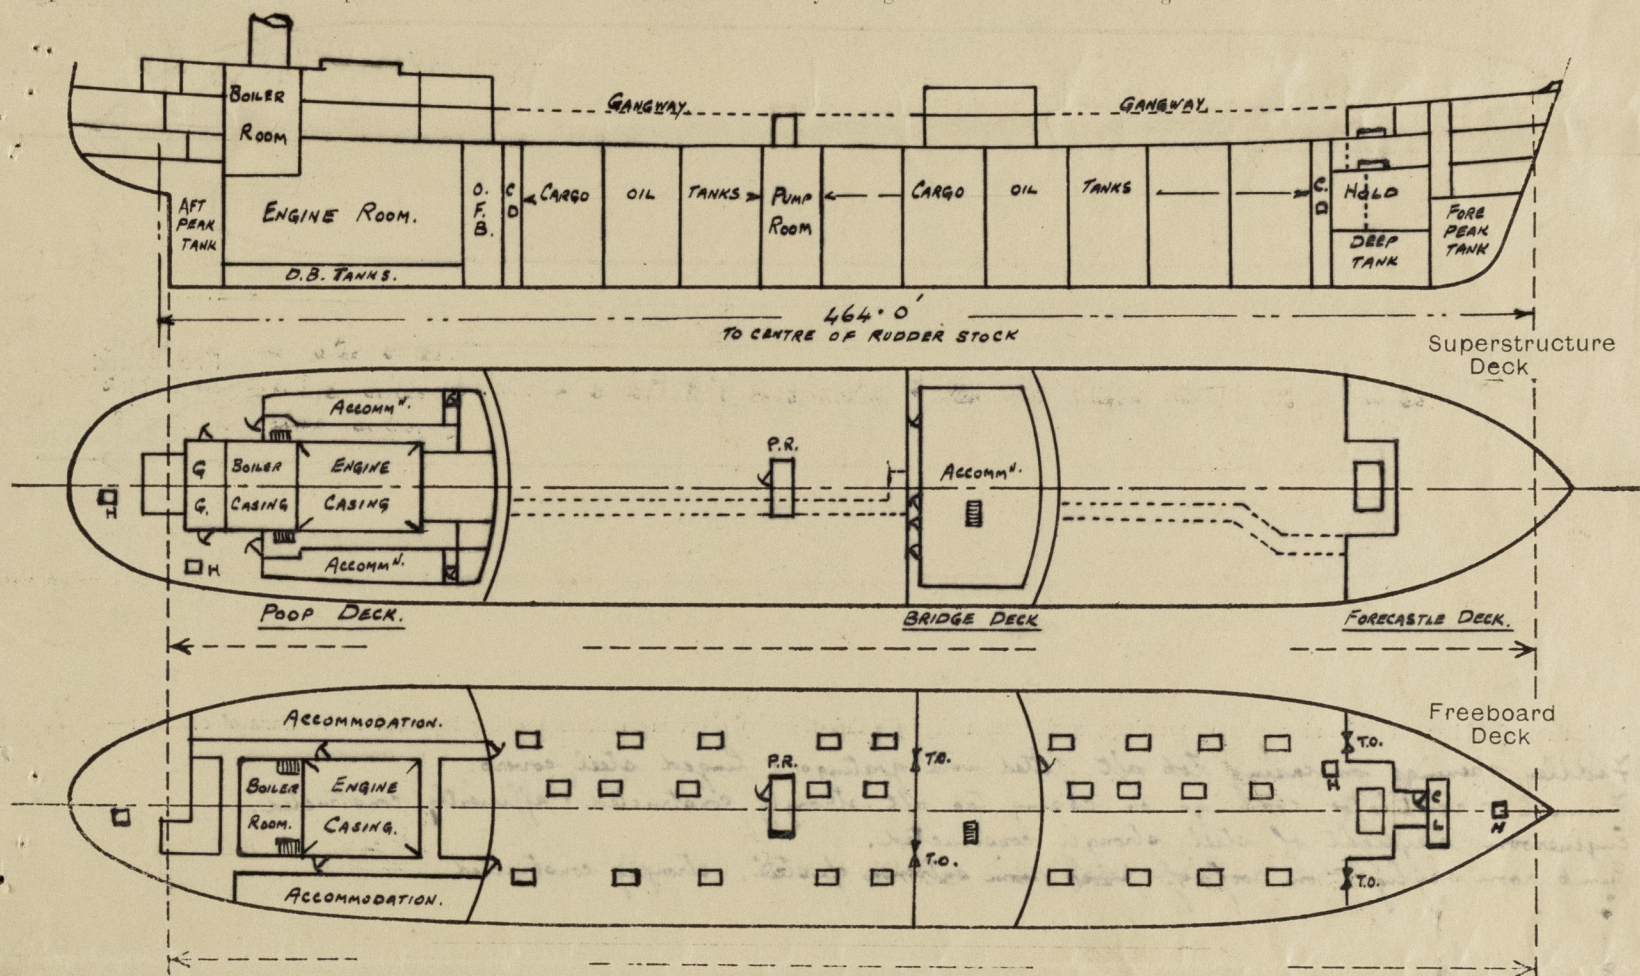

Particulars of Superstructures, Trunks, Casings, Deckhouses.

	Coaming	Plating	Stiffeners	Spacing	End Attachments of Stiffeners	Size of Openings	Height of Sills	Height of Casings
Poop Bulkhead ...	44"	44"	9" x 3 1/2" x 46 O.A. E.W. TOE ON	30"	E.W. TOP + BOTTOM	2 AT 5'-0" x 3'-0"	18"	8'-0"
Raised Quarter Deck Bulkhead ...	-	-	-	-	-	-	-	-
Bridge, After Bulkhead ...	30"	30"	4" x 1/16" FLAT E.W.	30"	E.W. TOP + BOTTOM	2 AT 4'-1" x 3'-1"	19"	8'-0"
Bridge, Forward Bulkhead ...	44"	44"	9" x 3 1/2" x 46 O.A. E.W. TOE ON	30"	E.W. TOP + BOTTOM	1 AT 5'-0" x 3'-0"	18"	8'-0"
Forecastle Bulkhead ...	30"	30"	4" x 3" x 32 O.A. E.W. TOE ON	30"	E.W. TOP + BOTTOM	2 AT 4'-1" x 3'-1" 1 AT 4'-3" x 2'-3"	18"	8'-0"
Trunk, Aft ...	-	-	-	-	-	-	-	-
Trunk, Forward ...	-	-	-	-	-	-	-	-
Exposed Machinery Casings on Freeboard or Raised Quarter Decks ...	-	-	-	-	-	-	-	-
Exposed Machinery Casings on Superstructure Decks ...	30"	30"	3" x 5/16" FLAT E.W.	30"	BKTS. TO BEAMS	2 AT 4'-3" x 2'-3"	18"	8'-3 1/2"
Machinery Casings within Superstructures not fitted with Class 1 Closing Appliances ...	-	-	-	-	-	-	-	-
PUMP ROOM ENTRANCE Deckhouses on Flush Deck Ships ...	40"	40"	4" x 3" x 36" O.A. E.W. TOE ON	24/30"	E.W. TOP + BOTTOM	1 AT 4'-3" x 2'-3"	24"	7'-6"

Particulars of Closing Appliances (state if capable of being manipulated from both sides).

Poop Bulkhead ...	HINGED STEEL WATERTIGHT DOORS OPERATED BOTH SIDES
Raised Quarter Deck Bulkhead ...	-
Bridge, After Bulkhead ...	STORMBOARDS IN WELDED CHANNELS & PORTABLE PLATES SECURED BY HOOK BOLTS.
Bridge, Forward Bulkhead ...	HINGED STEEL WATERTIGHT DOOR OPERATED BOTH SIDES.
Forecastle Bulkhead ...	1 HINGED STEEL WATERTIGHT DOOR OPERATED BOTH SIDES; STORMBOARDS IN E.W. CHANNELS & PORTABLE PLATES SECURED BY HOOK BOLTS.
Exposed Machinery Casings on Freeboard or Raised Quarter Decks ...	-
Exposed Machinery Casings on Superstructure Decks ...	HINGED STEEL WATERTIGHT DOORS OPERATED BOTH SIDES.
Machinery Casings within Superstructures not fitted with Class 1 Closing Appliances ...	-
PUMP ROOM ENTRANCE Deckhouses on Flush Deck Ships ...	HINGED STEEL WATERTIGHT DOOR OPERATED BOTH SIDES.

PARTICULARS OF PROTECTION TO OPENINGS, ETC.

HATCHWAYS ON FREEBOARD AND SUPERSTRUCTURE DECKS.										POOP DECK	
UPPER DECK.											
Description of Hatchway	FORE HOLD.	CARGO TANKS	FORE PEAK STORE	FORWARD TWEEN DECK	FORWARD PUMP ROOM.	OIL FUEL BUNKERS	COFFER DAMS & SETTLING TANKS	STERN COMPARTMENT.	POOP SPACE.
Dimensions of Hatchway	6'-9" x 10'-0"	27' OFF. 6'-0" x 4'-0"	3'-0" x 3'-0"	2'-6" x 2'-0"	3'-0" x 3'-0"	2' OFF 3'-0" x 3'-0"	10' OFF 23" x 18"	2'-6" x 2'-6"	2'-9" x 2'-9"
COAMINGS	Height above Deck	...	30"	12"	9"	9"	36"	36"	MANHOLES 12" x 50" OR E.W. TBE ON.	18"	18 1/2"
	Thickness	{ Sides	44	50	50	50	50	50		50	50
		{ Ends	44	50	50	50	50	50		50	50
	Stiffeners	...	-	-	-	-	-	-	-	-	-
	Brackets, Stays	...	-	-	-	-	-	-	-	-	-
HATCH BEAMS	Number	...									
	Spacing	...									
	Scantling and Sketch	...	← NONE →							← NONE →	
	Bearing Surface	...									
FORE AND AFTERS	Number	...	5'-0"								
	Spacing	...	6'-9"								
	Unsupported Lengths	...									
	Scantling* and Sketch	...									
	Bearing Surface	...	3 1/2"								
HATCH COVERS	Material	...	STEEL	STEEL	STEEL	STEEL	STEEL	STEEL	STEEL	STEEL	WOOD
	Thickness	...	60	64	50	50	50	50	40	50	2 1/2
	How fitted	...	W.T.	O.T.	W.T.	W.T.	W.T.	O.T.	BOLTED O.T.	W.T.	F & A.
	Bearing Surface	...	-	-	-	-	-	-	-	-	2 1/2
Spacing of Cleats	TOGGLES	TOGGLES	TOGGLES	TOGGLES	TOGGLES	TOGGLES	BOLTS	TOGGLES	2 PER SIDE.
Number of Tarpaulins...	14-16 APART.	14-16 APART.	17-18 APART.	15-18 APART.	18 APART.	17-20 APART.	3 1/2' APART	12' APART	2


*Are wood fore and afters steel shod at all bearing surfaces? YES

Are battens and wedges efficient and in good condition? YES

Are tarpaulins in good condition and in accordance with rule requirements? YES

Are lashings provided in accordance with rule requirements? YES

Particulars of any special features :—

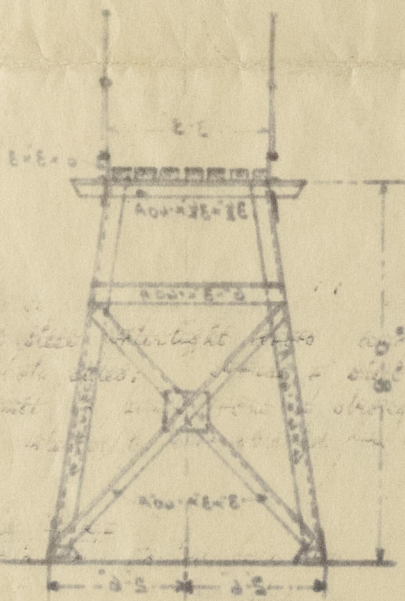[illegible]


8-6" dia. core to horizontal 30" - 36"
to 6" 30" - 36"

1711

1. 6. 10. 11. 12. 

[illegible]

© 2020

Lloyd's Register
Foundation