




26.6.07

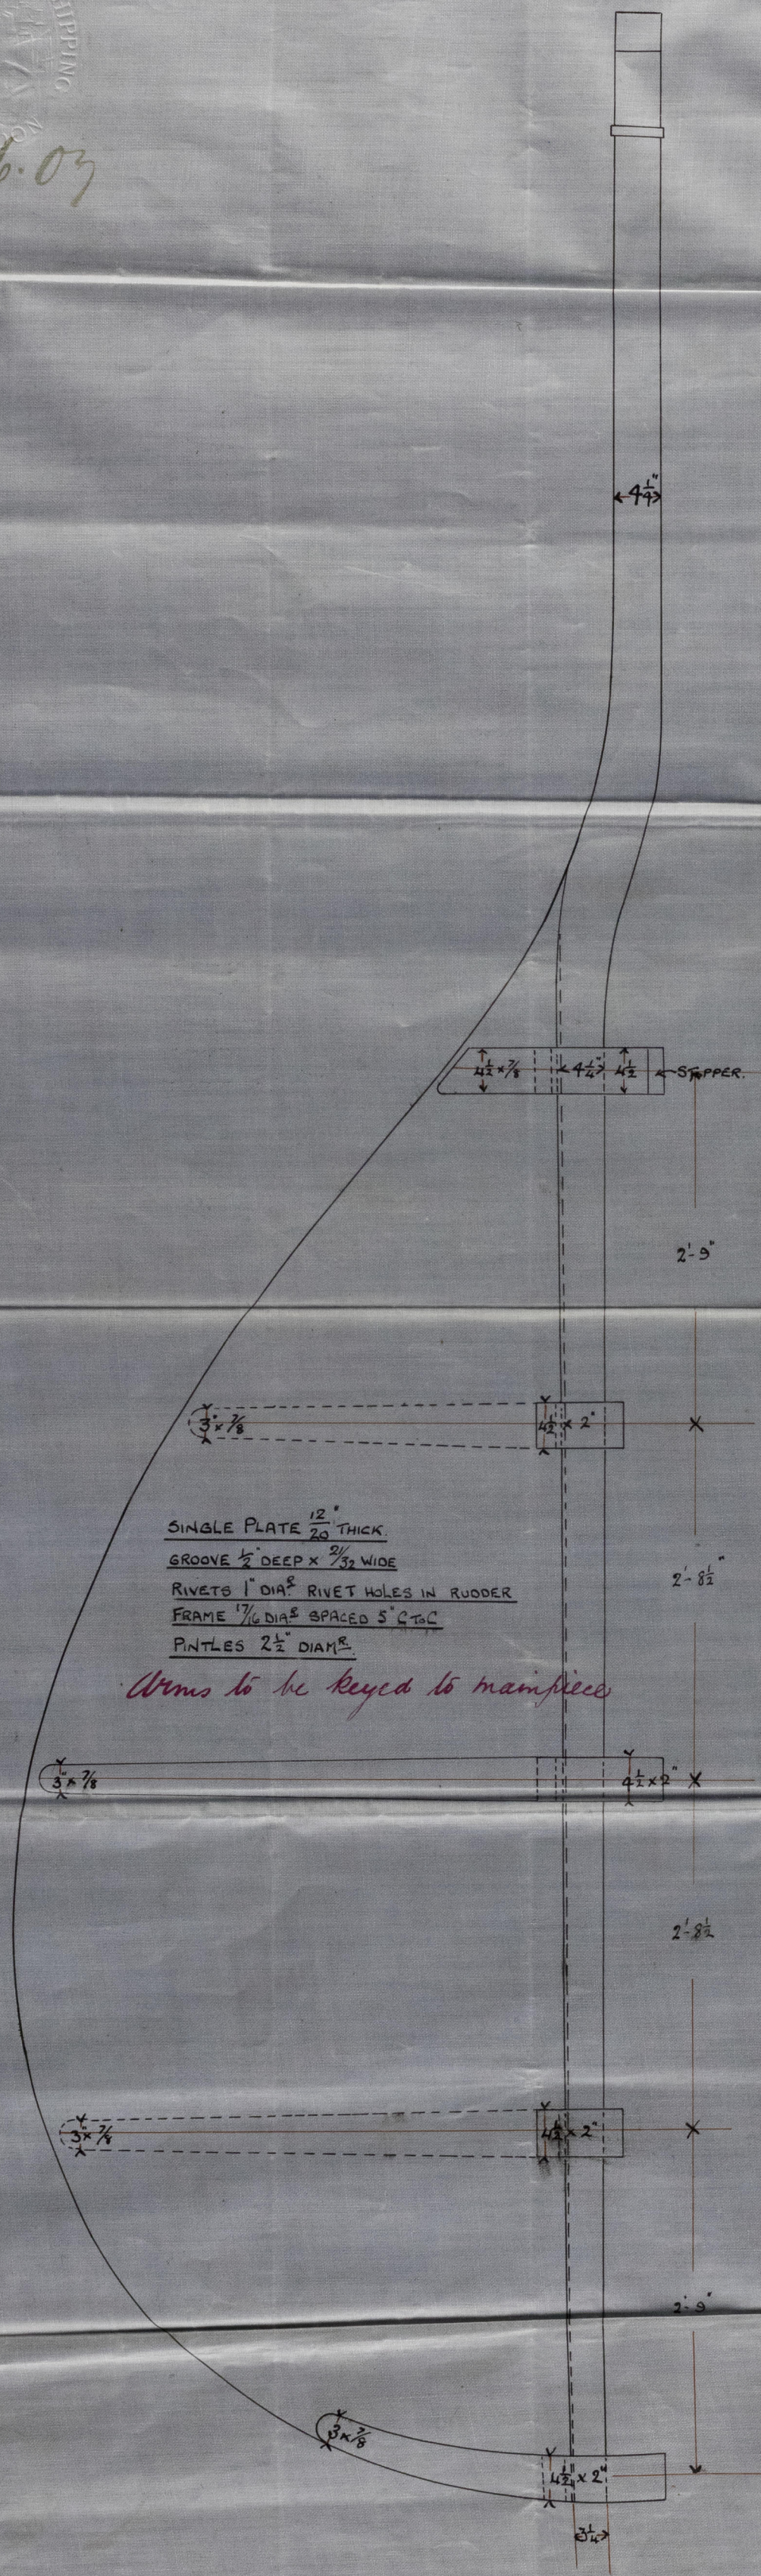




SINGLE PLATE $\frac{12}{20}$ THICK.
RIVETS $1\frac{1}{2}$ DIA² RIVET HOLES IN RUDDER
PINTLES $2\frac{1}{2}$ DIA².

Arms to be keyed to main piece




— RUDDER —

— S.S. No 60 —

— SCALE 1" = 1 FOOT —

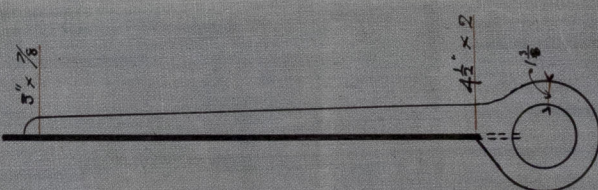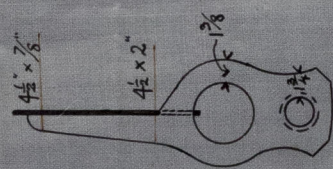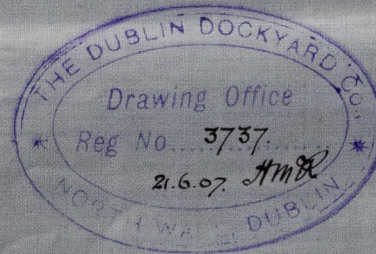

DETAIL OF ARMS

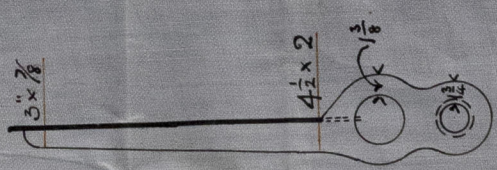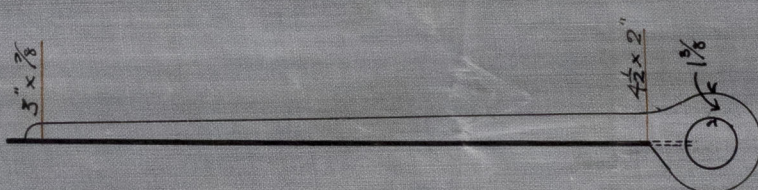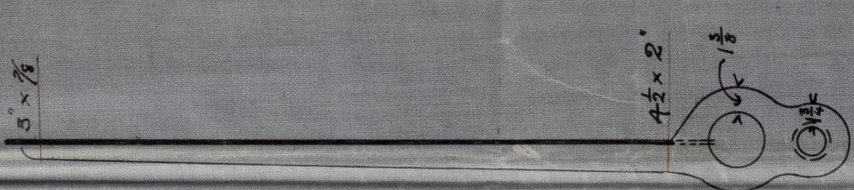

J.P.L.
26/6/07



© 2020

Lloyd's Register
Foundation

N/w. 10 Henry Traders

S.S. Carlingford

Dublin Report

No 2688.

Ruckler



© 2020

Lloyd's Register
Foundation

003116-003123-0190