


# Lloyd's Register of Shipping.

Ship's Name S.S. "ORKNEY TRADER"

Official No. 126961

Memorandum of alterations reported since ship was surveyed for assignment of Load Lines in \_\_\_\_\_

## PARTICULARS OF ESCAPE HATCH ON FREEBOARD DECK.

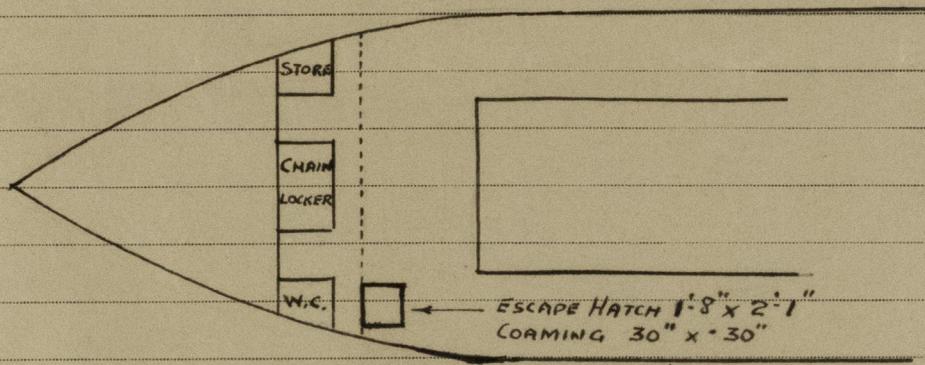

ESCAPE HATCH 1'-8" X 2'-1"  
 COAMING 30" X 30"  
 CLOSED BY 3" THICK WOOD COVERS  
 WITH TARPAULINS, CLEATS, BATTENS & WEDGES TO RULE REQUIREMENTS.

*E. J. Morris*

*Aberdeen 6/4/55.*

*Noting  
 A.R.  
 B. L. J. S.*

*28*

12 APR 1955



© 2020  
 Lloyd's Register  
 Foundation