


N<sup>o</sup> 562  
**PONTOON** FOR ROCKBREAKING MACHINERY

CLASS: <sup>see letter</sup> A. LLOYD'S REG. "Ponton Barge"




DIMENSIONS  
LENGTH - 100' 0" = 30.48 M  
BREADTH - 28' 0" = 8.53 M  
DEPTH - 3' 0" = 2.44 M

SCALE 1 = 50.


LONGITUDINAL PLAN.

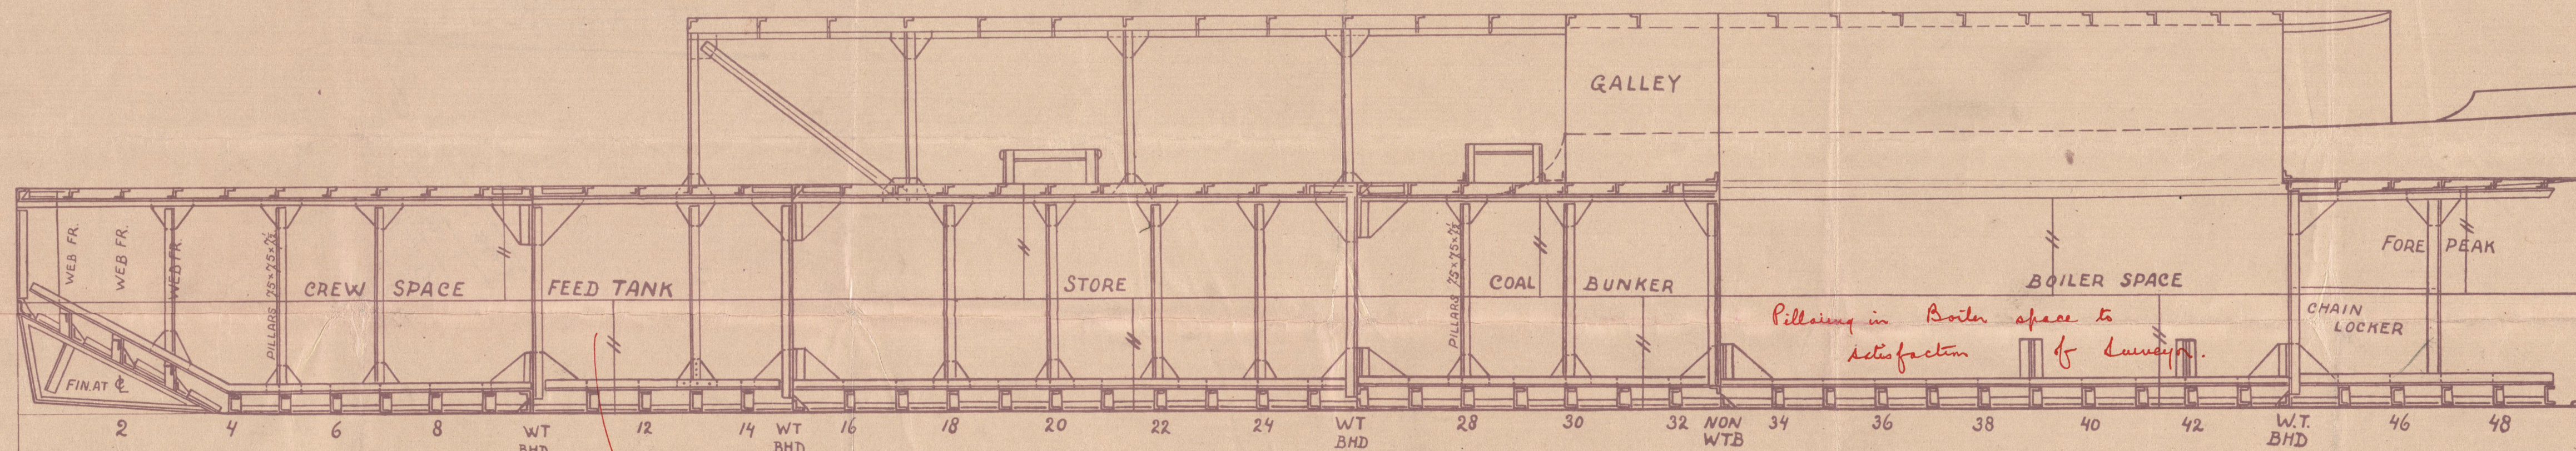

DECK PLAN.

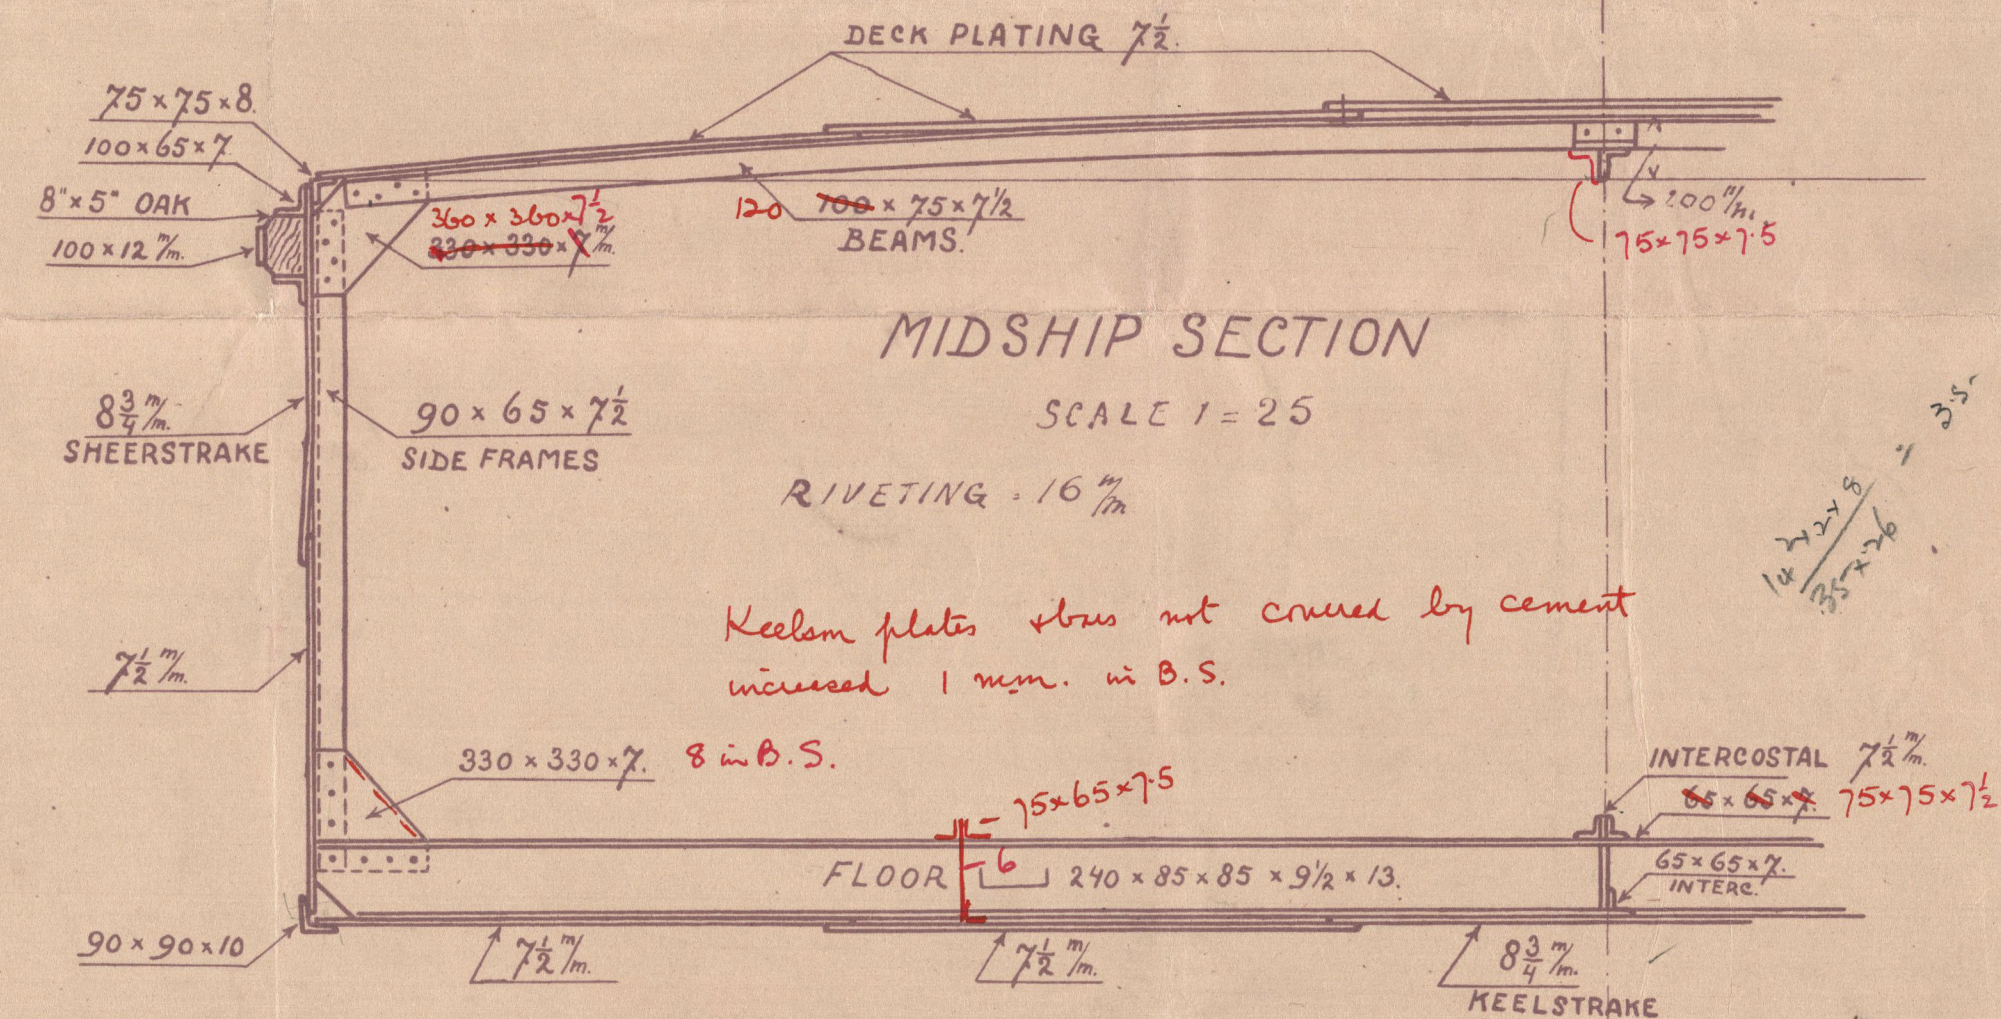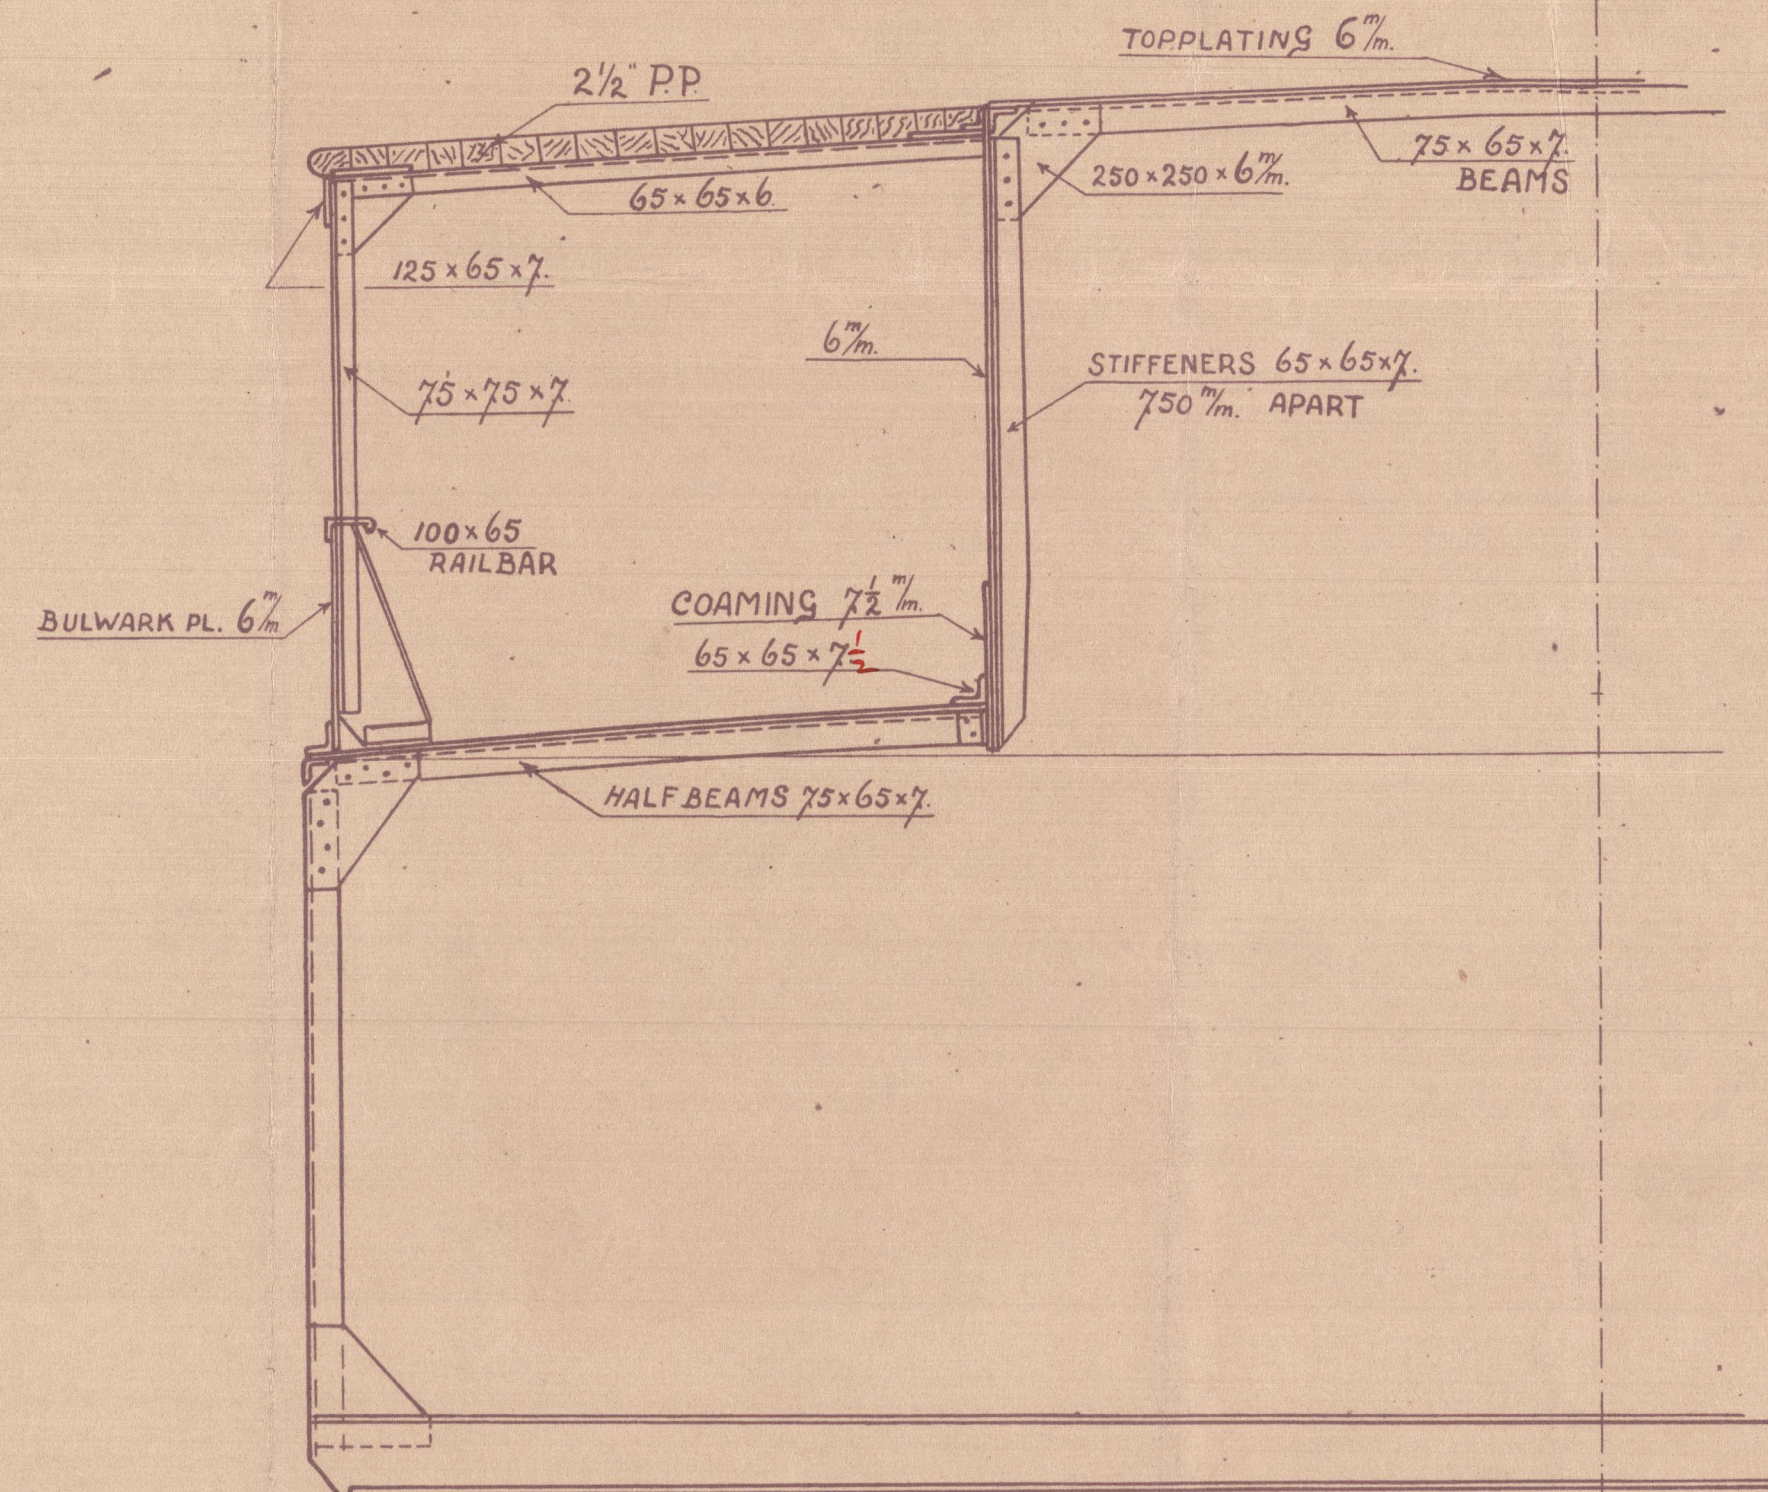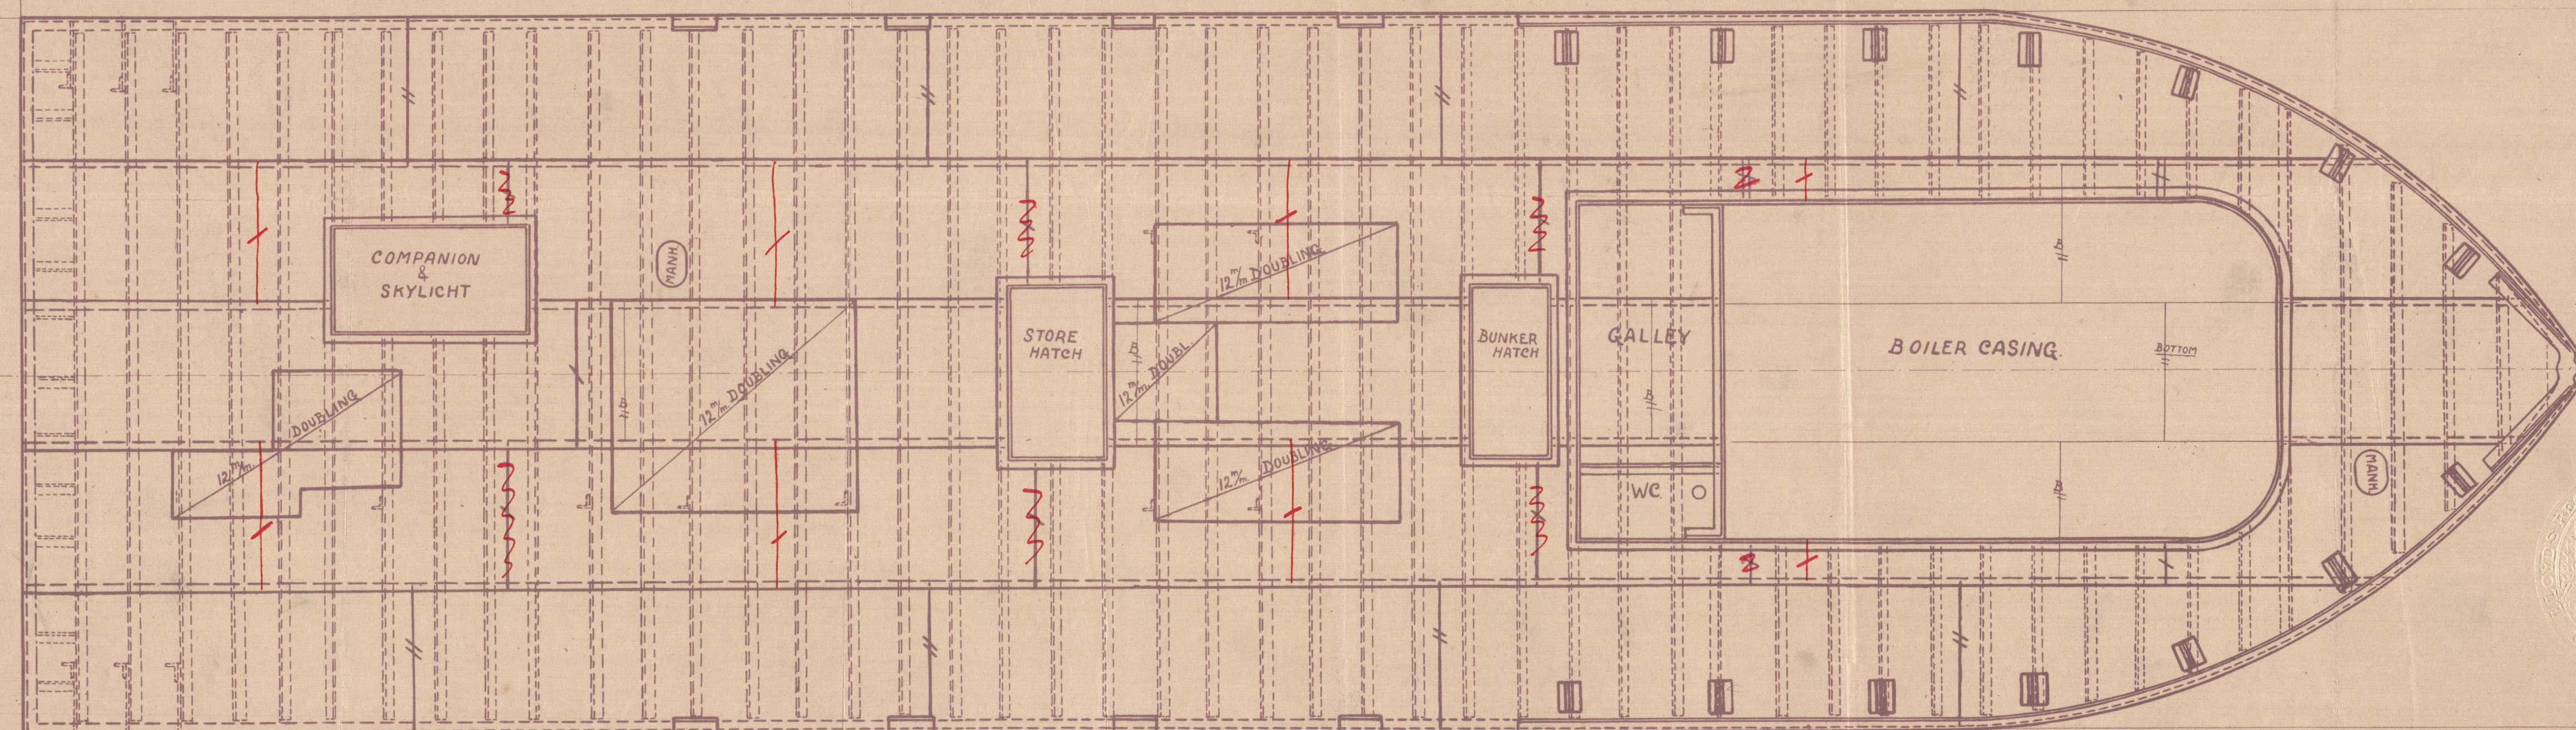

W.T. BULKHEAD.  
BOUNDARY ANGLES 65x65x7 1/2  
STIFFENERS - 100x75x8 - SPACED 750" APART  
PLATING 6 1/2" IN TANK.

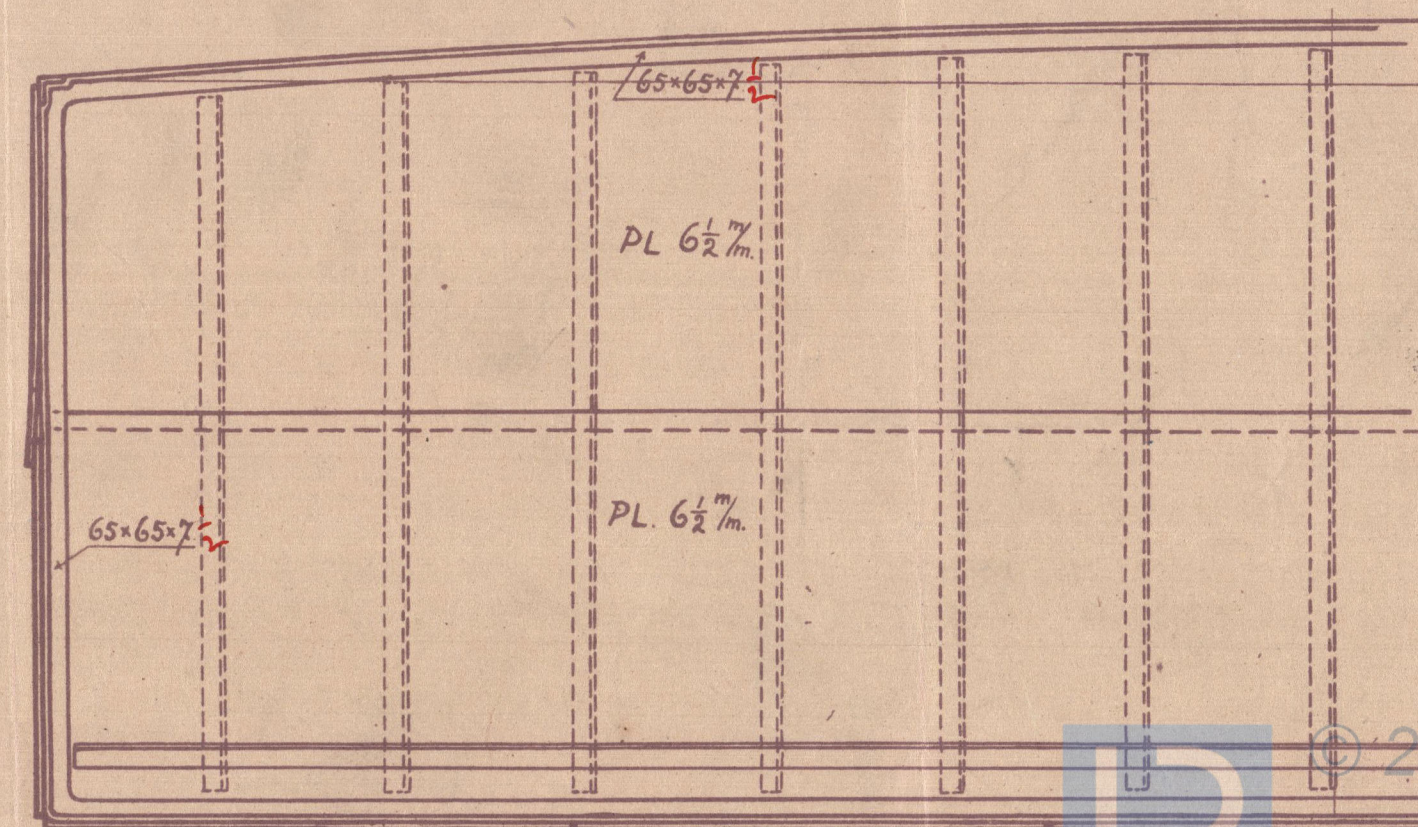

L.R.C.  
30.7.29



*J. Mayo SBC*


*562*

*M.S. P & D & Bldg.*

*hndm*

~~GEN. BOX 112~~ *219*

*"James Rackbreaker"*

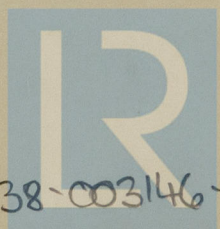

© 2020

Lloyd's Register  
Foundation

003138-003146-0062