

JOB N° C.A. 100.

# PROFILE & DECK.

DIMENSIONS - 425'-0" B.P. x 56'-6" B.M. x 27'-6" D.M. / 36'-6" SH.DK.


SCALE -  $\frac{1}{8}$  " = 1 FOOT.

DRAFTS B.K.	DISPLACEMENT	11,985 GRT

M.O. DISPL. @ 85' M.O. DEPTH = 11,840 TONS BLOCK COEF 728  
85 " " " 22.20 FEET

PILLARS, GIRDERS, HATCHES & STRONG BEAMS WILL BE SUBMITTED.

STRENGTHENING UNDER MASTS, WINCHES, WINDLASS.  
STEERING GEAR & DECKHOUSES TO SURVEYOR'S SATISFACTION.

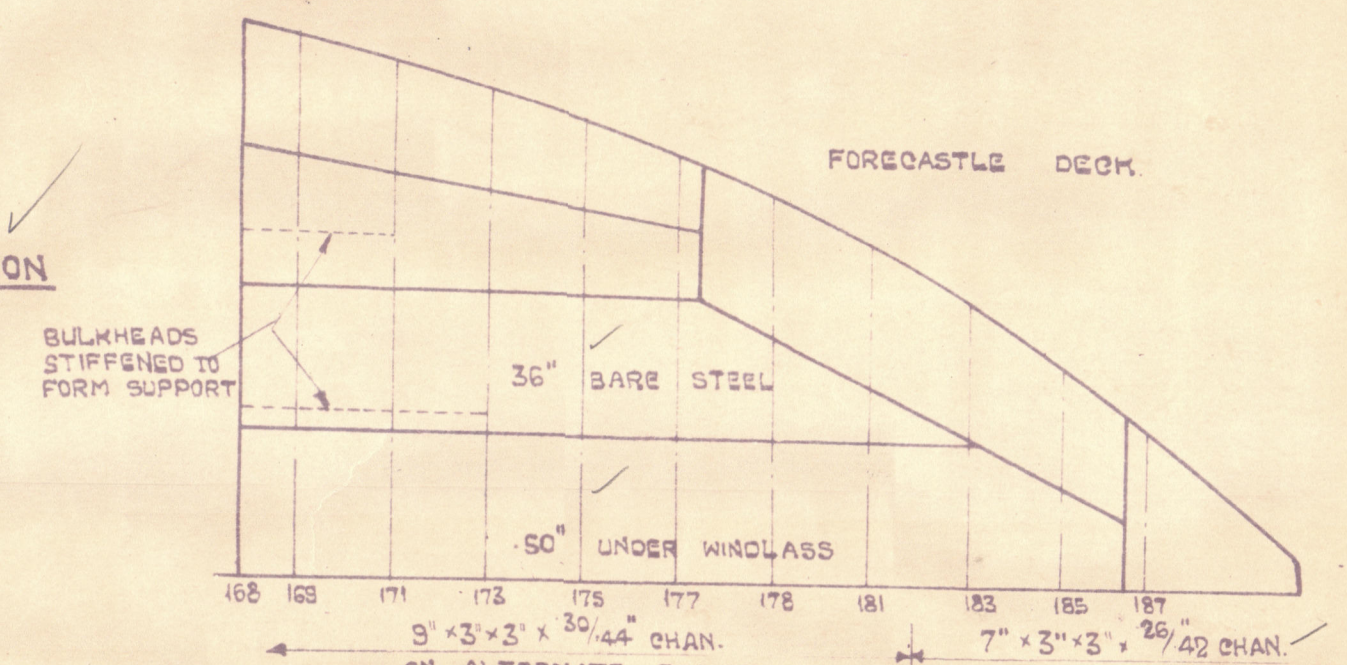

FRAMES AT FORWARD END  
TO SURVEYOR'S SATISFACTION.

PARTING ARRANGEMENT  
WILL BE SUBMITTED.


BHD 12 & 14

SHELTER DECK

UPPER DECK

SECTION AT FR 100

GEN. BOX NO 179

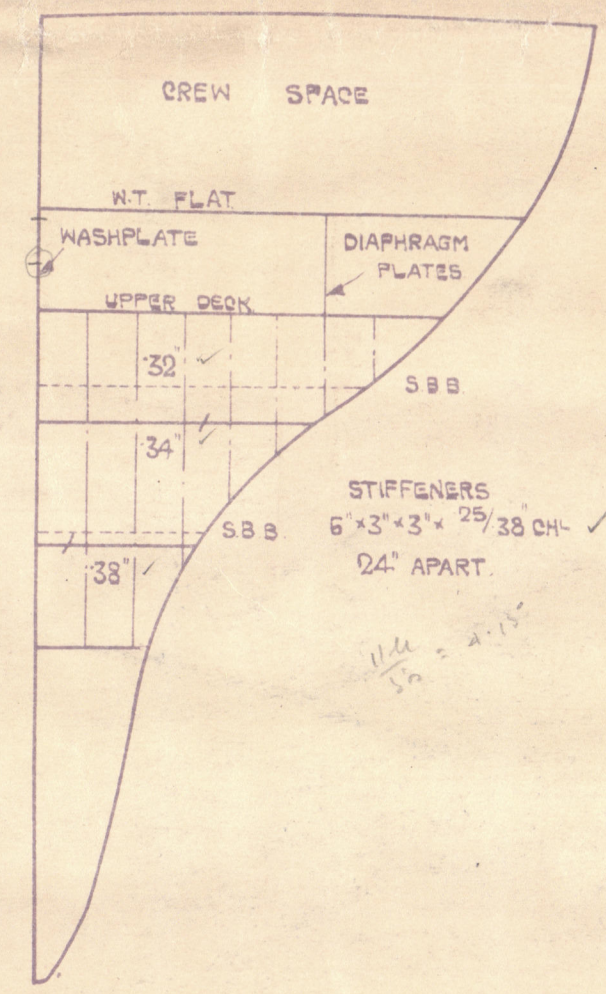

BHD 12



SHELTER DECK

UPPER DECK

W.T. FLAT

9. 1. 10.



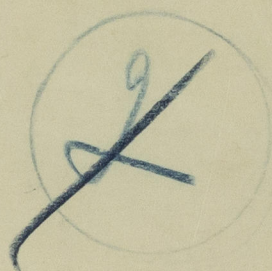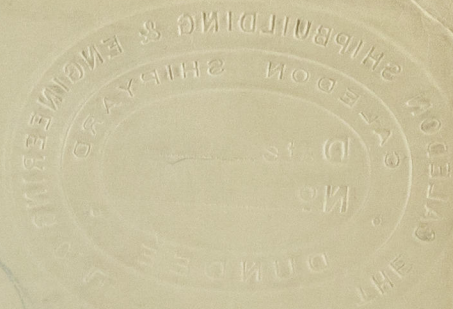


River Norman ★

AUSTRALIAN S.B. PROGRAMME  
(CALEDON'S DESIGN C.A.100)

PROFILE AND DECKS

RECORDS DEPT.  
LONDON

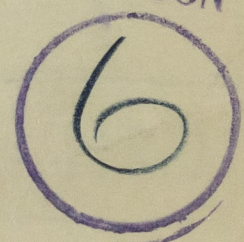

003147 - 003153 - 0047



© 2020

Lloyd's Register  
Foundation