

N<sup>o</sup> 1297 & 1299.

# LAKE STEAMERS.

## —PROFILE & DECKS.—

DIMENSIONS - 253'-0" B.P. x 43'-4" E.T. x 20'-0" D.M.<sup>2</sup>

TO CLASS B.3\* FOR SERVICE ON GREAT LAKES & RIVER

ST. LAWRENCE

SCALE 1/8" = 1 FT

30 OCT. 1926


Approved *[Signature]*  
2-11-26

For Act<sup>n</sup> to "LAKEWOOD"  
See Letter from Liverpool  
Dated 21/8/24

5'-6"  
253'-0"  
258'-6" and 260'

Suggested Plate

Suggested Plate

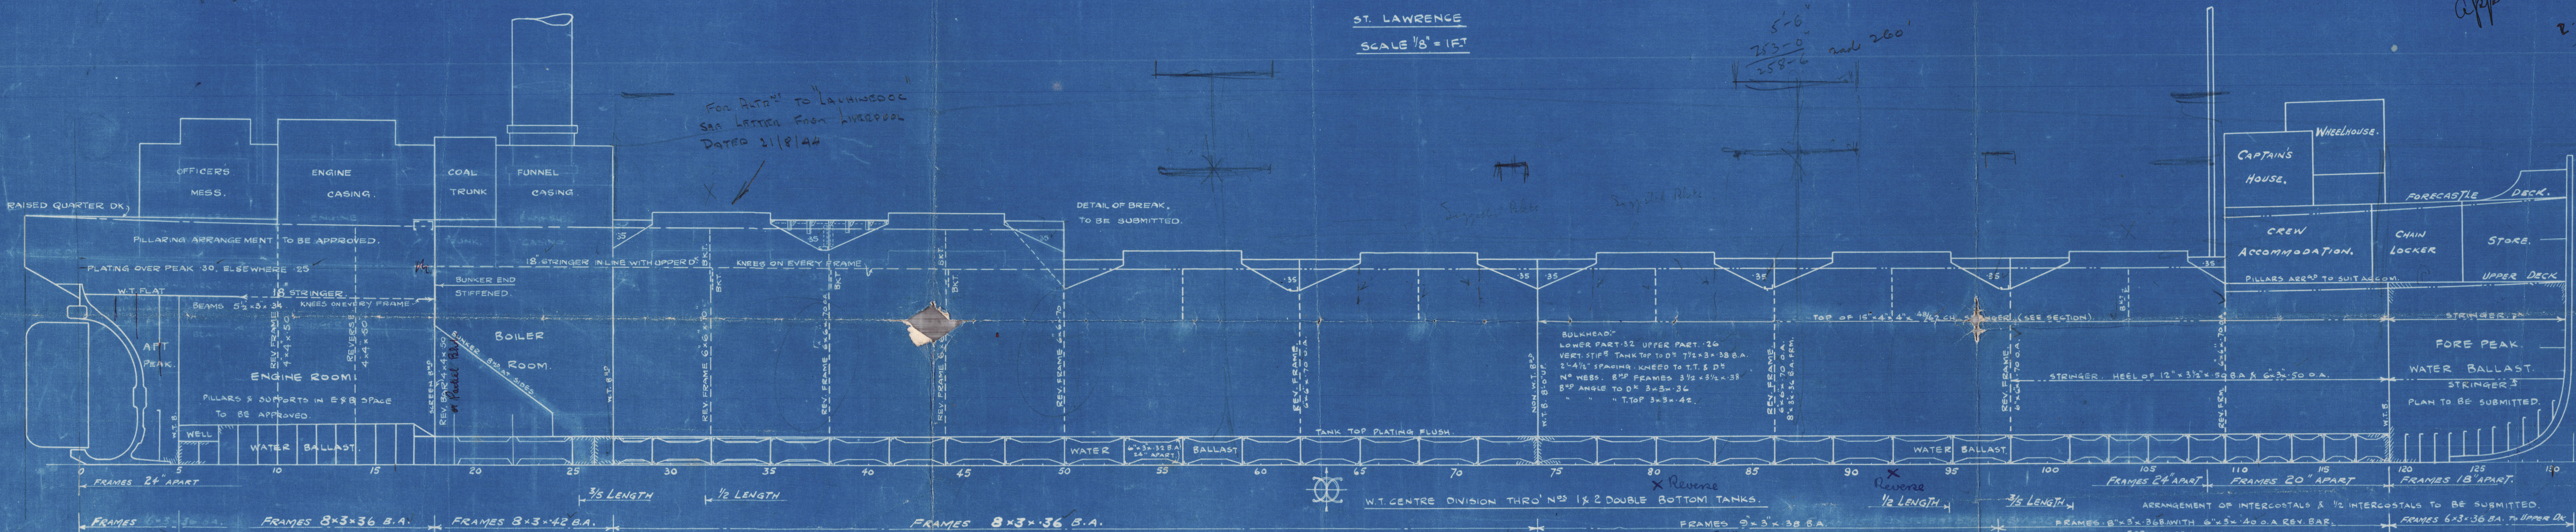



14.

Und. Profile & Lk.

Swan Hunter & A.R.

1297 - 1299.

& 1311-13-15.

2 - 11 - 26.

J. b. 14 - 11 - 26.

" 23 - 2 - 27. } For 1311-13-15  
Smith's Dock Co.  
831-2-3.

1297 "Kingdoc" \*

1299 "Yorondoc"

1311 "Lachinedoc"

1313 "Hamildoc"

1315. "Wellandoc" von Beaufort




© 2020

Lloyd's Register  
Foundation

003181-003190-0045



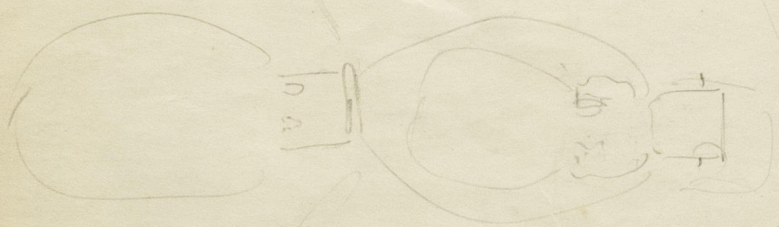

003181-003190-0045

003181-003190-0045



© 2020

Lloyd's Register  
Foundation