


Dec 18/9/27.

STERNFRAME, RUDDER, STEM AND STEELCASTING IN COUNTER.

STEM, STERN FRAME, RUDDER FRAME, RUDDER HEAD & COUNTER PIECE OF CAST-STEEL.  
PINTLES OF FORGED STEEL.  
R.O.D. 100" 2147. SPEED OF VESSEL 15 3/4 KNOTS.  
DIAMETER OF RUDDER HEAD 345 1/4" (BULLES 335 1/4")  
BR. LLOYDS TEST TO BE DELIVERED.  
COUPLING BOLT OF FORGED STEEL.



 

9/8. Nabskov Skibsvæft.

Yard No. 86.


Amended plan of  
Stemframe & Rudder.

and stem.

m.s. "Islandia" of Copenhagen  
Exp. Report No. 10720.

203181-003190-0152

© 2020

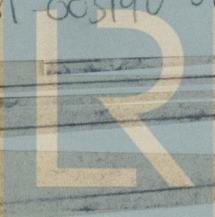

Lloyd's Register  
Foundation