
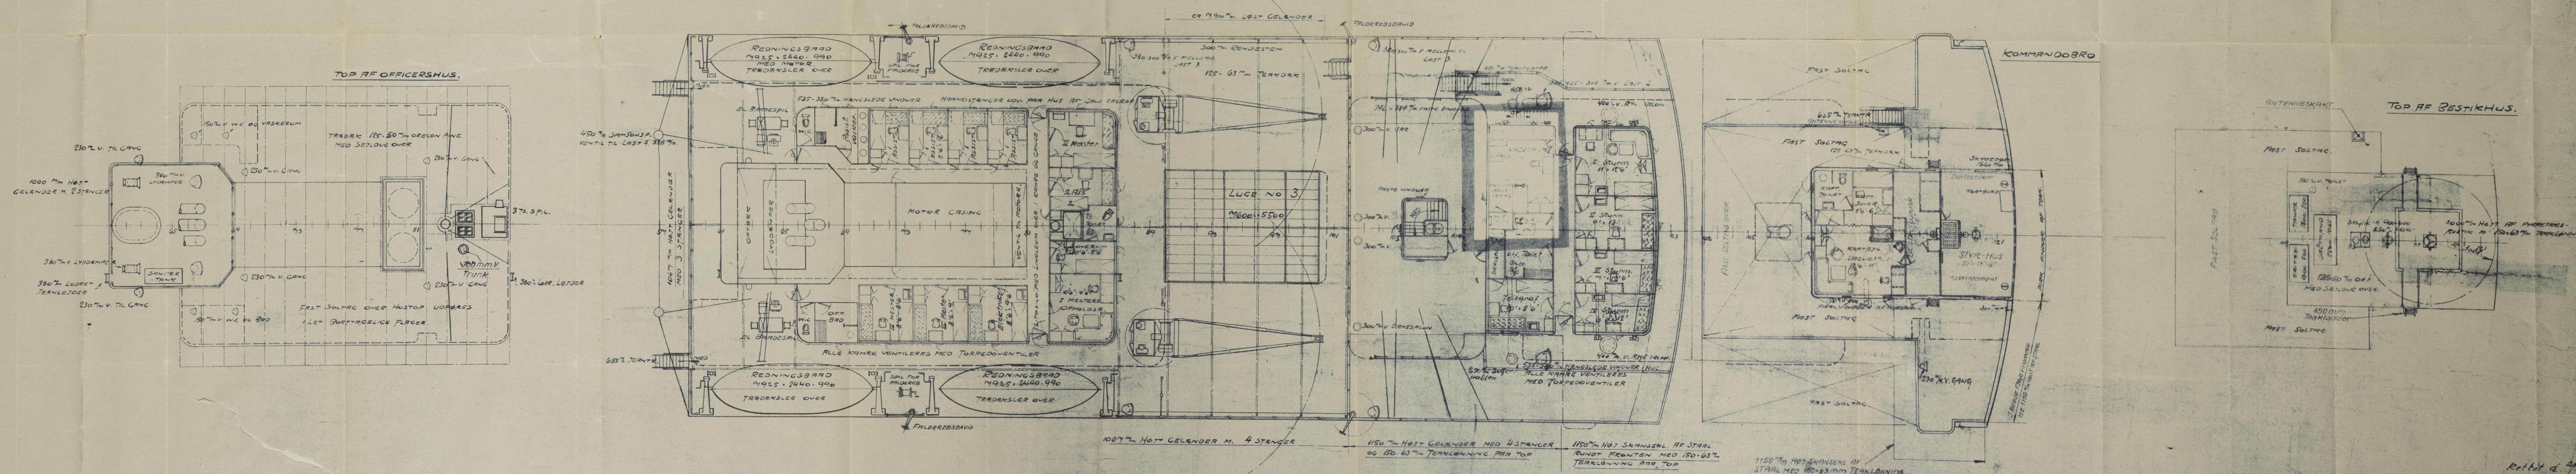


A/S NAKSKOV SKIBSVERFT
NAKSKOV.

GENERAL ARRANGEMENT.
BYGN. No 86.

LENGDE MEL. PERPEND.	129.540 MTR. = 425' 0"
BREDE PAA SPANT	19.200 = 63' 0"
DYDE TIL HOVEDDEK	8.535 = 28' 0"
• SHELTERPORT	10.975 = 36' 0"
HØJDE AF MELLEMDÆK	3.050 = 10' 0"
• BROEK	2.745 = 9' 0"
• BAKDEK	2.290 = 7' 6"
• PASSAGERHUS PAA 800	2.845 = 8' 3"
• OFFICERS OG KAPTAINSHUS	2.290 = 7' 6"
SKALA 1:100	

 

Rettet d. 29/2.37.
 Rettet d. 26. 37. RA.
 Rettet d. 19/5.37. RA.
 Rettet den 19. 37. 2.2
 Rettet den 2/6. 37. 116.
 Rettet. 12. 37.
 NIKOLAI 9/1. 1937.

Mens. #5. Dakker Philipsvæft:

Nord d. 86.

M. S. "Pelandia"

General Arrangement.



003181-003190-0153

© 2020

Lloyd's Register
Foundation