



NO. 1562.

10.2.21

SINGLE SCREW CARGO STEAMER.

PROFILE & DECK PLAN.

SCALE $\frac{1}{8}'' = 1 \text{ FOOT.}$

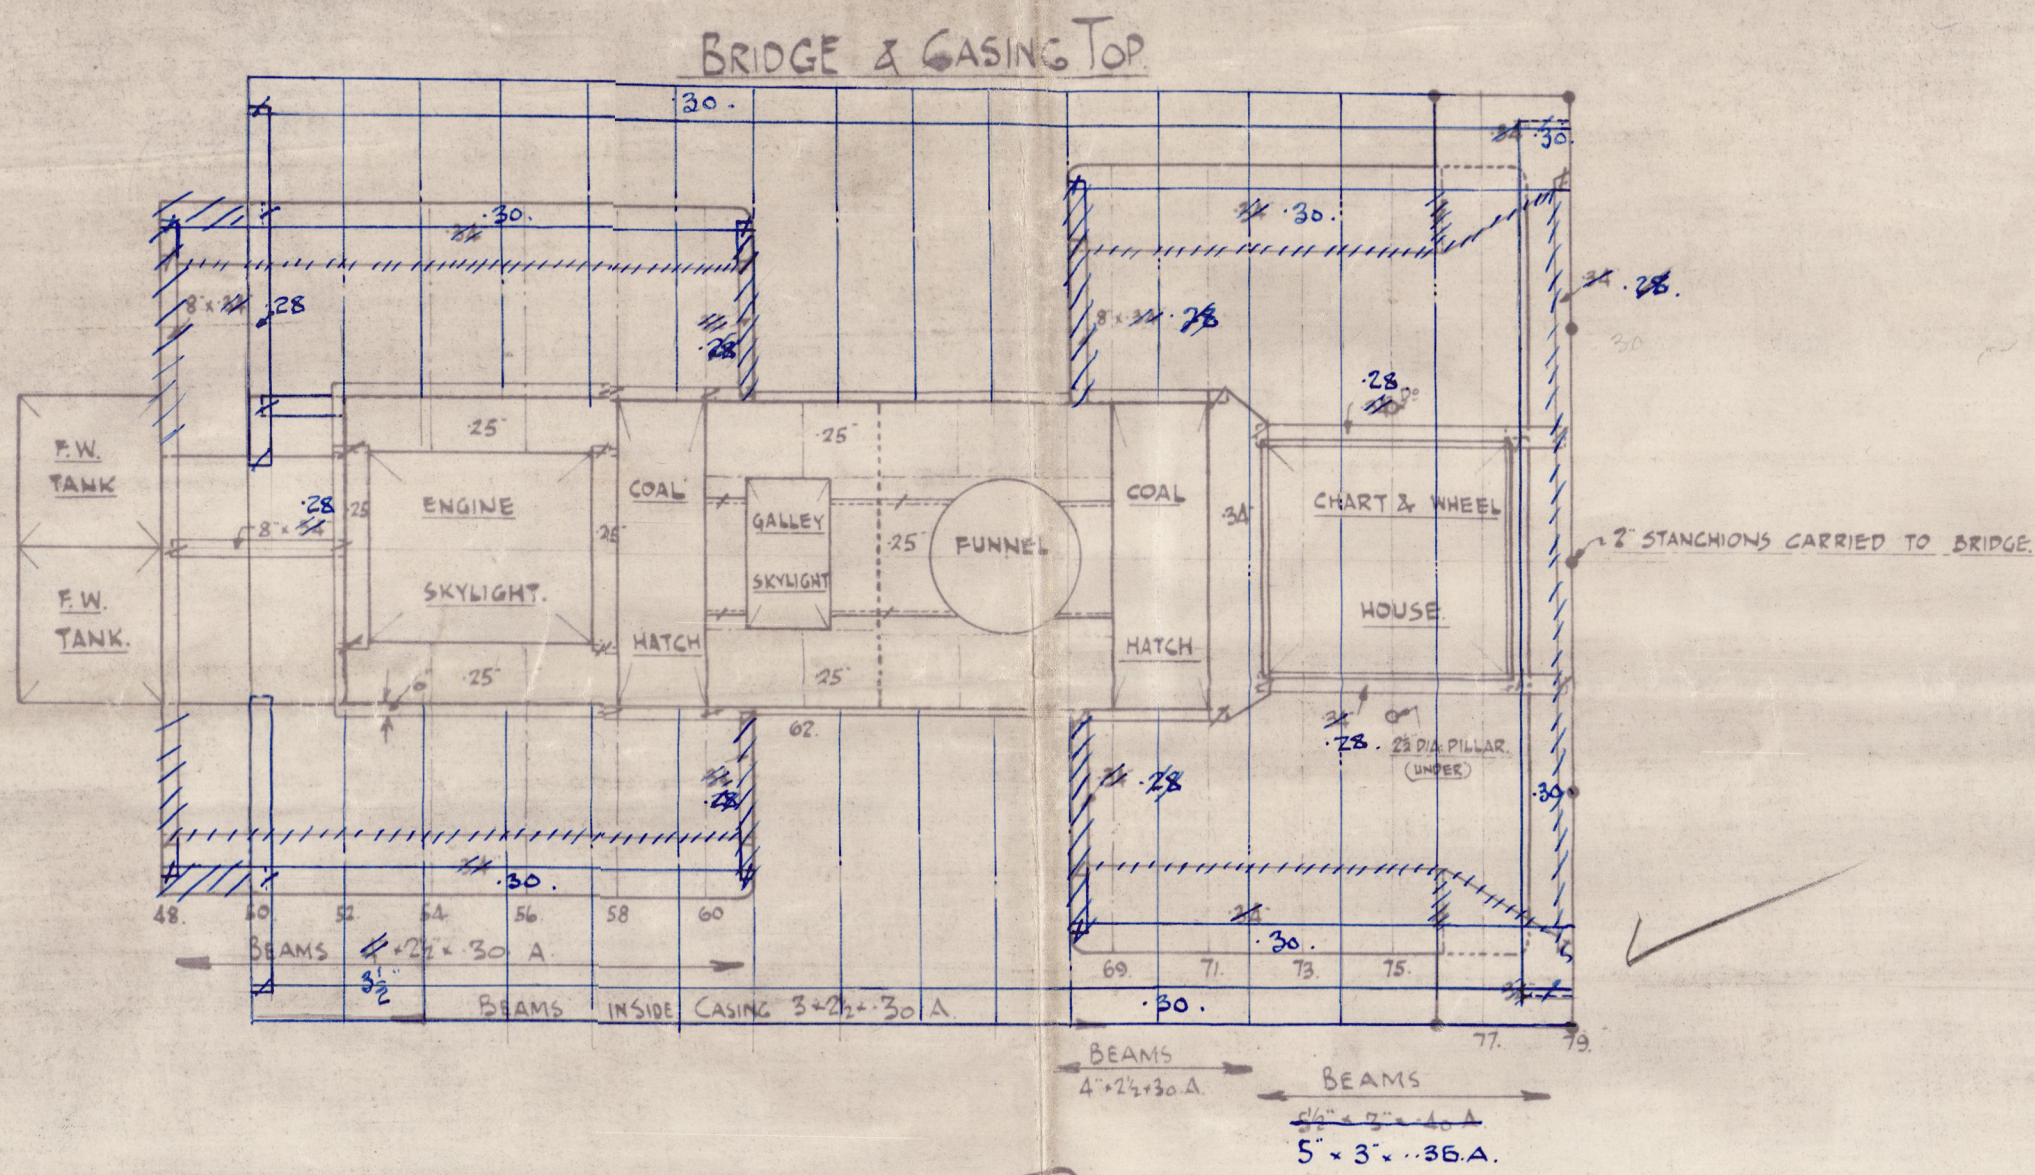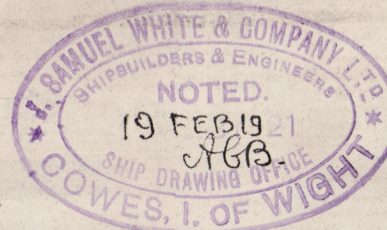

Misses J. S. White to. Sh
bowes.

Profile Deck Plan

Yard N: 1562.

S/ Hetherwood

Loc 10390

003181-0 03190-0179



© 2020

Lloyd's Register
Foundation