


1/2
31-02
MIDSHIP SECTION 20

513
No 510-11-12413.
MIDSHIP SECTION.
DIMENSIONS: 425' x 57' x 38'-7" MOULDED TO SHELTER DECK.
TO CLASS 100A.1. 'WITH FREEBOARD'. LOAD DRAFT 26'-0" MOULDED.
SCALE: 1/2" = ONE FOOT.

T.W. S. M. V. "TWEED BANK"

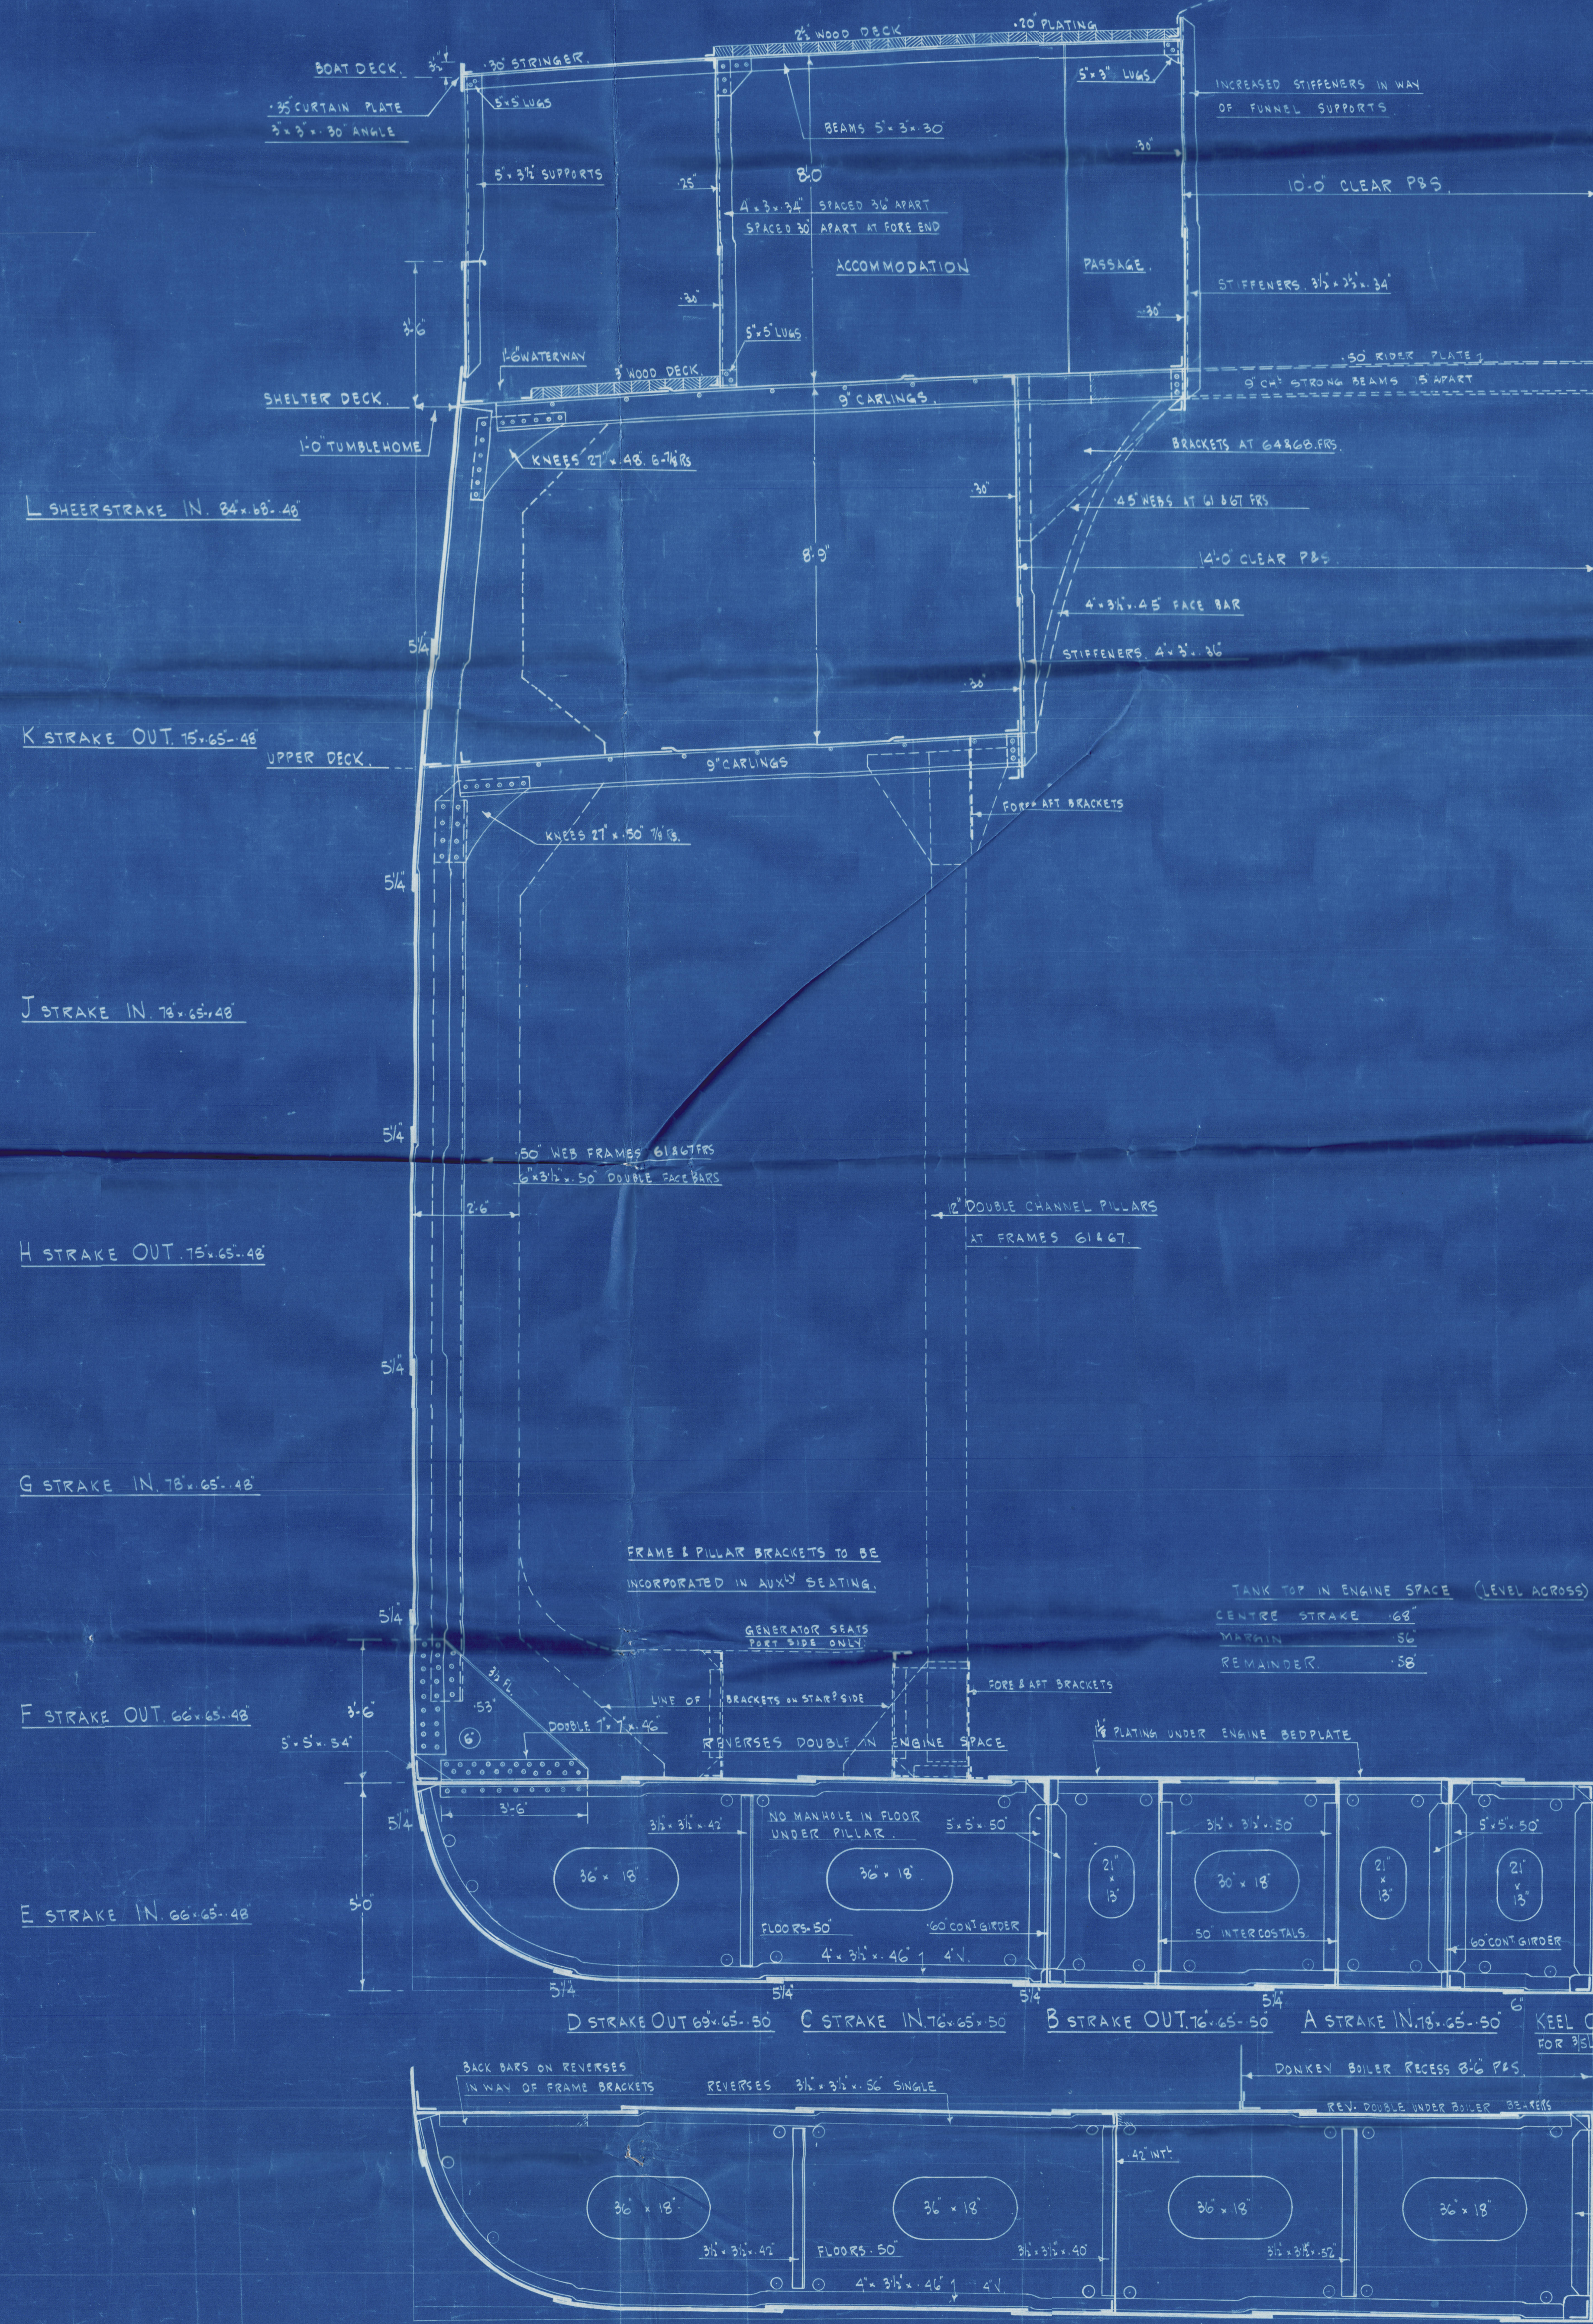

EQUIPMENT.

- 3 BOW ANCHORS STOCKLESS 20 TON COIL
- 1 STREAM ANCHOR 50 TON COIL
- 300 FATHOMS 2 1/2" STUD CHAIN CABLE
- 120 " 5" STEEL WIRE (STRENGTH)
- 130 " 5 1/2" " (STRENGTH)

FRAMING

FRAMES SPACED 36" APART, AT TOP OF 30' 1/2" IN PEAKS.
FRAMES IN HOLDS NO. 2, 4, 

Tw. Sc. M. V. "Tweedbank".


Midship Section as built

(Whitman Clark (1928) htd 513)

Q.

003181-003190-0271

© 2020

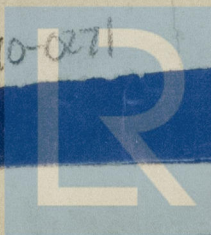

Lloyd's Register
Foundation