
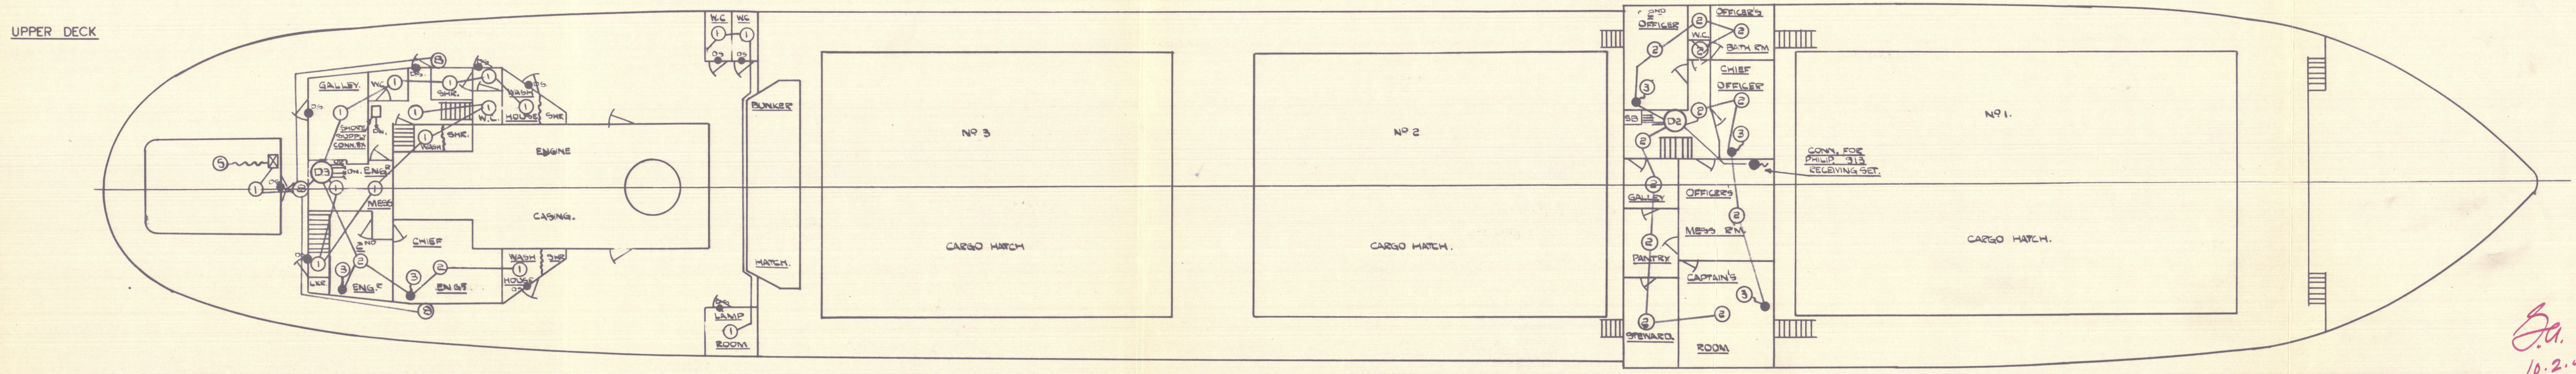
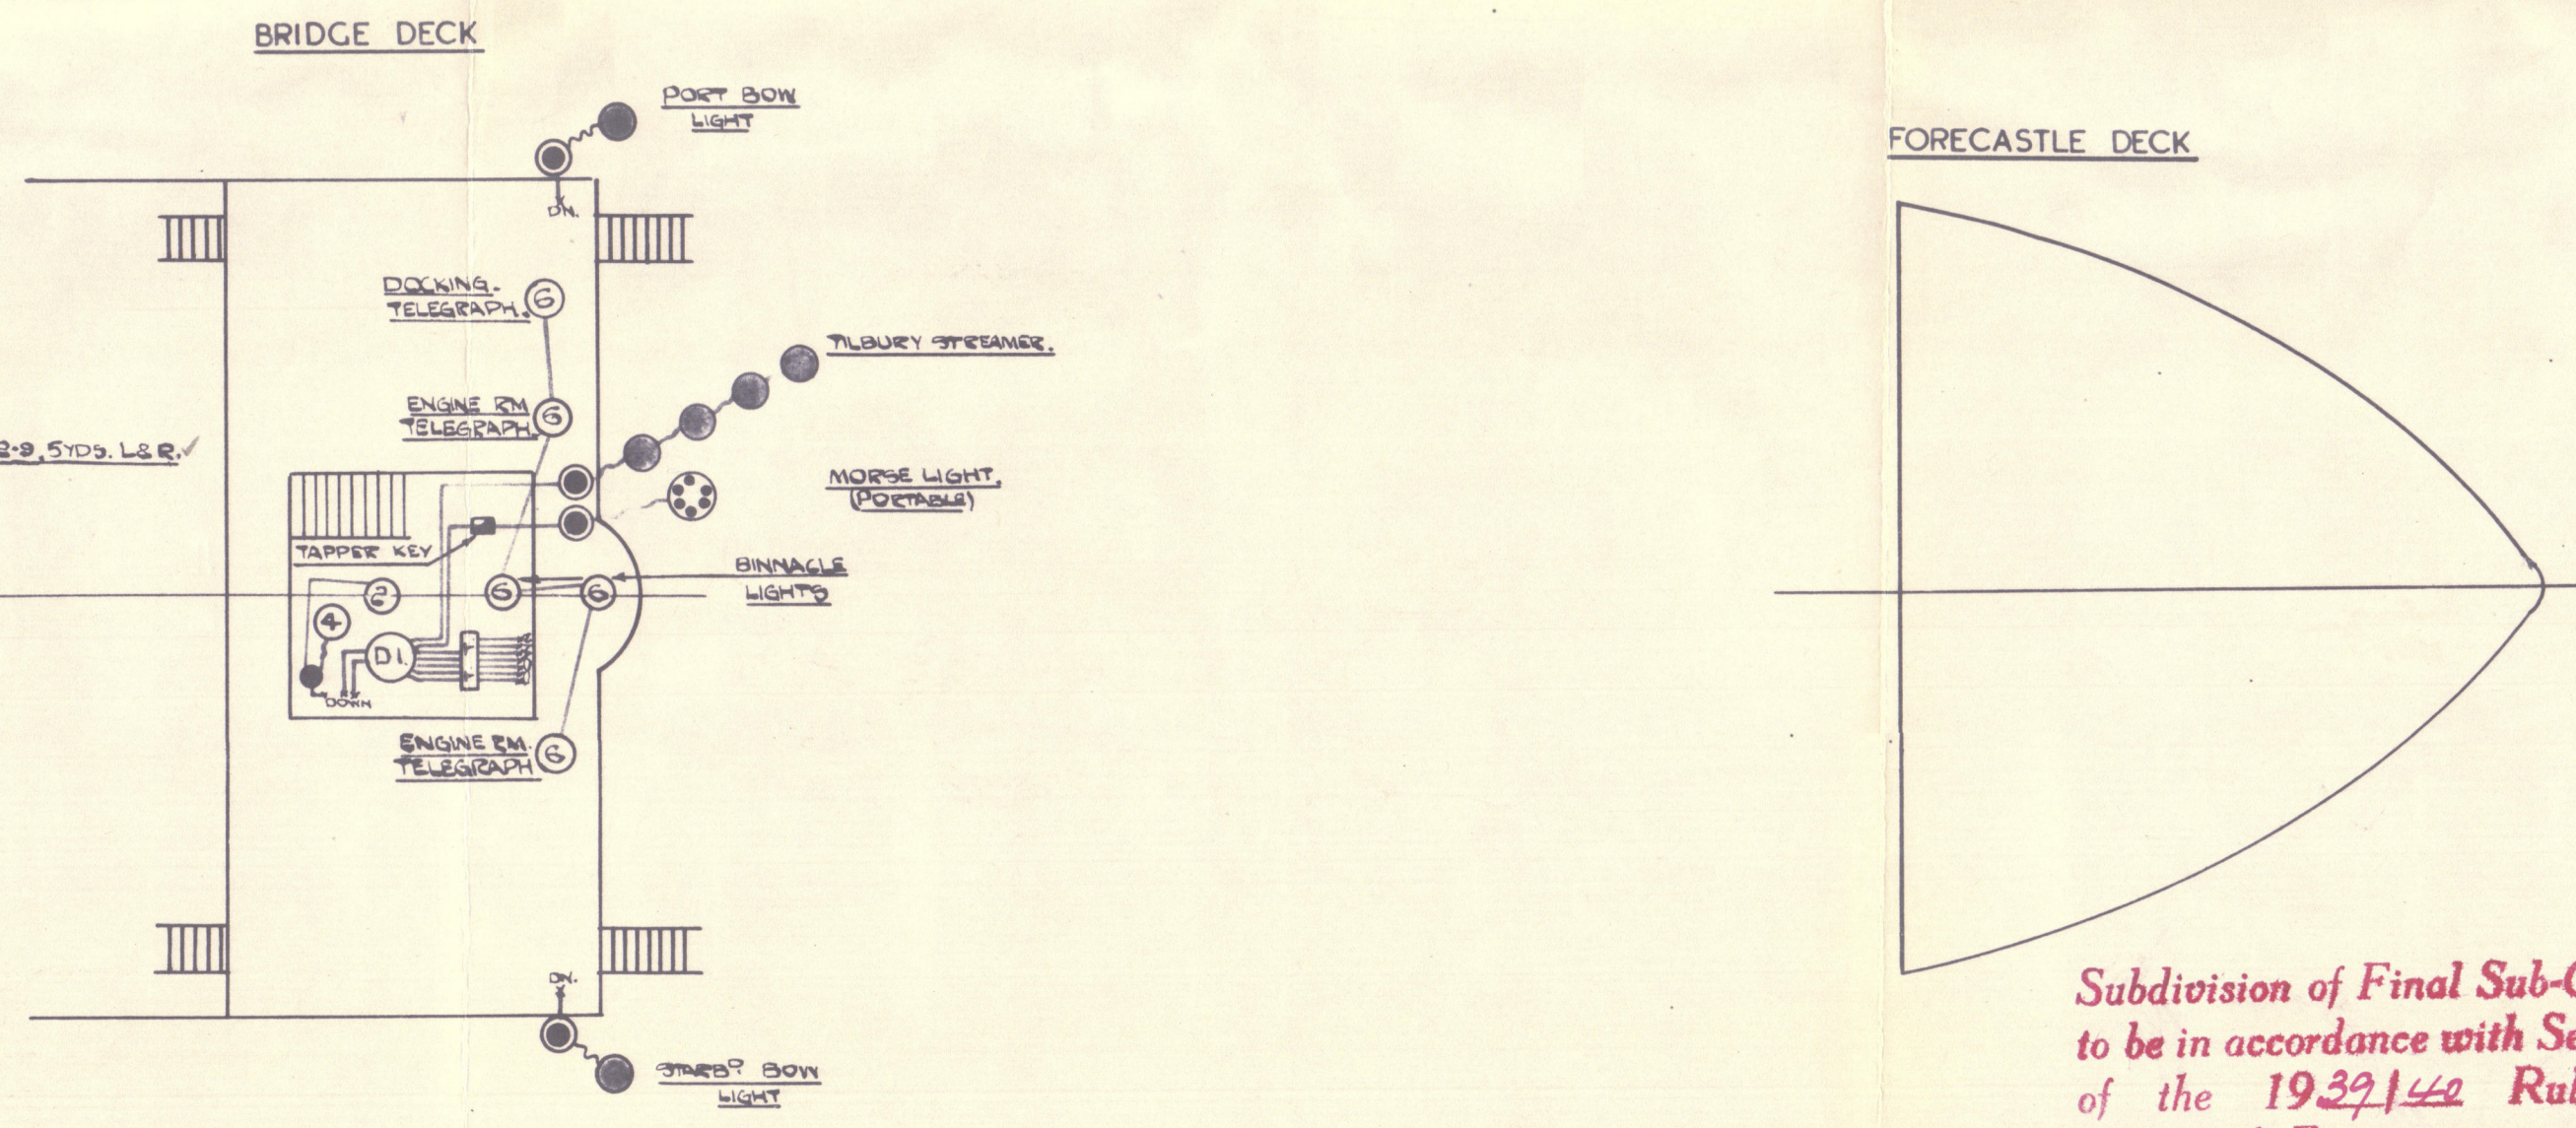
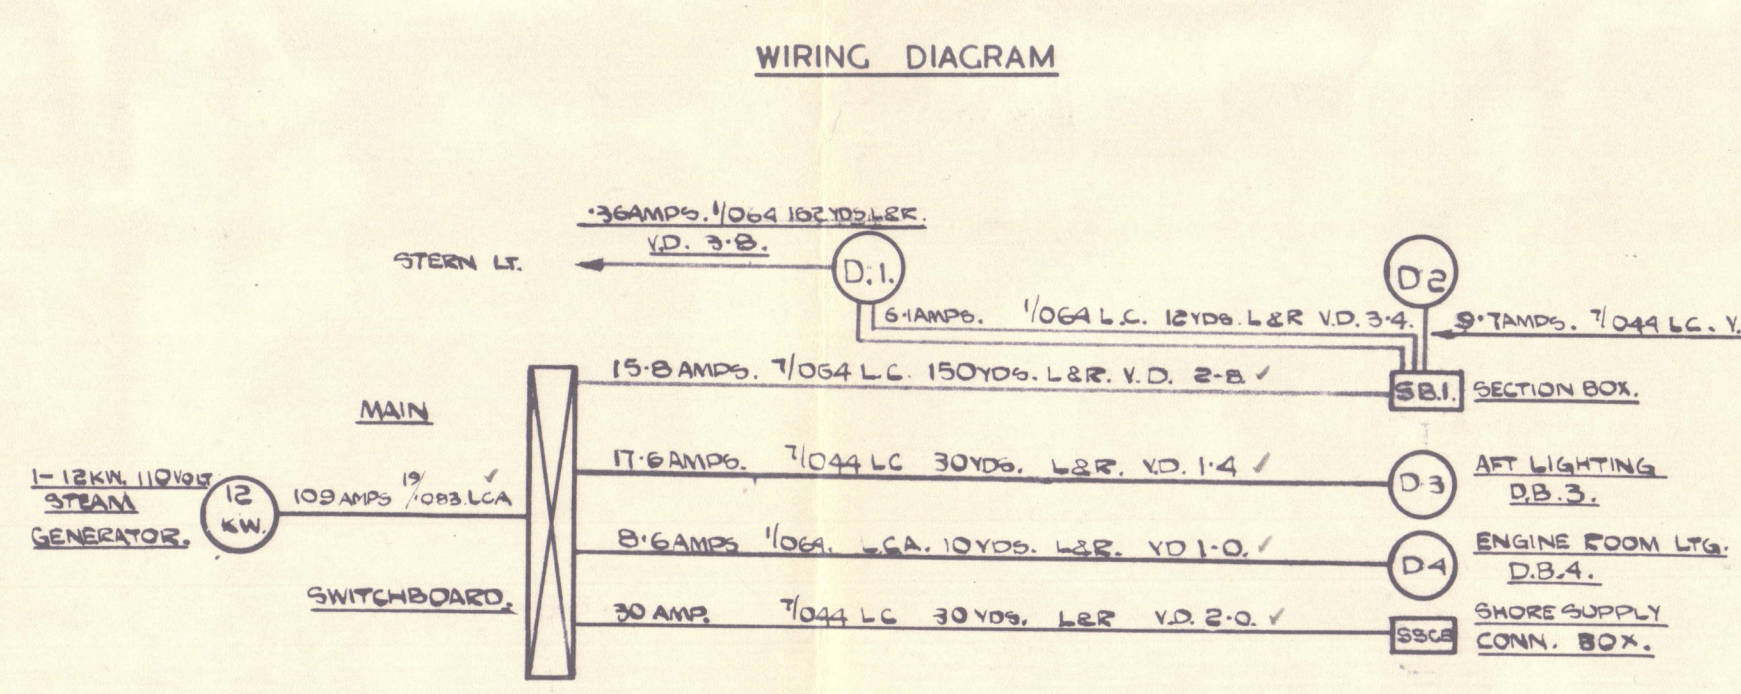
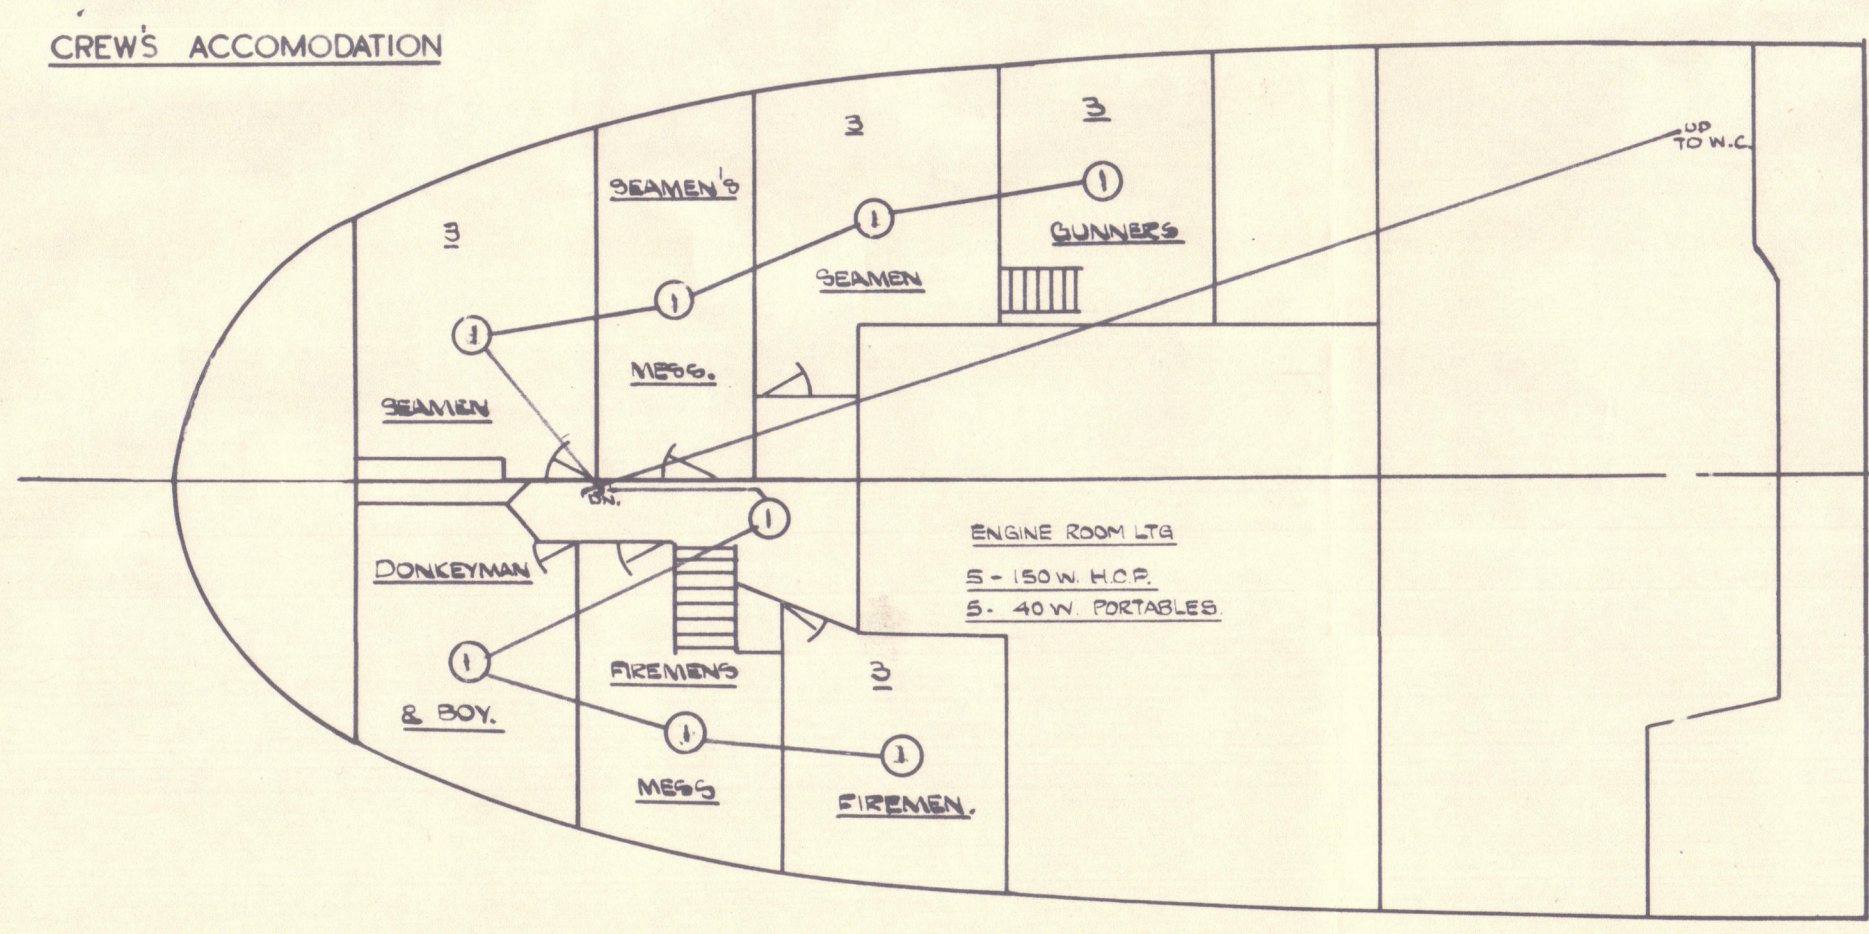


ELECTRIC LIGHT CIRCUITS.

SCALE 1/8" = 1 FOOT

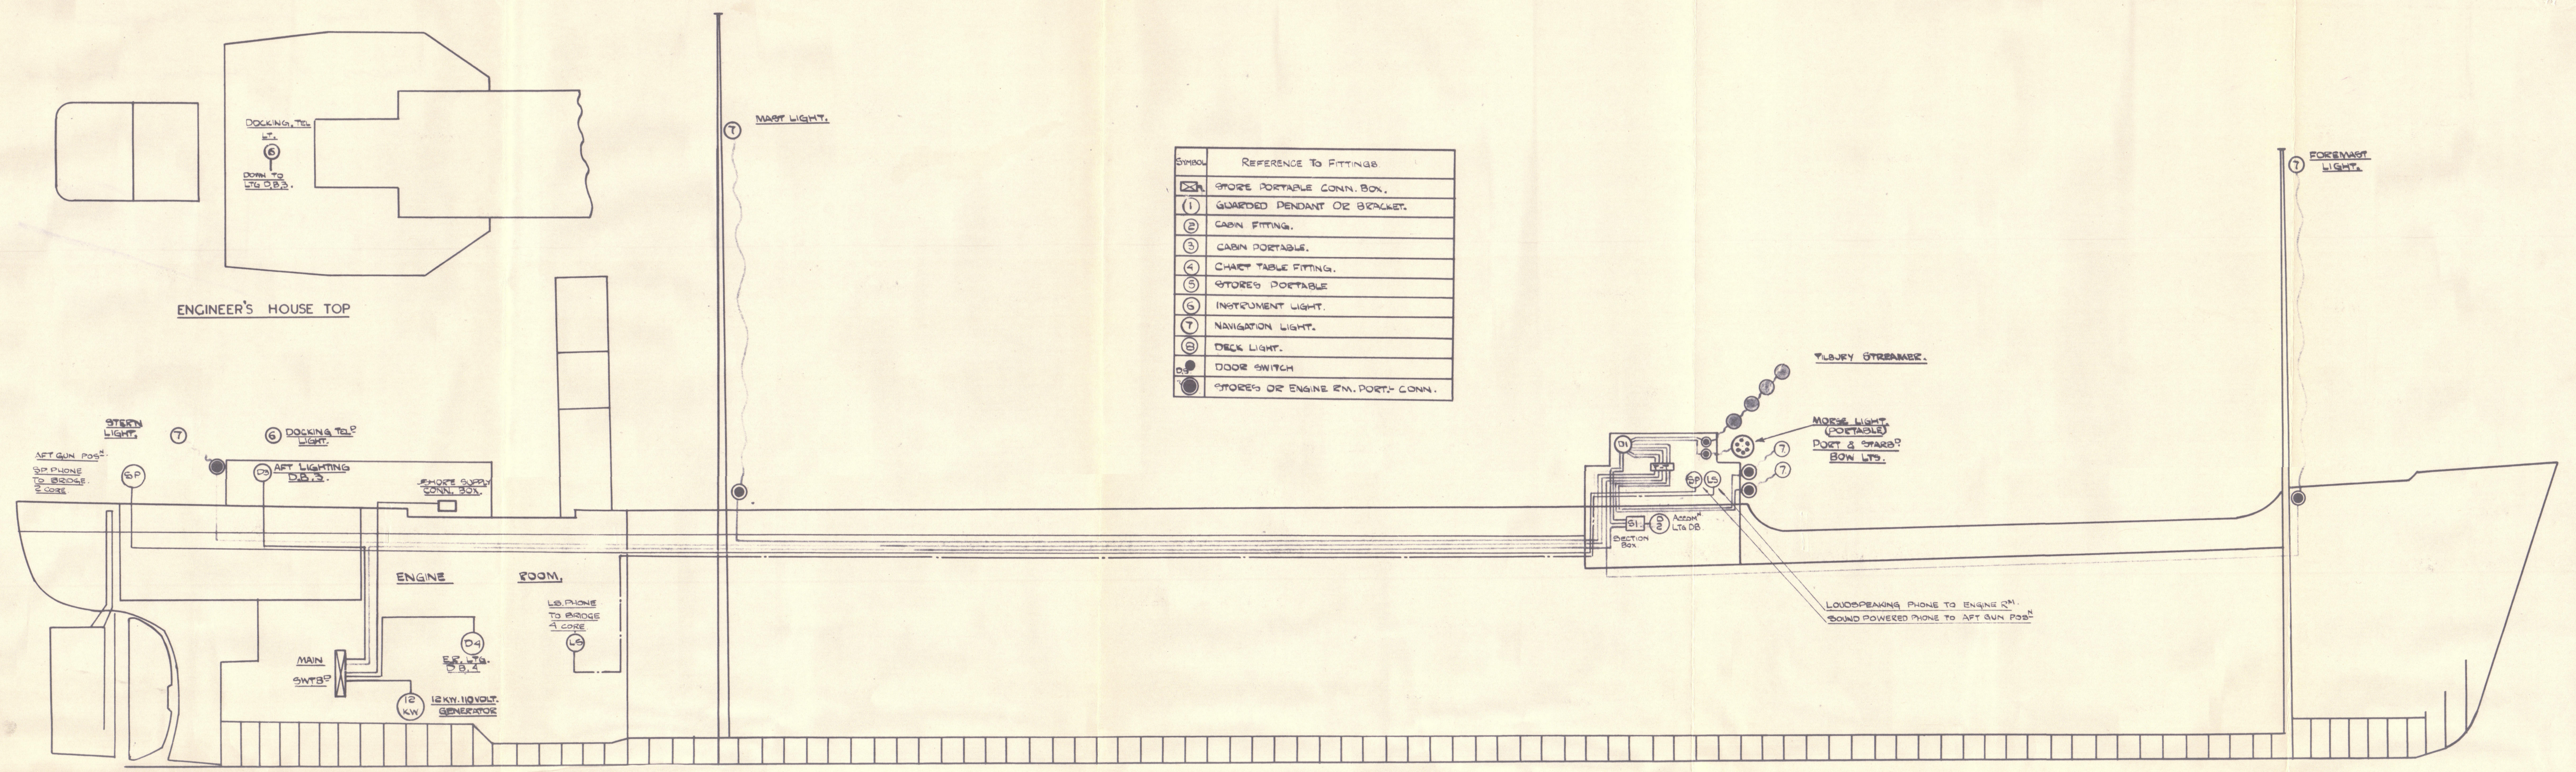


S.A. 10.2.41



7

"Capi Tol."

Sld Rept No. 33126.

General Arrangement  
and Wiring Diagram

Messrs. S. P. Austin & Co., Ltd.  
Yard No. 355

GEN BOX NO 381

13



© 2020

Lloyd's Register  
Foundation

003191-003199-0114