


SIDE PLATING & FRAMING.



CANADIAN SKIRMISHER
NEW DECK BETWEEN POOP & BRIDGE DECK
SCALE 1/8" = 1 FOOT.



SECTION THRO' HATCH
1/2" SCALE

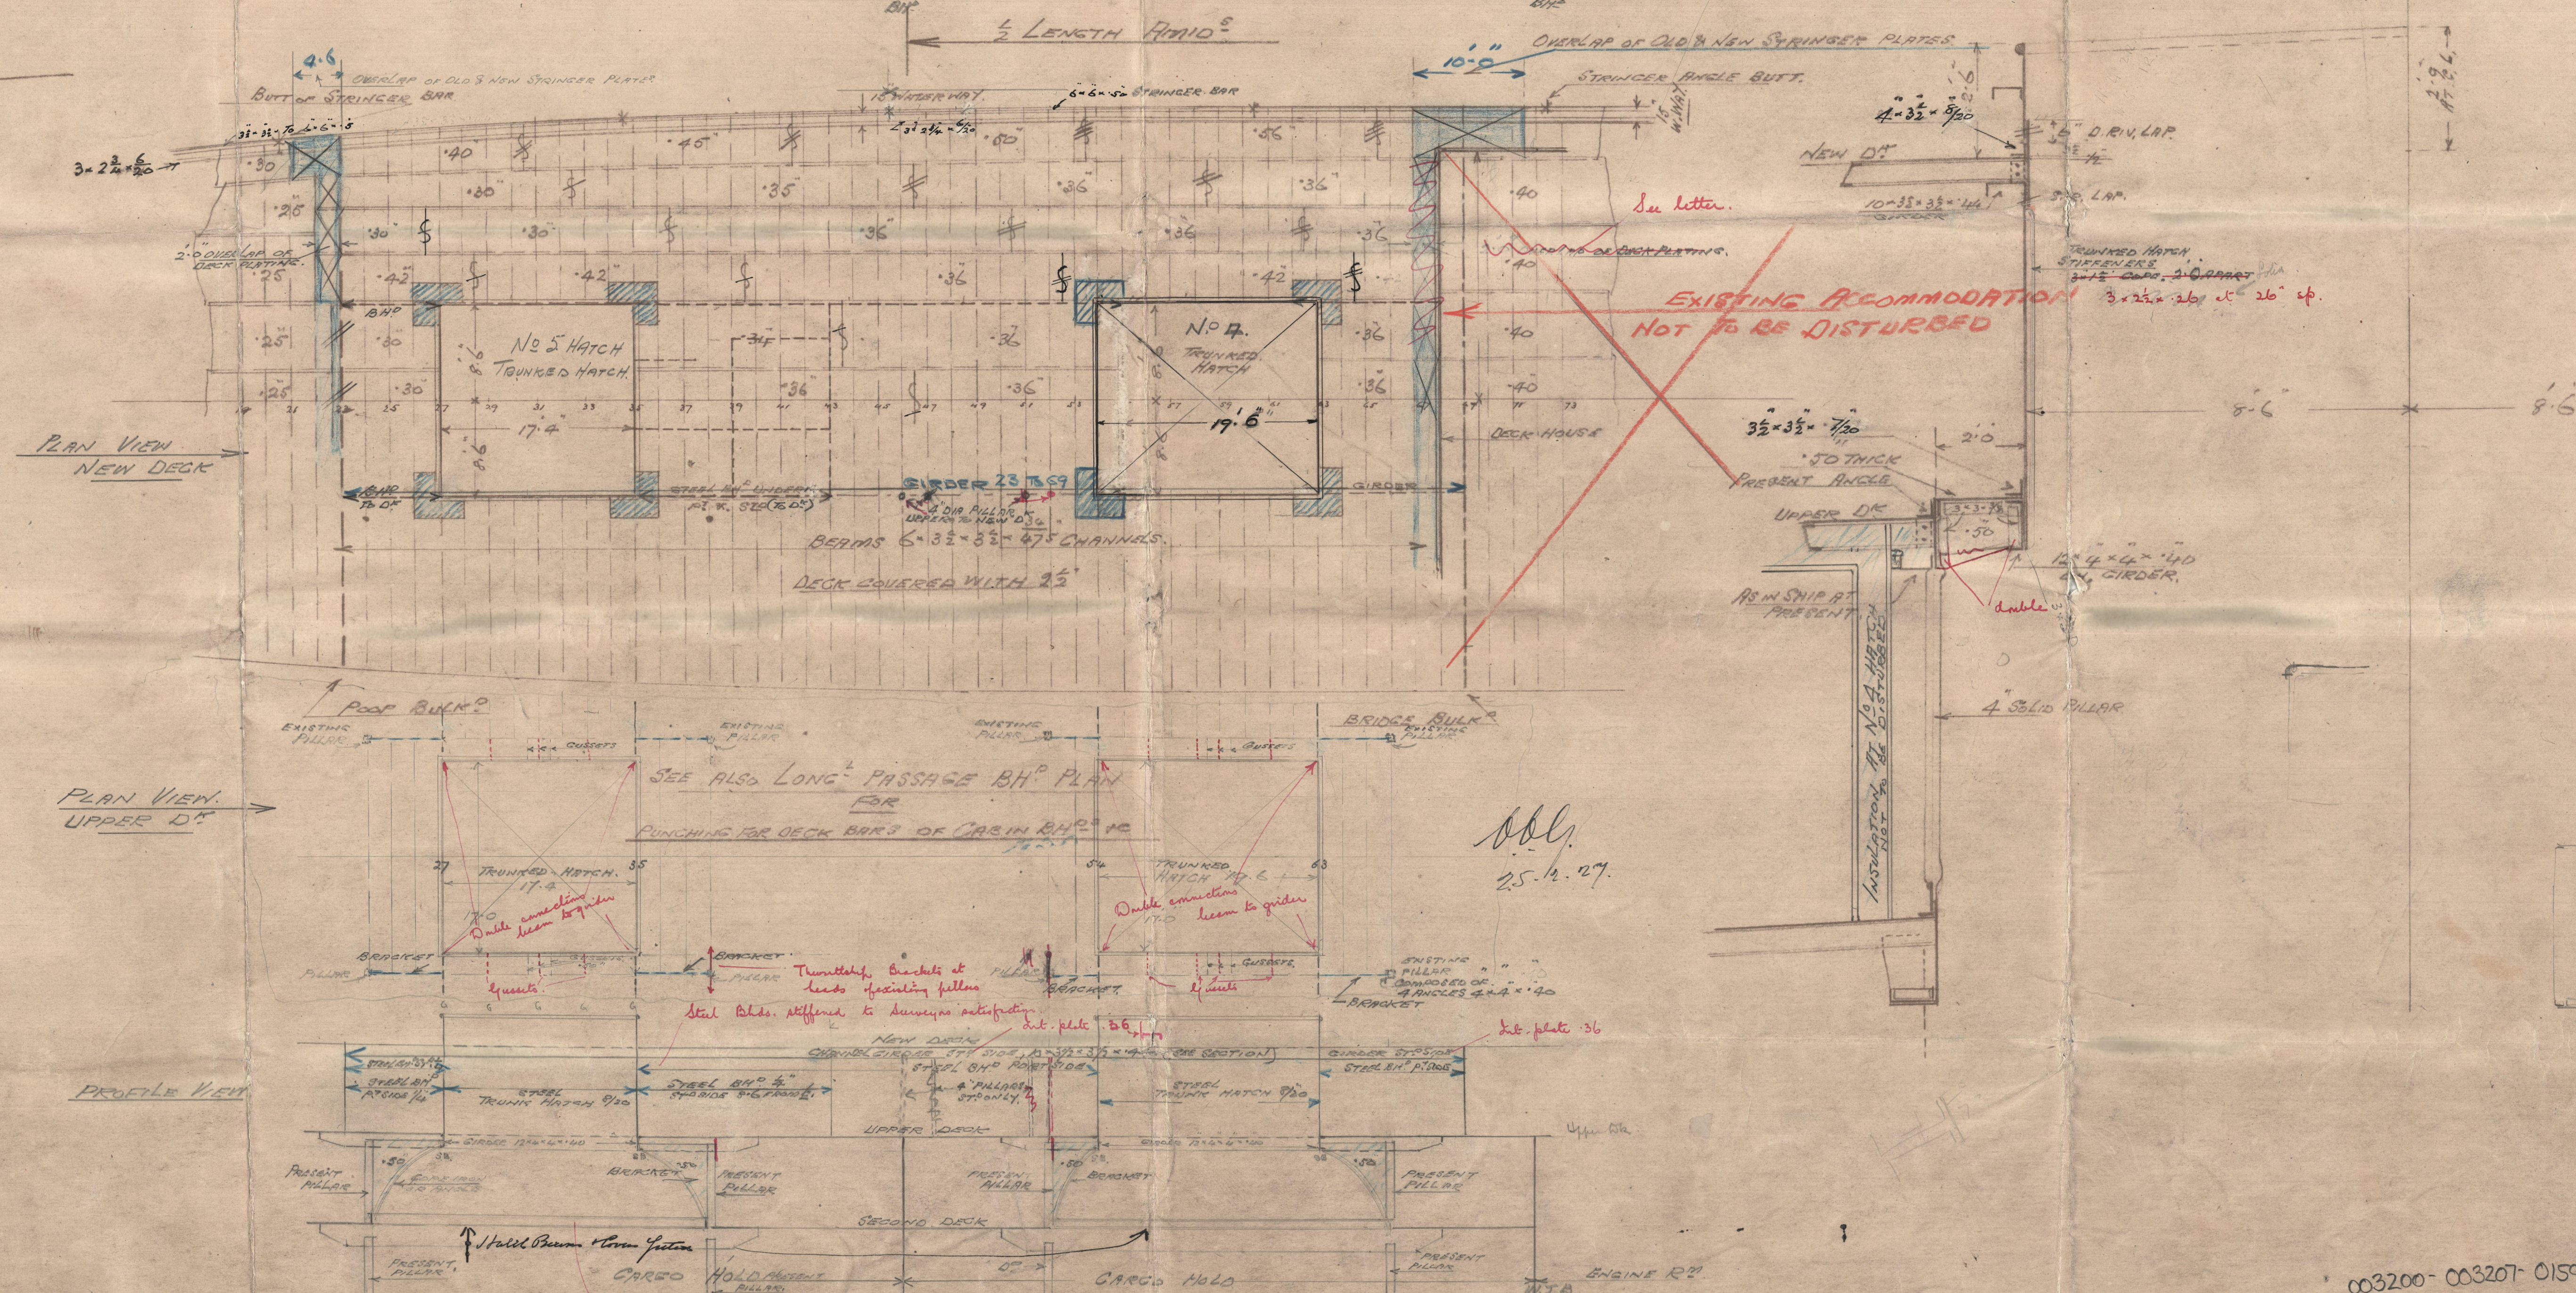

Note: Yrso hatch crans fitted at Upper Deck level, hatch crans ^{valleys} ^{girders} ^{up-rollers} beams } bolts strengthened at 2nd floor. Oct. 25. Para 12.

003200-003207-0159

Alterations

S. P. Canadian Permesles

Cammell Laird & Co.



Liverpool Rpt N^o 91832



© 2020

Lloyd's Register
Foundation

003200-003207-0159