

511 DEC 1948

## Lloyd's Register of Shipping.

Ship's Name

PARITA BAY

Official No. ✓

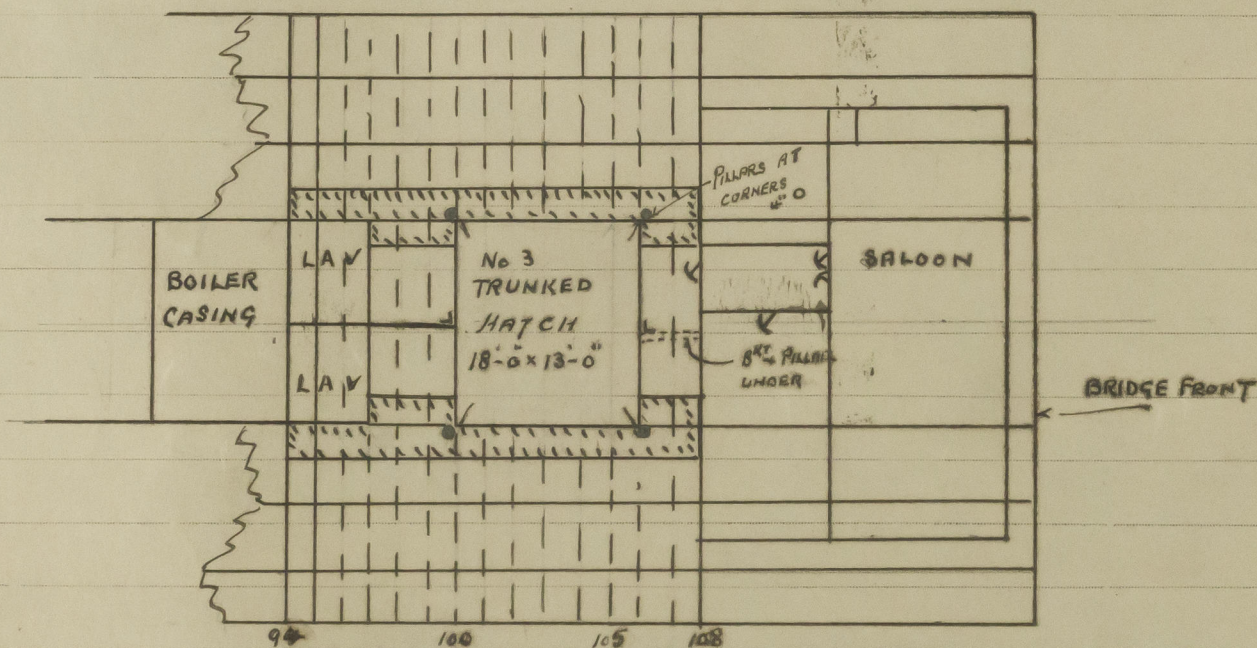
Memorandum of alterations reported since ship was surveyed for assignment of Load Lines  
in

Boat Deck:- 1<sup>st</sup> class lounge, house, wood deck, ties, & beams removed  
from frame 94 to 108.

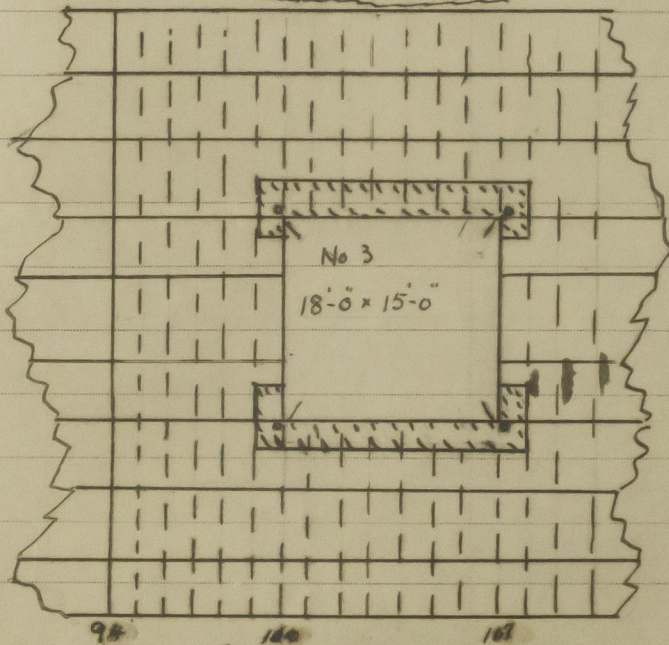
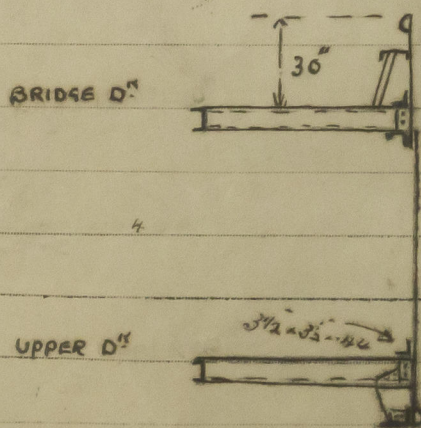
Bridge Deck:- Purser's office and deck house casings removed from  
frame 94 to 108, steel deck & beams cropped from frame  
100 to 108, and new hatchway constructed of steel plates  
and angles. (see sketch)

Upper Deck:- Steel deck & beams cropped in way of new hatchway.  
from frame 100 to 107, deck angle fitted to take trunk plating.

The Superintendent stated no cargo will be carried in trunk.  
BRIDGE DECK



UPPER DECK

BRIDGE D<sup>h</sup>

HEIGHT ABOVE DECK 30"

SIDES 4x4

ENDS 4x4

STIFFENERS 9x3 1/2 x 3 1/2 x 44 E

STAYS, ENDS 1, SIDES 1

2 BEAMS 4x8 x 3 1/2 x 44 ANGLES T-8

CURTS SPACED 24" APART

TRUNK PLATING 8S

STIFFENERS 8 1/2 x 2 SOLID HALF ROUND

SPACED 24" APART.

2 TARPULINS.

HATCH COVERS 3"

BEARING SURFACE 3"

COVERS FITTED

WITH END BANDS.

SPACED 4'-3"  
BEARING 3 1/2"