

MIDSHIP SECTION

N^o 510

CLASS 100 A1 STEAM TRAWLER

DIMENSIONS


LENGTH TWIST PERPS	120'-0" ✓	TRANSVERSE $H^{\circ} = 22.5 + 13 = 35.5$ ✓
BREADTH MOULDED	22'-6" ✓	LONGITUDINAL $H^{\circ} = 35.5 \times 120.0 = 4260$ ✓
DEPTH MOULDED	13'-0" ✓	
DEPTH TOP OF FLOOR TO DECK AT SIDE	11'-8" ✓	

$$\frac{L}{D} = 9.23 \quad \frac{L}{B} = 5.33$$

EQUIPMENT

ANCHOR		EX STOCK	5/4	90 FATHOMS	1 CHAIN
		EX STOCK	4 1/2	60	6 HAWSER
			2 1/2	60	4 1/2 WARP

ALEX^d HALL & Co., LTD.,
SHIPBUILDERS, ENGINEERS & BOILERMAKERS
ABERDEEN. 6/5/15.

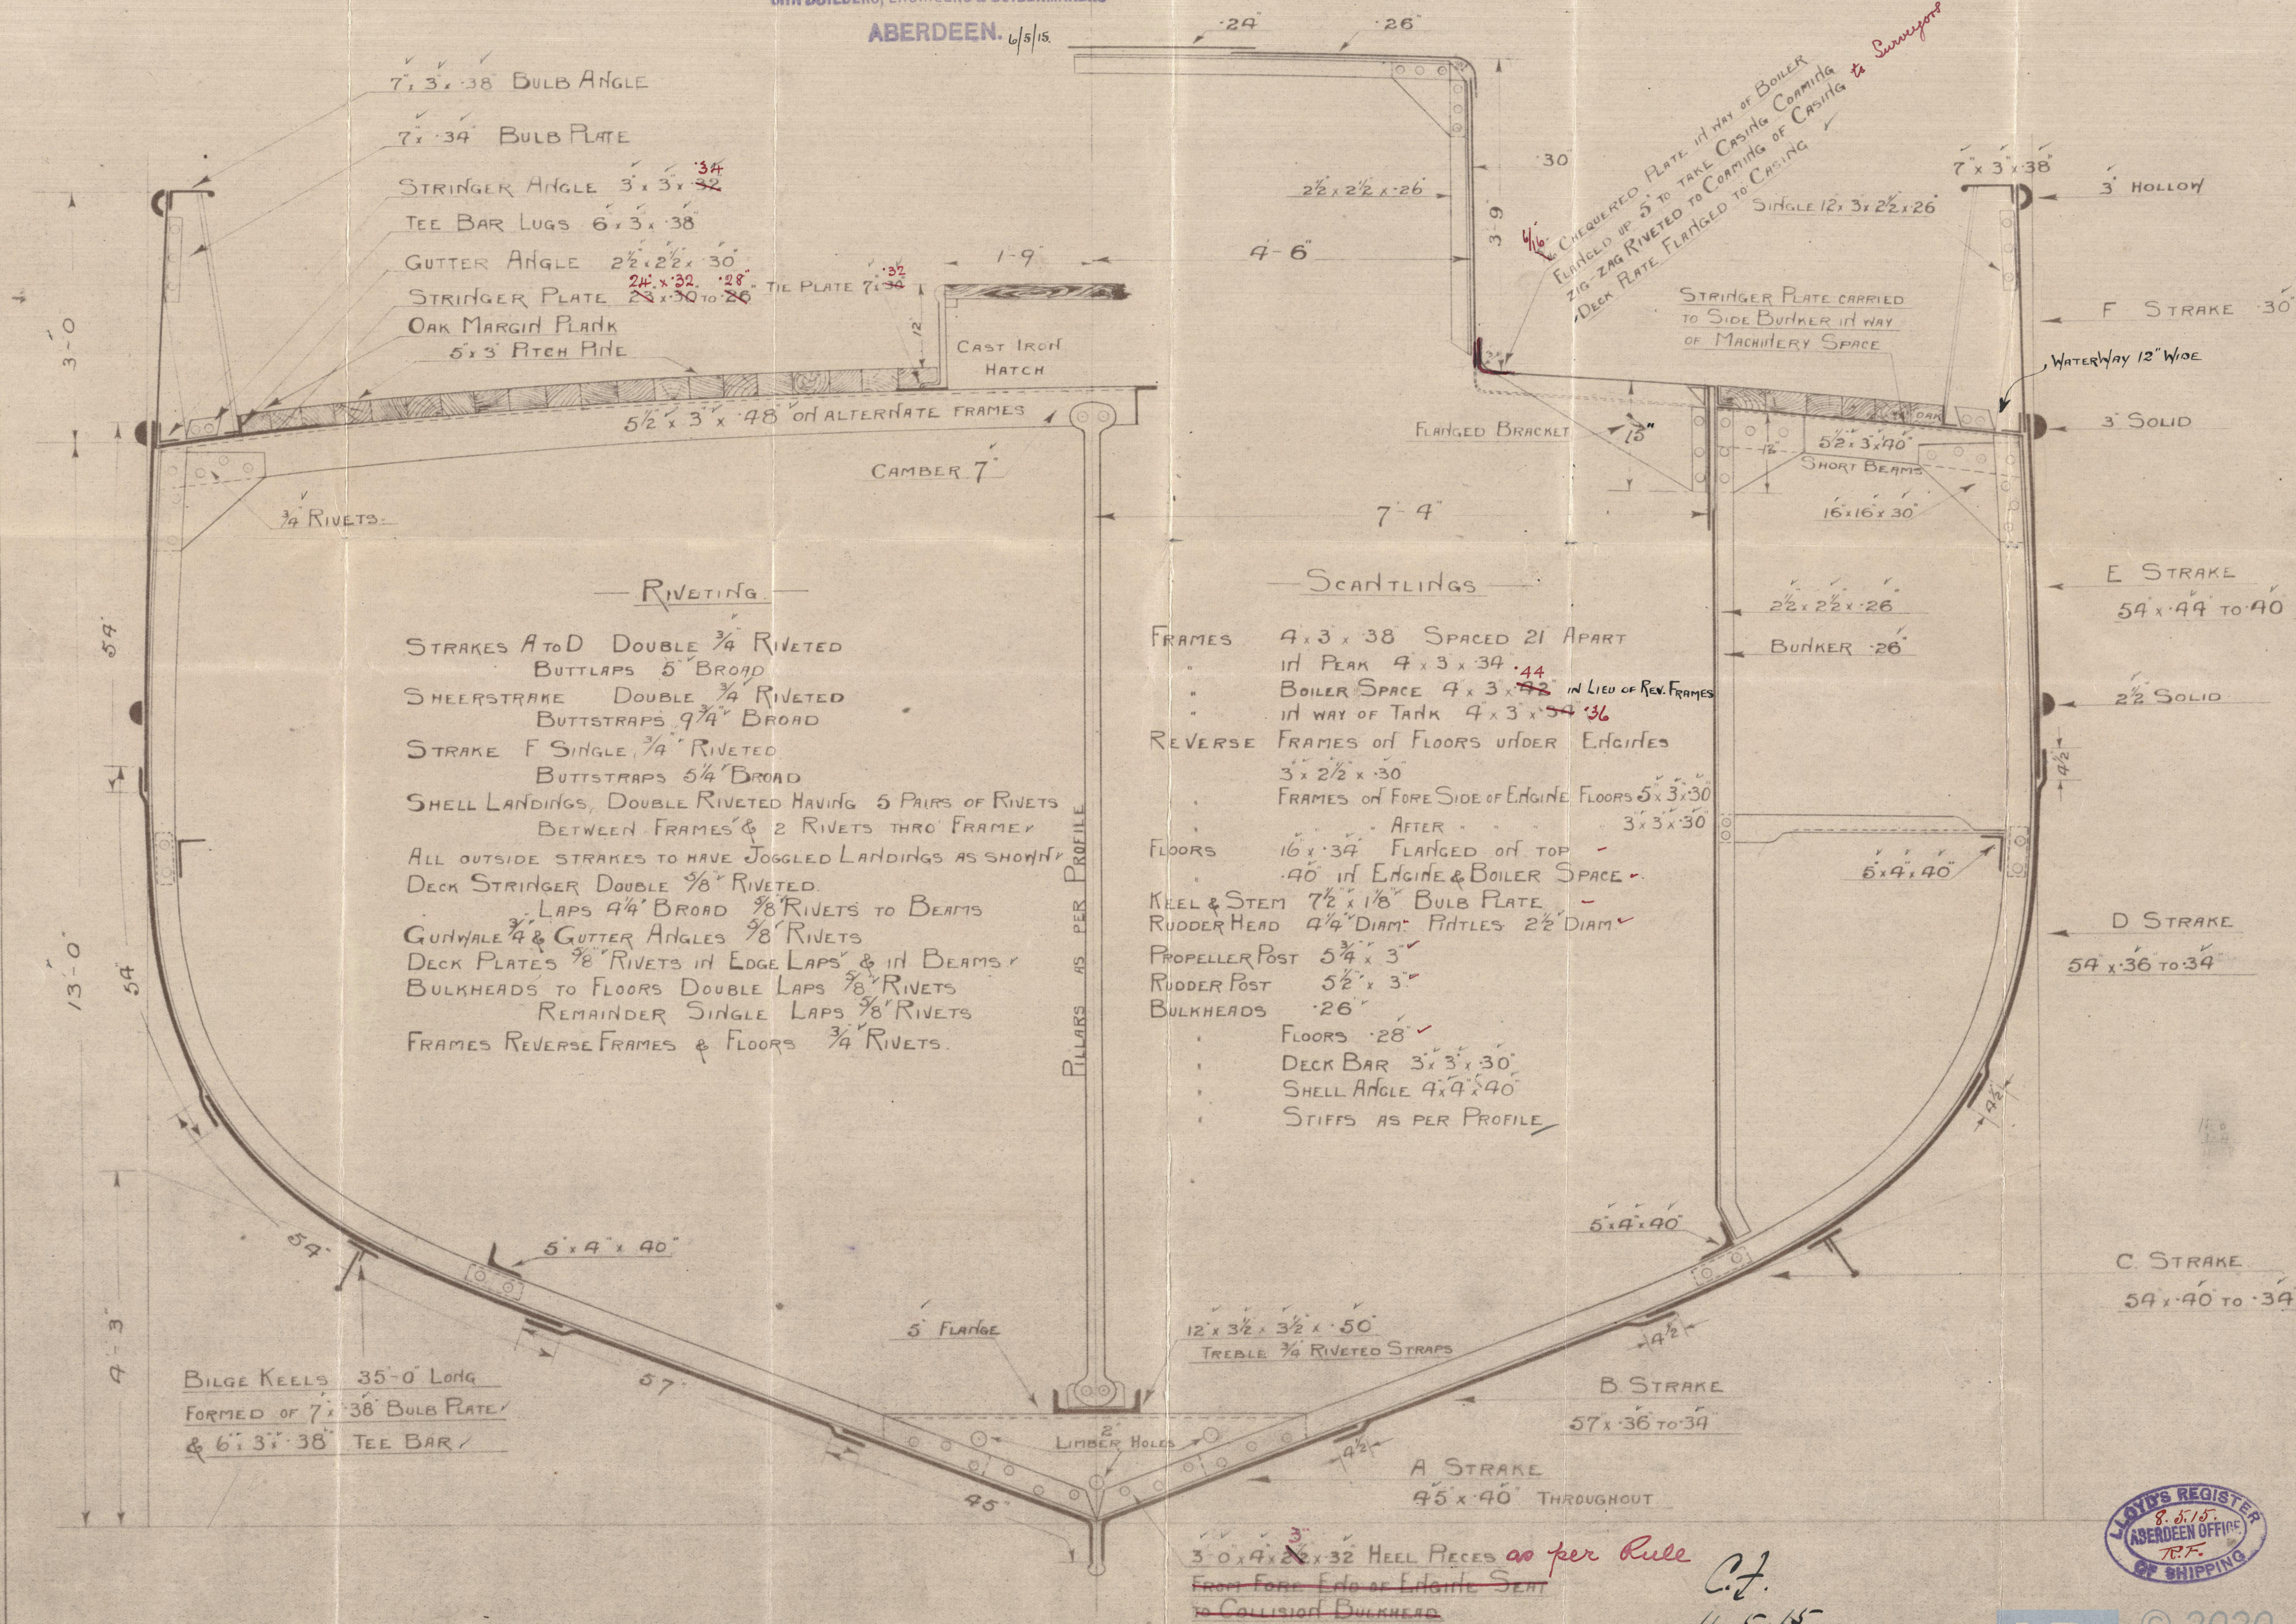

SCALE $\frac{3}{4}$ = ONE FOOT

N^o 510



Lloyd's Register
Foundation



A Hall & Co. Ltd.

Nº 510.

Midship Section

S.S. "Bracondine"

Abn rep. Nº 11811

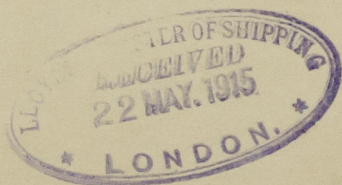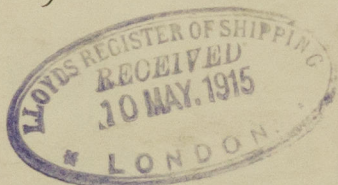

© 2020

Lloyd's Register
Foundation

Midship

003208-003216-0017