

STERN AND RUDDER FRAMES

YARD N° 510

BOTH FORGINGS. LONGITUDINAL N° 4260

AREA OF RUDDER = 38.75. C.G. = 179

A x D = 69.36

SPEED UNDER 10 KNOTS


SCALE 1" = ONE FOOT

ALEX. HALL & Co., LTD.
SHIPBUILDERS, ENGINEERS & BOILERMAKERS
ABERDEEN. 11/5/15



RISET HOLES 1/16 DIA
SPACED 5" CTR TO C

No Rivet Holes
THRU BOSS
Not to be less than
1 1/8"

No Rivet Holes
THRU SCARP

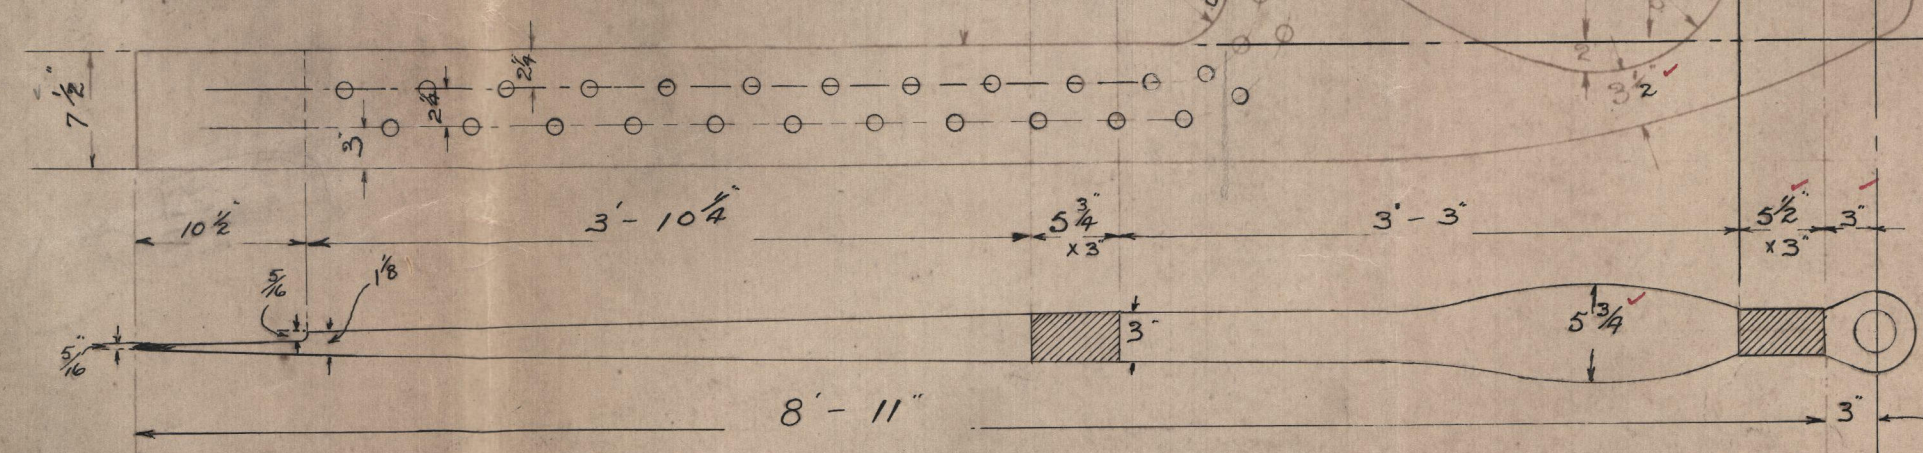

N° 510.

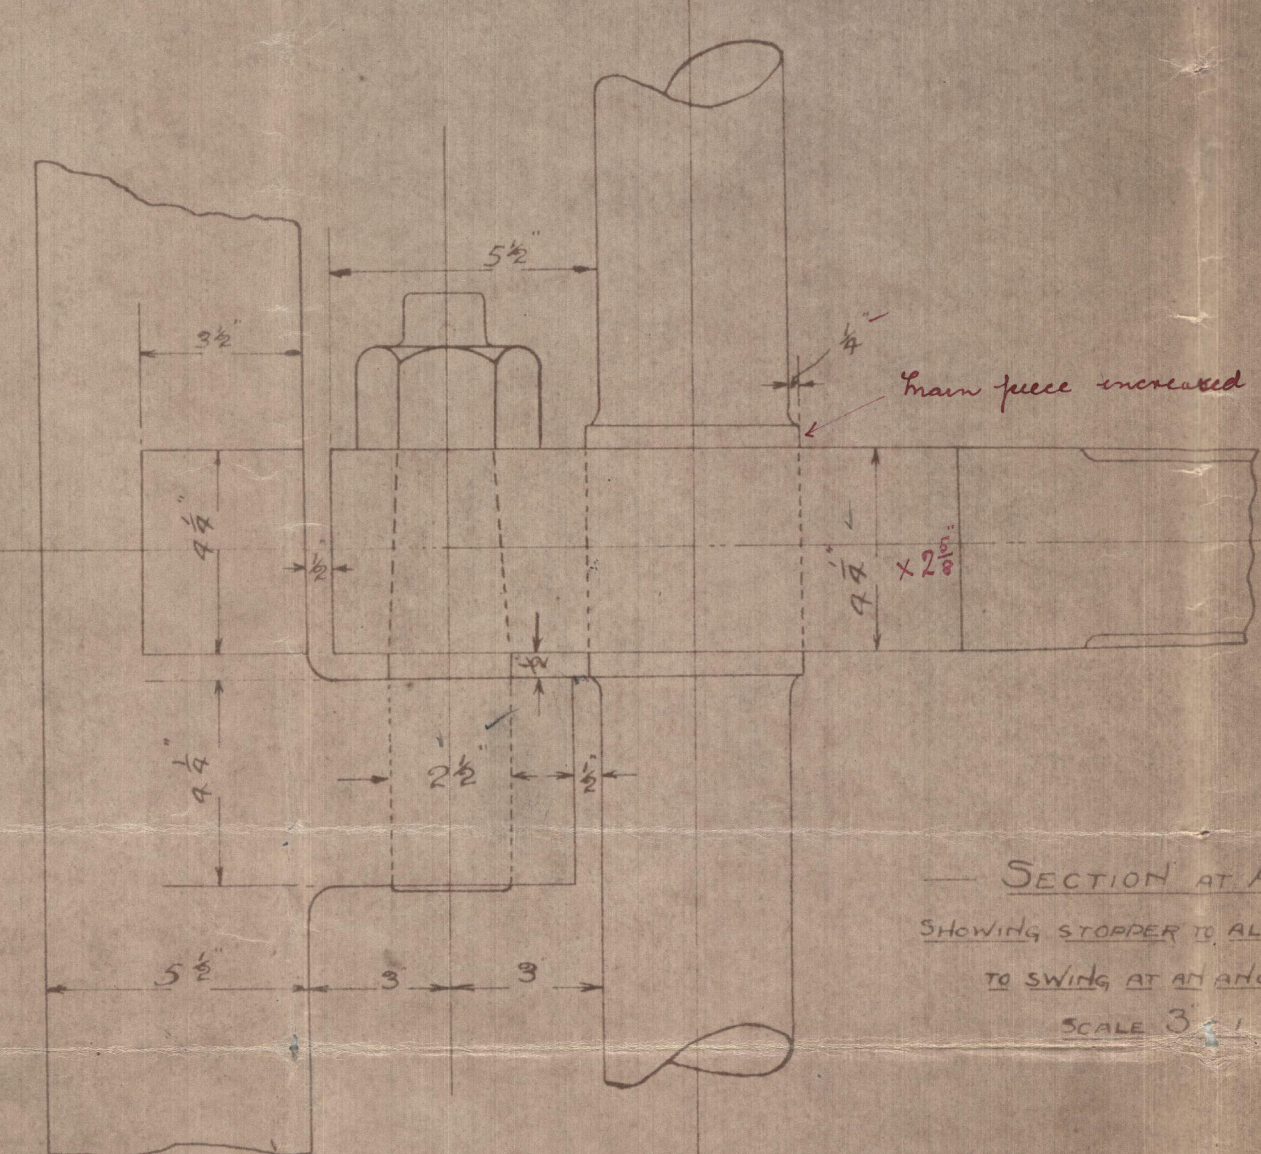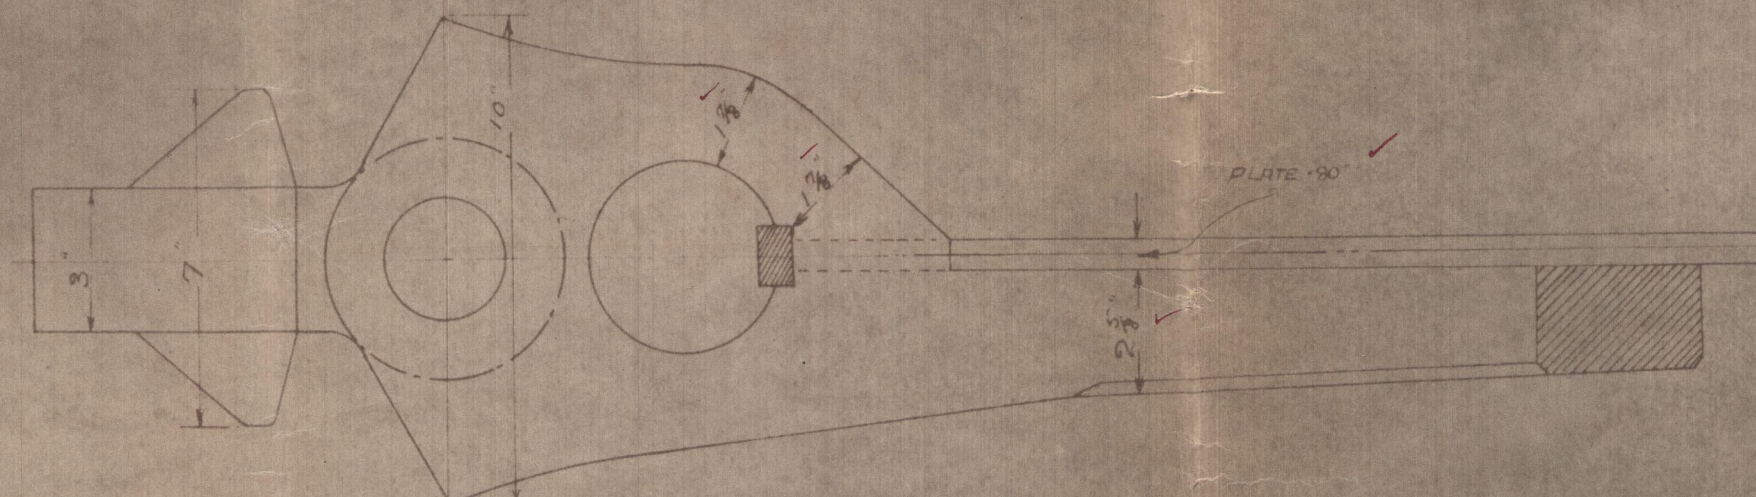

SECTION AT AB
SHOWING STOPPER IS ALLOW RUDDER
TO SWING AT AN ANGLE OF 43°
SCALE 3" = 1 FOOT

RISET HOLES 1/16 DIA
SPACED 4 1/4" CTR TO C COUNTERSINK ON
OUTSIDE 1/2" DEEP

C.F.
11.5.15




A Hall & Co. Ltd.

N^o 510.

Stern & Rudder frames.

S.S. "Bracondene"

Abstract N^o 11811.

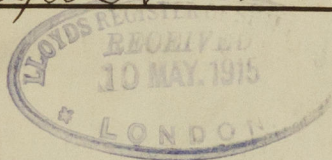

S & R. frames.



© 2020

Lloyd's Register
Foundation

003208-003216-0018