

Masts supported to Surveyors satisfaction.

CREW SPACE

Pillared to Surveyors Satisfaction

LONGITUDINAL SECTION

ALEX. HALL & CO. LTD.,
SHIPBUILDERS, ENGINEERS & BOILERMAKERS
ABERDEEN. 6/5/15

N^o 510

SCALE $\frac{1}{4}$ " = ONE FOOT

Cf.
11.5.15






A Hall & Co. Ltd.

No. 510.

Profile

S.S. "Bracondene"

Abn rep. No. 11811.

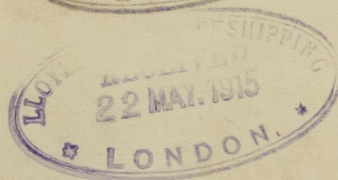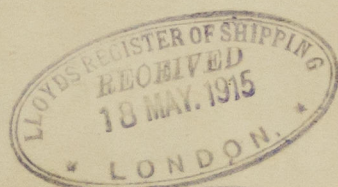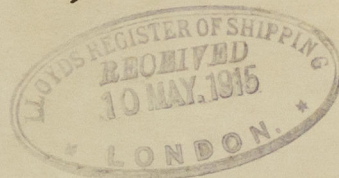

Profile



© 2020

Lloyd's Register
Foundation

003208-003216-0019