
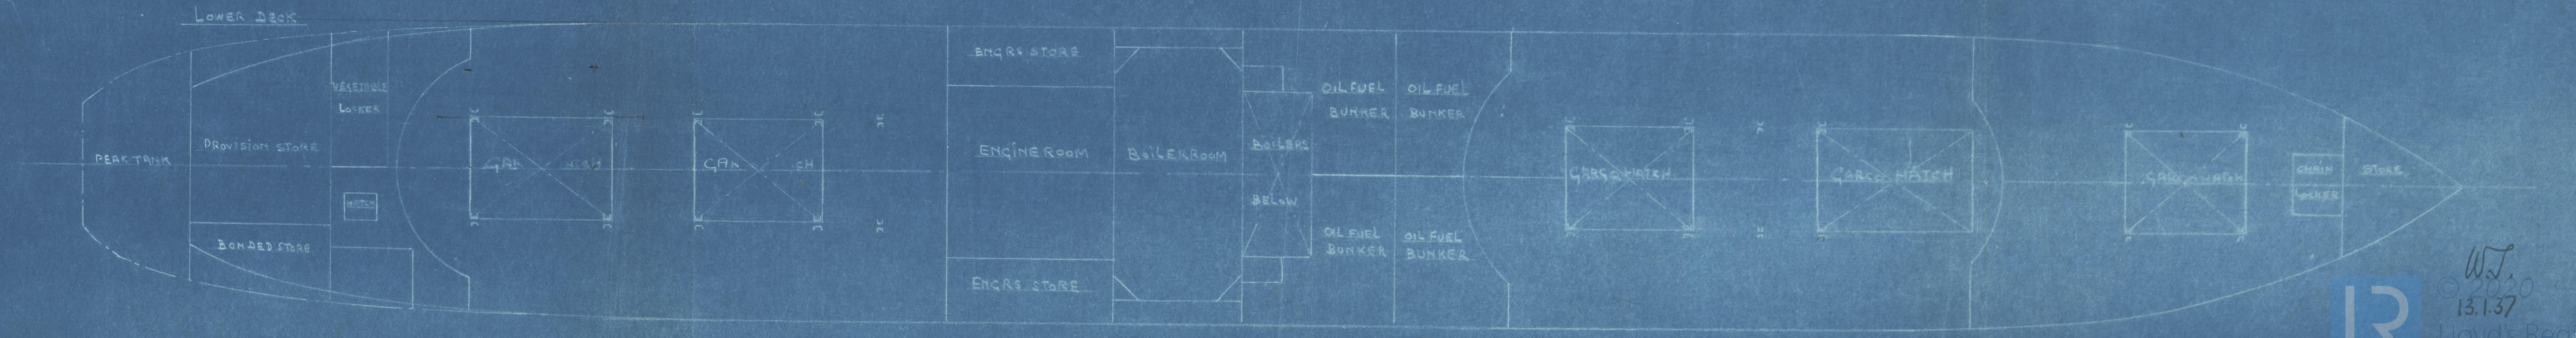
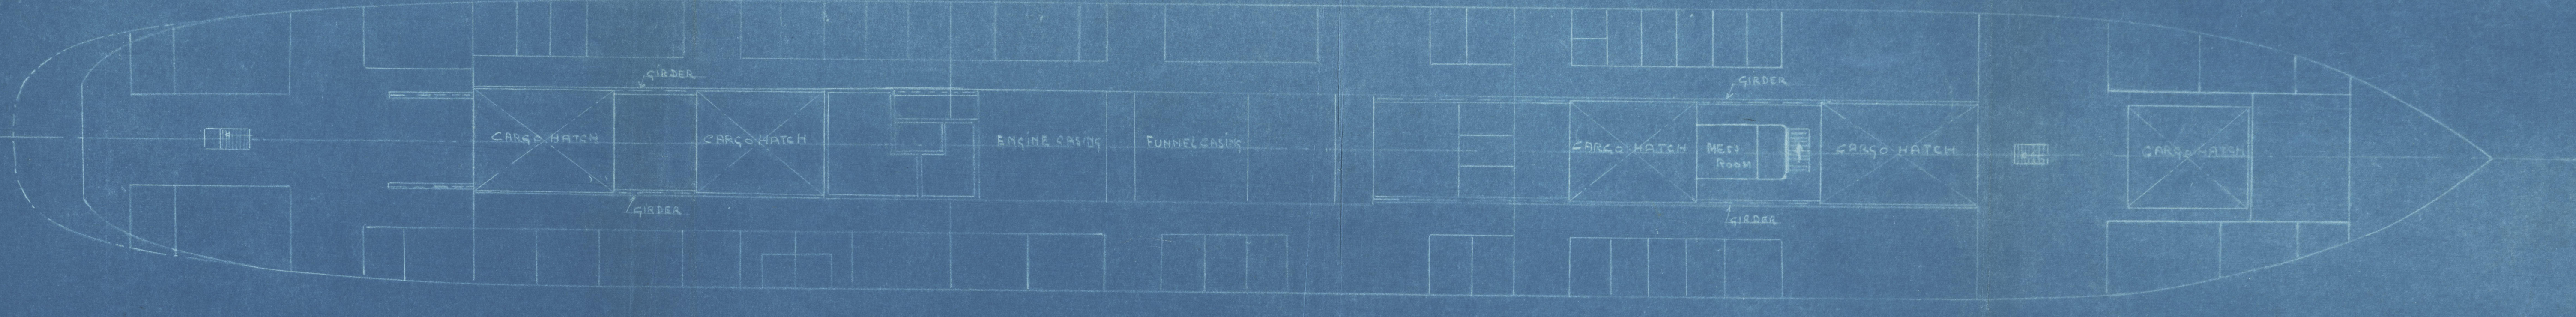
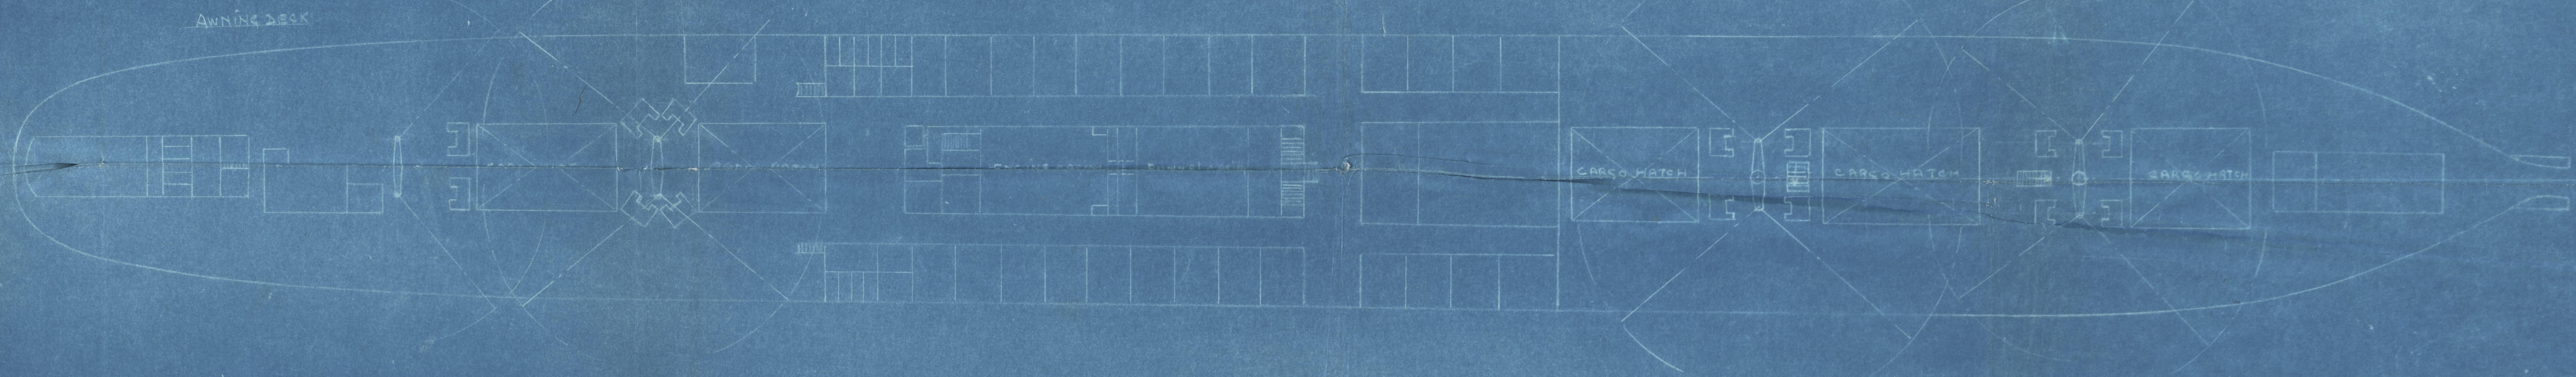


# — T.S.C.S. "DOMINIA" —

DIMENSIONS - 509'-7" OVERALL 478'-0" PP x 58'-0" BECK x 46'-9" D M<sup>2</sup> L<sup>2</sup> To AWNING DECK.  
 SCALE 1/16" = 1 FOOT  
 11/192

*off*

*Arrangement size of  
 hulling to be submitted  
 to the authorities  
 to be submitted*

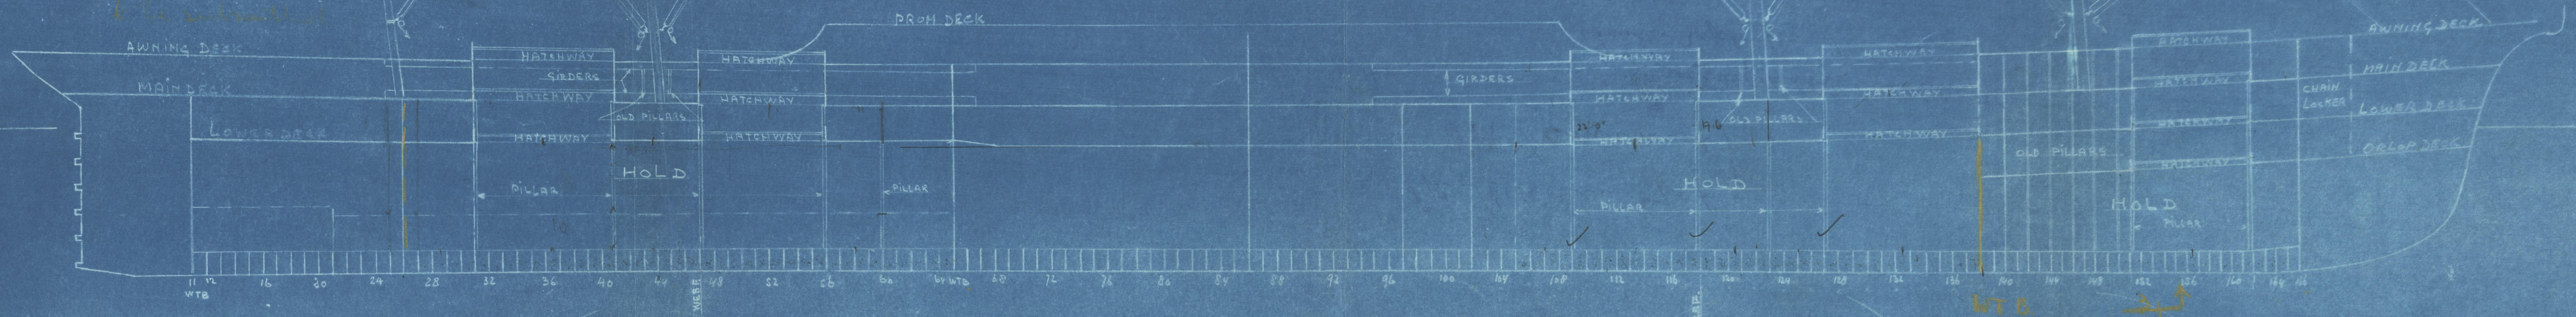



Mr. Nikolai Eiof  
ex  
(Dominia)

См. индекс № 14024.  
Ans. rept. No. 14024.



© 2020

Lloyd's Register  
Foundation

001016-82200-003208