
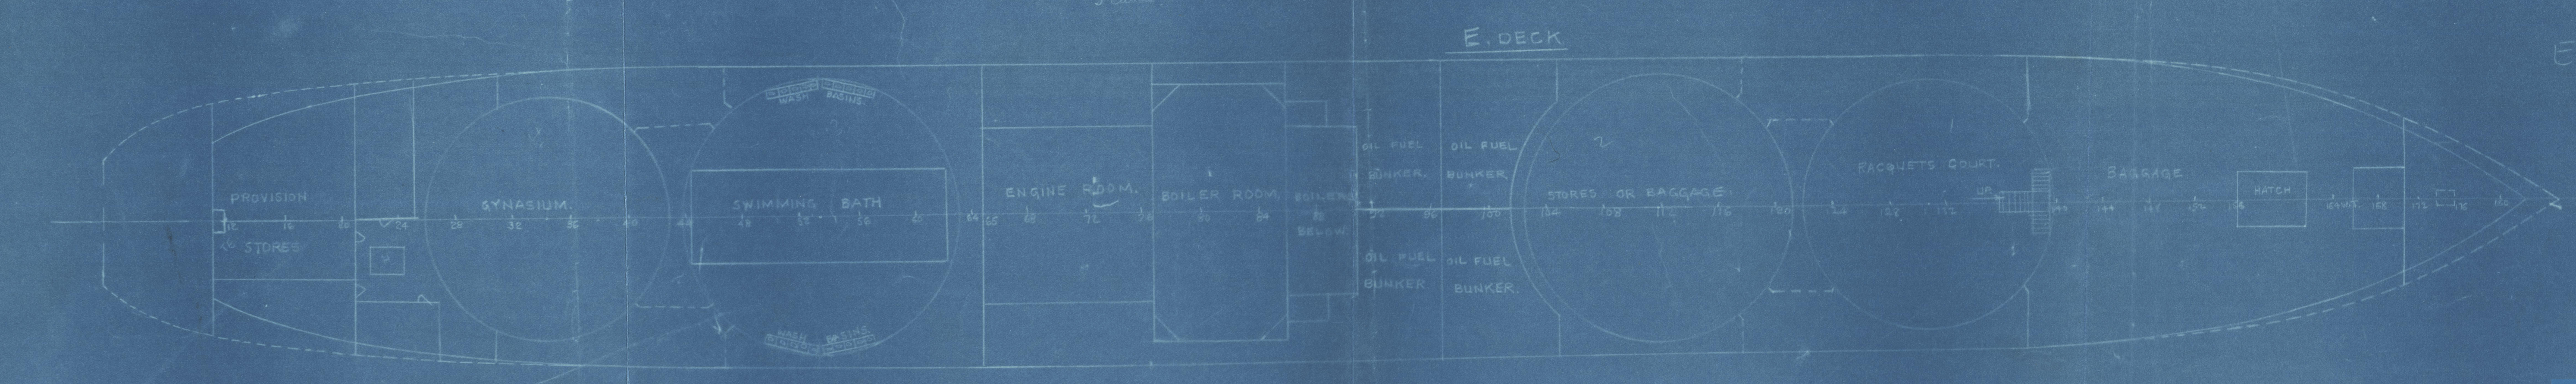
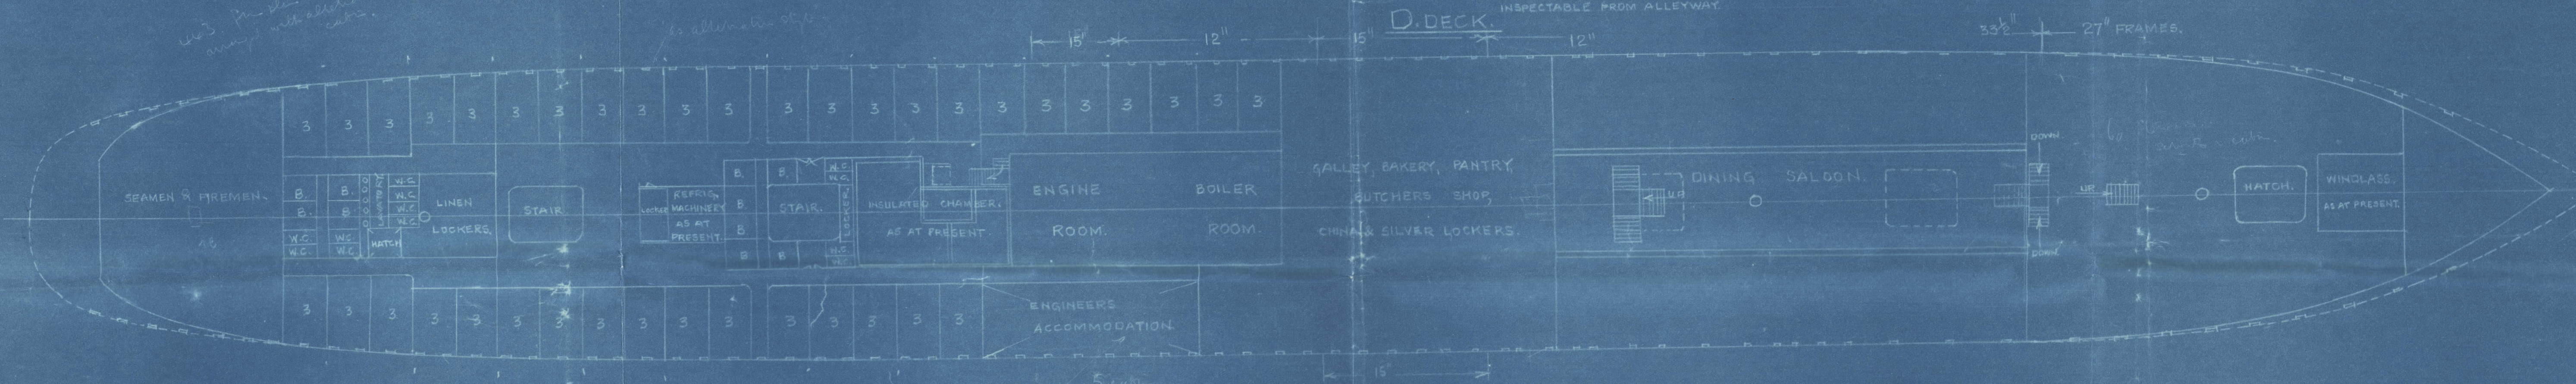
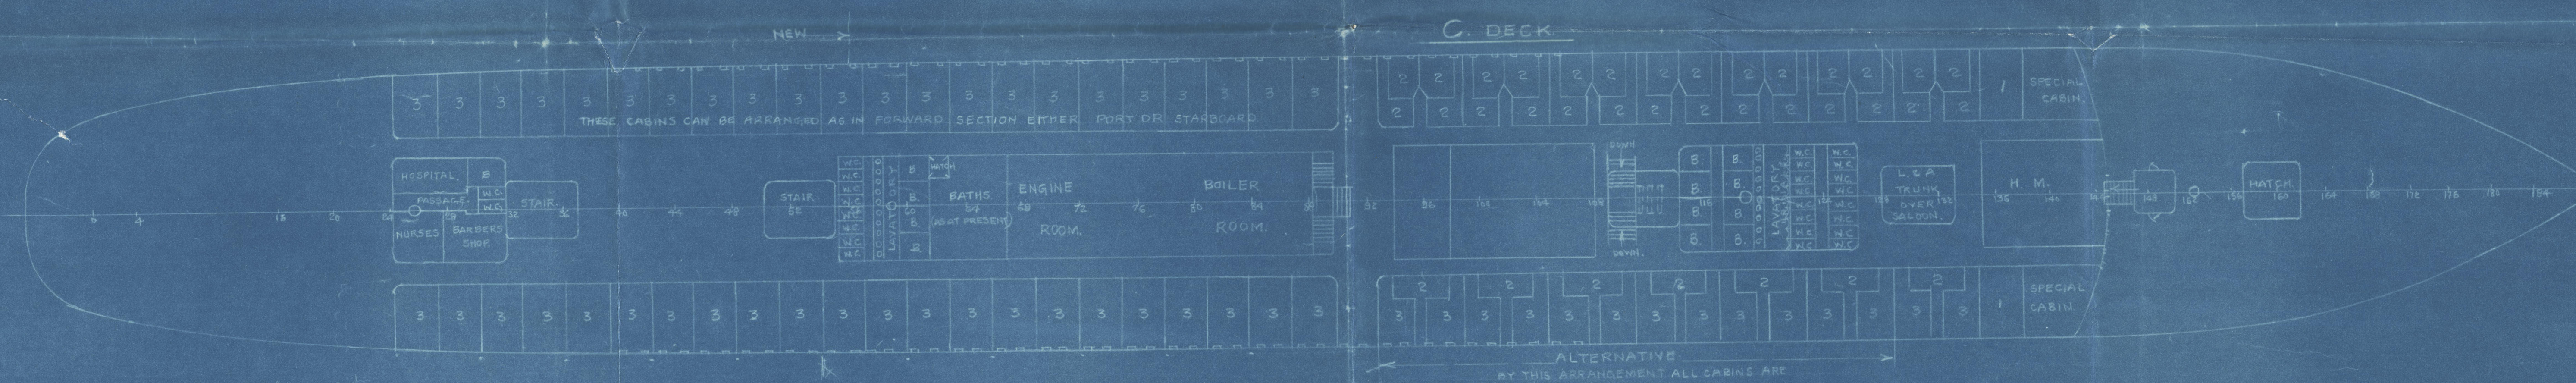
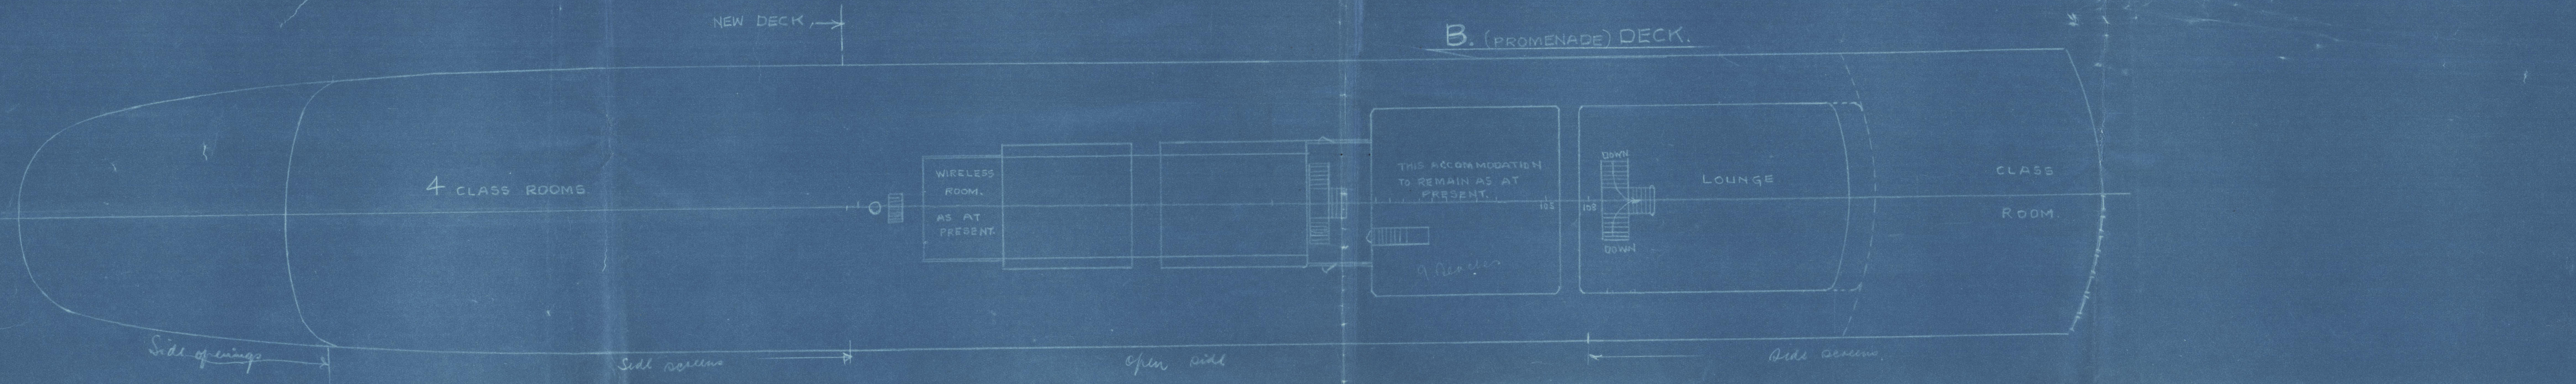
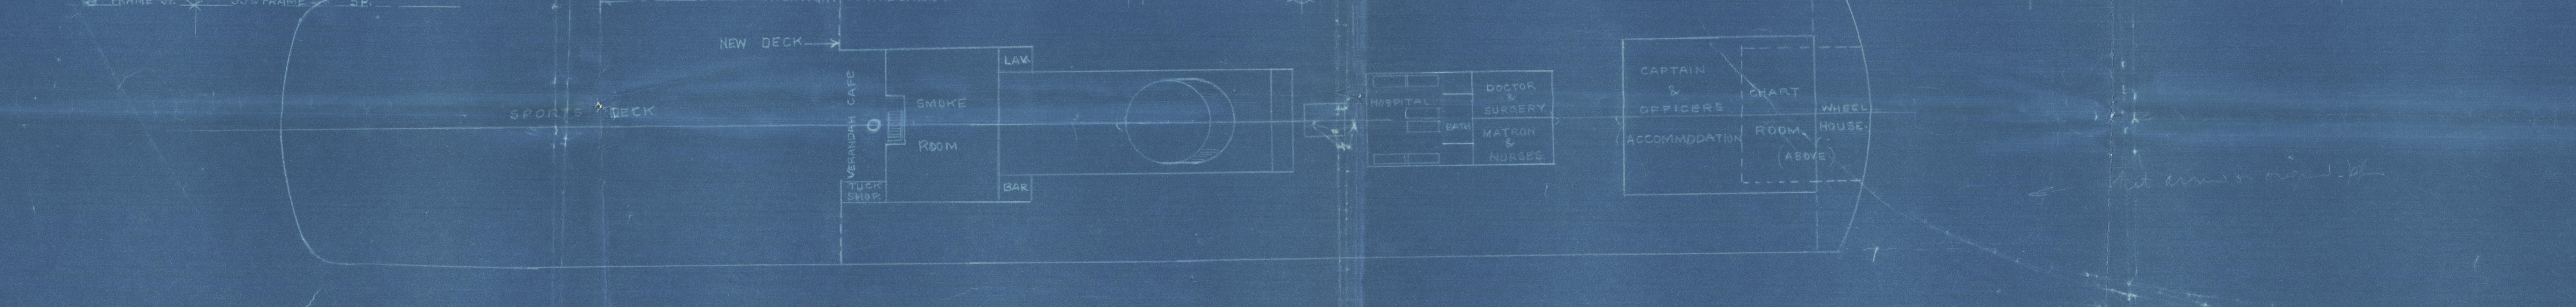


SS Dominia
Scale 1/16" = 1 foot.

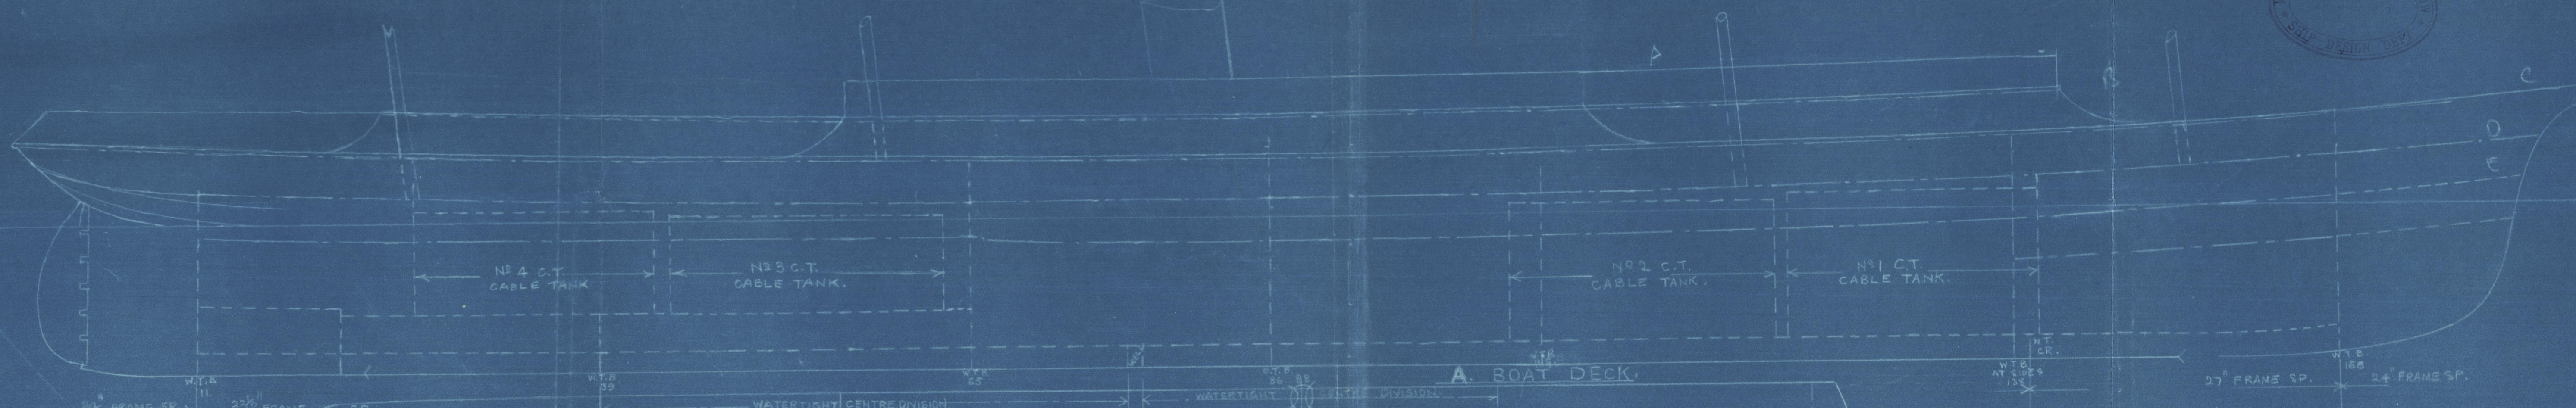

S. P. Nikolai Ef. (ex)
Domina

Proposed. Modified
General Arrangement.

Ans. Sept. 116.
14024.

© 2020

003208-003216-9/11

Lloyd's Register
Foundation