

MIDSHIP SECTION, S.S. N<sup>o</sup>. 103.

— DIMENSIONS. —


LENGTH B.P.	303' 0"
BREADTH MOULDED	42' 11½"
DEPTH	22' 4½"

— CLASS: COA 1. —

## EQUIPMENT

2 BOWER ANCHORS	4 1/2 TONS	STOCKLESS
1 "	3 1/2 "	"
1 STEER	1 1/2 "	EX. STOCK
1 WEDGE	1 1/2 "	"
STUD CHAIN CABLE	2 1/2 TONS	1 1/2 "
STEER CHAIN	75 "	1 3/4 OR 1 1/2 STEEL WIRE
TOWLINE	100 "	12 HEMP OR 1 1/2 "
2 HANSEYS	90 "	"
2 NORPS	90 "	6 "

Kedge not now Regd.

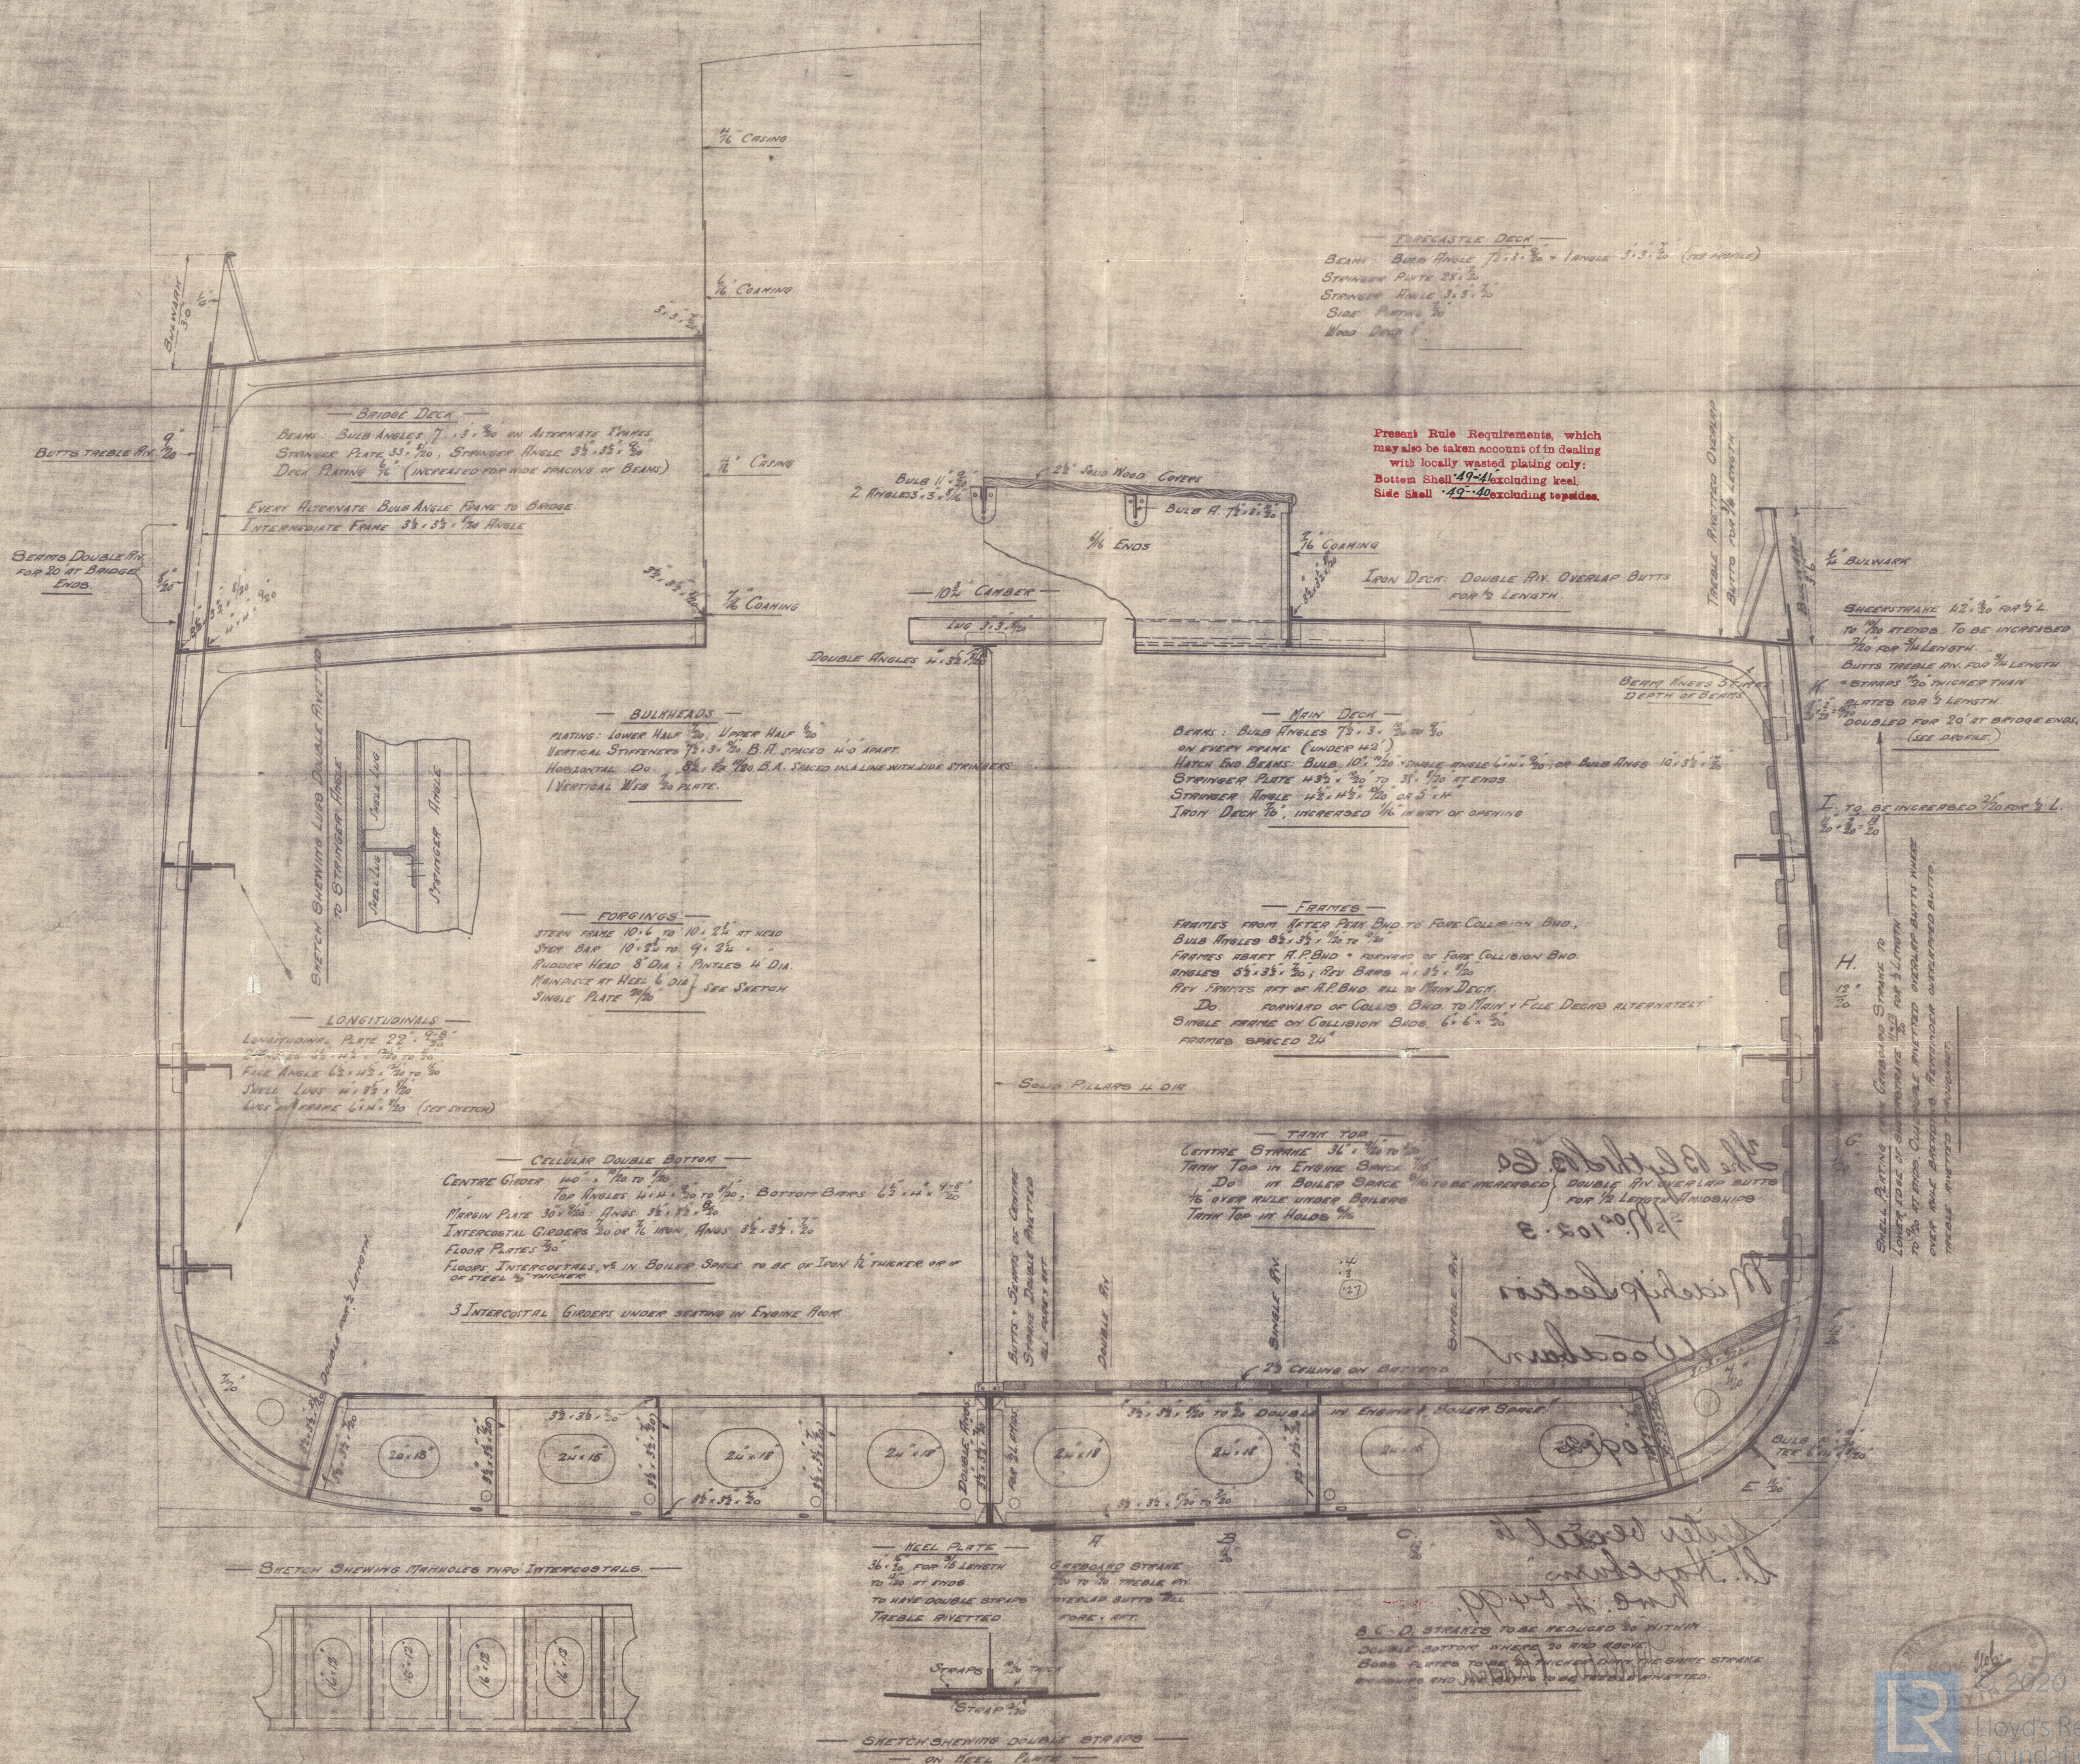



- HULDA THORDEN  
Midship Section

Sk. 4992.



© 2020

Lloyd's Register  
Foundation

003208-003216-0171