


— LOWE'S NUMERALS —

1/2 BREADTH ----- 21.48  
DEPTH ----- 23.24  
1/2 GIRTH ----- 41.16  
----- 85.91 FRAME 174  
LENGTH ----- 301.63  
----- 258.61 PLATING 174  
ADD FOR ERECTIONS : ----- 14.60  
----- 543.81 EQUIPMENT 174

DEPTH TO LENGTH : 12.94

— DIMENSIONS. —  
 LENGTH B. P. .... 303' 0"  
 BREADTH MOULDED .... 42. 11½  
 DEPTH " ..... 22. 4½  
 — CLASS: 100 A1. —

<u>EQUIPMENT</u>		

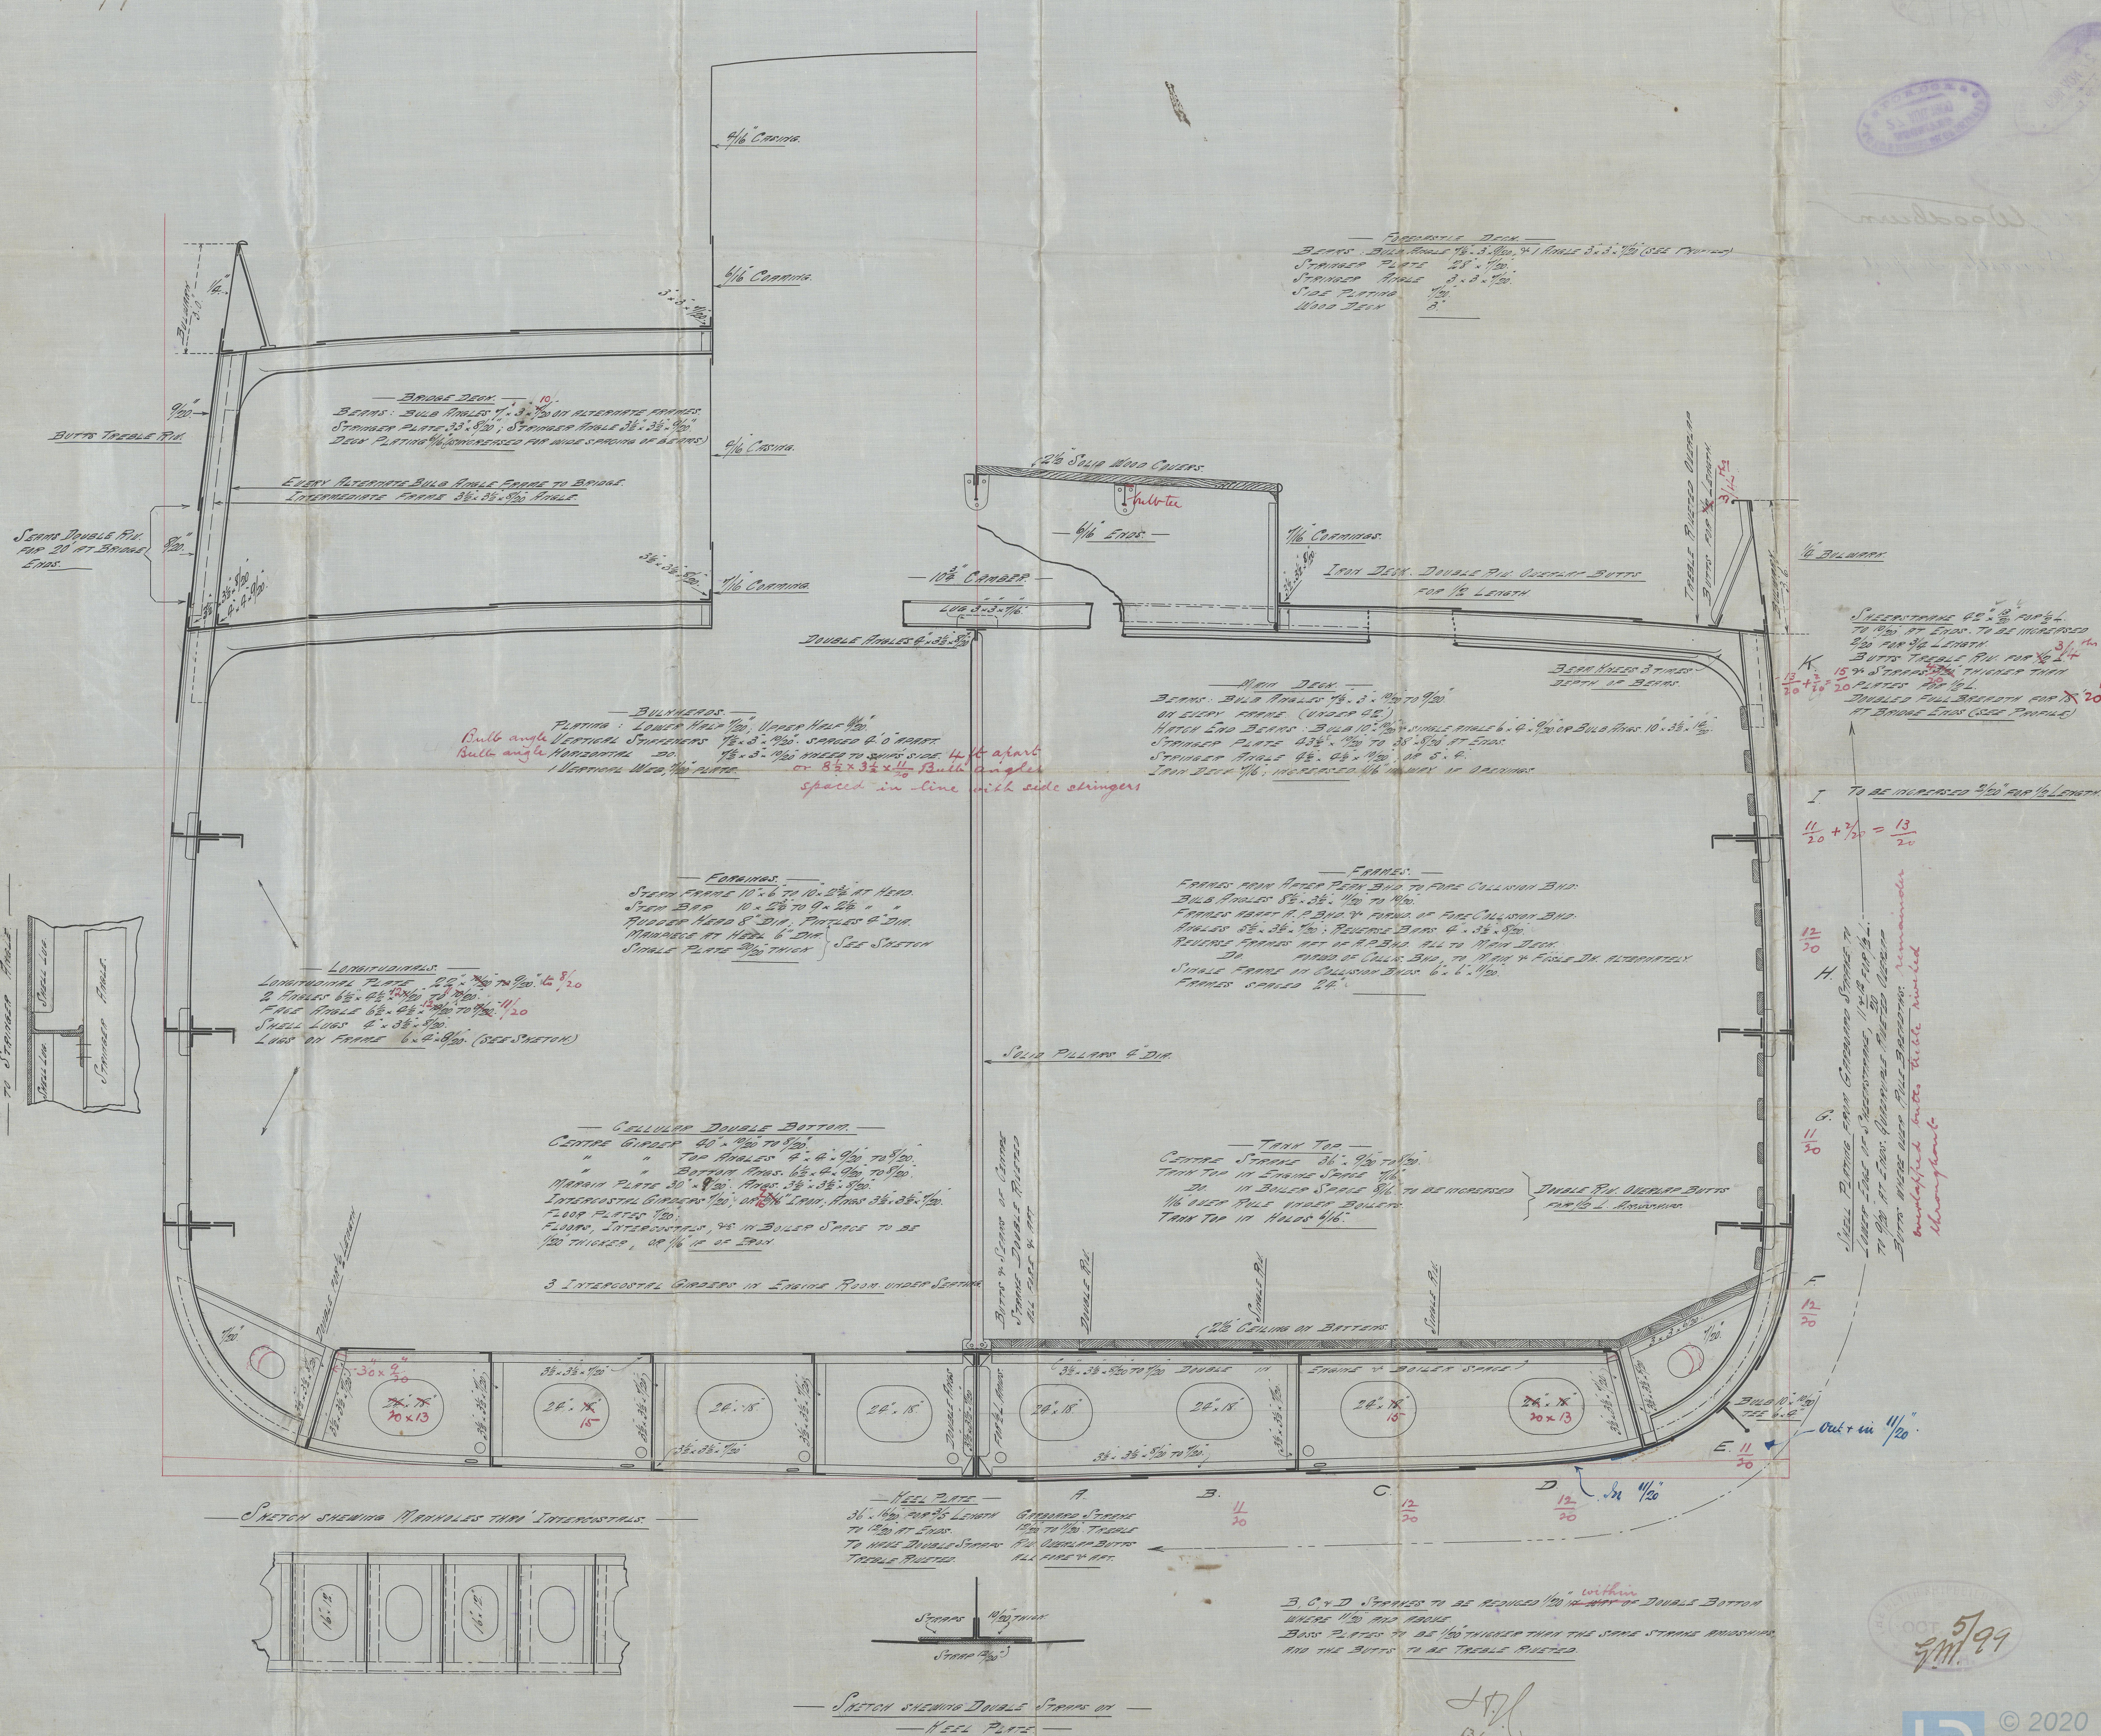



Blyde S. B. Co?




S. S. H<sup>o</sup> 102-3

Friendship Section

5/8 Hartburn

Nov. 40499.

TURID

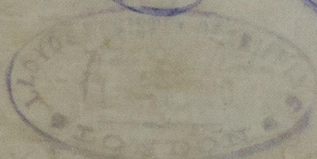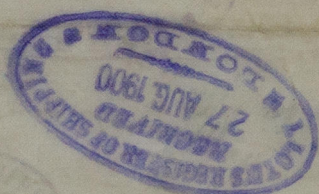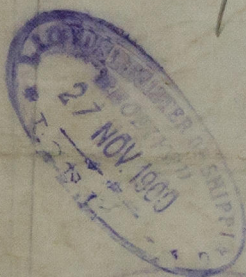

J. J. Woodburn

Newcastle Report

5/8



© 2020

Lloyd's Register  
Foundation

003208-003216-0172